

Chariton Valley Telephone Corporation
Name of Issuing Corporation

For All Missouri Exchanges
Community, Town or City

Section No. 1

LOCAL EXCHANGE SERVICE TARIFFS

RECEIVED

NOV 13 1963

MISSOURI
Public Service Comm.

TABLE OF CONTENTS

Sheet No.

Title Page	A
Table of Contents	B
Subject Index	C
Local Exchange Service Tariffs	D-E
Local Exchange Boundary Maps	3 +
Local Urban Base Rate Area Maps	4 +

~~CANCELLED~~

~~APR 7 2007~~

~~Public Service Commission
MISSOURI~~

FILED

DEC 15 1963

PUBLIC SERVICE COMMISSION

* Indicates new rate or text
+ Indicates change

DATE OF ISSUE November 12, 1963
month day year

DATE EFFECTIVE December 15, 1963
month day year

ISSUED BY T. L. Selmon General Manager
name of officer title

Bucklin, Missouri
address

T. L. Selmon

CANCELLED
February 23, 2009
Missouri Public
Service Commission
YI-2009-0537

Chariton Valley Telephone Corp.

**P.S.C. Mo. No.1 Consolidated
4th Revised Sheet No. C
Cancels 3rd Revised Sheet No. C
For All Missouri Exchanges
Section I**

LOCAL EXCHANGE SERVICE TARIFFS

Subject Index

	<u>Sheet No.</u>	
Local Service Rates	D	
Tax Statement	E	
Customer Provided Equipment	F	
Exchange Calling Scope	G	(T)
Exchange Area Maps, each exchange	3	
Base Rate Area Maps, each exchange	4	

Issued: May 22, 2012

James Simon
General Manager
Macon, MO 63552

Effective: July 1, 2012

CANCELLED
June 11, 2016
Missouri Public
Service Commission
JI-2016-0317

FILED
Missouri Public
Service Commission
JI-2012-0759

FORM NO. 13 P.S.C.MO. No. 1 Consolidated 3rd ~~Original~~ SHEET No. C
 Cancelling P.S.C.MO. No. 1 Consolidated 2nd ~~Original~~ SHEET No. C
 Chariton Valley Telephone Corp. For All Missouri Exchanges
 Name of Issuing Corporation Community, Town or City
 Section I

LOCAL EXCHANGE SERVICE TARIFFS		DEC 1 1987
Subject Index		MISSOURI
	Sheet No.	Service Commission
Local Service Rates		D
Tax Statement		E
Customer Provided Equipment		F
Movement of Exchanges Between Rate Group		G
Exchange Area Maps, each exchange		3
Base Rate Area Maps, each exchange		4

PAID

JAN 01 1988

Public Service Commission

*Indicates new rate or text
 +Indicates change

DATE OF ISSUE DEC 18 1987 DATE EFFECTIVE January 1, 1988
month day year month day year
 ISSUED BY Robert E. Wright General Manager Bucklin, Mo. 64631
name of officer title address

~~Original~~
Revised
~~Original~~
Revised

Chariton Valley Telephone Corporation
Name of Issuing Corporation

For All Missouri Exchanges
Community, Town or City

Section No. 1

LOCAL EXCHANGE SERVICE TARIFFS

SUBJECT INDEX

Sheet No.

Local Urban Rates	D
Local Rural Rates	E
Local Urban Base Rate Area Map	4 ÷
Local Rural Exchange Boundary Map	3 ÷

NOV 13 1963
MISSOURI
Public Service Comm.

CANCELLED
JAN 01 1988
BY 3rd B.S.C.
PUBLIC SERVICE COMMISSION
OF MISSOURI

FILED

DEC 15 1963

PUBLIC SERVICE COMMISSION

* Indicates new rate or text
+ Indicates change

DATE OF ISSUE November 12, 1963
month day year

DATE EFFECTIVE December 15, 1963
month day year

ISSUED BY T. L. Selmon
name of officer

General Manager
title
Bucklin, Missouri
address

Chariton Valley Telephone Corporation

P.S.C. MO. NO. 1 Consolidated
1st Revised Sheet No. C.1
Cancelling Original Sheet No. C.1

Section I

LOCAL EXCHANGE SERVICE TARIFFS

Held for Future Use

(C)

CANCELLED - Missouri Public Service Commission - 08/26/2023 - JI-2024-0011

Issued: May 12, 2016
Issued By:

Kirby Underberg, General Manager
P.O. Box 67
Macon, Missouri 63552

Effective: June 11, 2016

FILED
Missouri Public
Service Commission
JI-2016-0317

Chariton Valley Telephone Corp.

LOCAL EXCHANGE SERVICE TARIFFS

WAIVER OF STATUTES and COMMISSION RULES

Pursuant to Law, the applicability of the following Missouri statutes and Public Service Commission rules have been waived for the Company:

Statutes

392.280 RSMo	Depreciation Rates
392.290 RSMo	Issuance of Securities
392.300 RSMo	Transfer of property, ownership of stock
392.310 RSMo	Stock and debt issuance
392.320 RSMo	Stock dividend payment
392.330 RSMo	Accounting Requirements, proceeds of sales
392.340 RSMo	Reorganization

Rules

4 CSR 240-3.550 (4) and (5)(A)	held order records, quality of service reports
4 CSR 240-32.060	engineering and maintenance
4 CSR 240-32.070	quality of service
4 CSR 240-32.080	service objectives and surveillance levels
4 CSR 240-33.040(1)-(3), (5)-(10)	billing and payment standards
4 CSR 240-33.045	charges on bills

Issued: January 23, 2009

James Simon
General Manager
P.O. Box 67
Macon, Missouri 63552

Effective: February 23, 2009

Chariton Valley Telephone Corp.

LOCAL EXCHANGE SERVICE TARIFFS

GENERAL

Unless otherwise specified, the charges quoted in this tariff are for one month and entitle the subscriber to an access line and messages to all stations within the calling scope of the exchanges as listed on Sheet F.

Rates:

Touch Button Access Line:

Business One Party	\$18.00	(I)
Residence One Party	\$18.00	(I)

When any municipality, other political subdivision or local agency or government, imposes upon the Company any license, occupation, or other similar charge or tax applicable to service by the Company to the customer, or imposes a charge or tax based upon a percentage of gross receipts, net receipts, or revenues from sale of telephone service by the Company, the charges for local service to customers within such municipality, other political subdivision or local agency of government shall be increased by an amount equal to each such customer's proportionate part of any such charge or tax, and such amount shall be shown separately on the customer's bill.

Issued: April 20, 2016

Kirby Underberg
General Manager
1213 E. Briggs Drive, P.O. Box 67
Macon, MO 63552

Effective: June 1, 2016

CANCELLED
June 1, 2017
Missouri Public
Service Commission
JI-2017-0231

FILED
Missouri Public
Service Commission
JI-2016-0275

Chariton Valley Telephone Corp.

LOCAL EXCHANGE SERVICE TARIFFS

GENERAL

Unless otherwise specified, the charges quoted in this tariff are for one month and entitle the subscriber to an access line and messages to all stations within the calling scope of the exchanges as listed on Sheet F.

Rates:

Touch Button Access Line:

Business One Party	\$16.00	(I)
Residence One Party	\$16.00	(I)

When any municipality, other political subdivision or local agency or government, imposes upon the Company any license, occupation, or other similar charge or tax applicable to service by the Company to the customer, or imposes a charge or tax based upon a percentage of gross receipts, net receipts, or revenues from sale of telephone service by the Company, the charges for local service to customers within such municipality, other political subdivision or local agency of government shall be increased by an amount equal to each such customer's proportionate part of any such charge or tax, and such amount shall be shown separately on the customer's bill.

Issued: October 22, 2014

James Simon
General Manager
1213 E. Briggs Drive, P.O. Box 67
Macon, MO 63552

Effective: December 1, 2014

CANCELLED
June 1, 2016
Missouri Public
Service Commission
JI-2016-0275

FILED
Missouri Public
Service Commission
JI-2015-0175

P.S.C. Mo. No. 1 Consolidated

12th Revised Sheet No. D
Cancels 11th Revised Sheet No. D
~~11th Revised Sheet No. D~~
~~Cancels 10th Revised Sheet No. D~~
For All Missouri Exchanges
Section I

Chariton Valley Telephone Corp.

LOCAL EXCHANGE SERVICE TARIFFS

GENERAL

Unless otherwise specified, the charges quoted in this tariff are for one month and entitle the subscriber to an access line and messages to all stations within the calling scope of the exchanges as listed on Sheet F.

(T)
|
(T)

Rates:

Touch Button Access Line:

Business One Party	\$14.00
Residence One Party	\$14.00

(I)

(I)

When any municipality, other political subdivision or local agency or government, imposes upon the Company any license, occupation, or other similar charge or tax applicable to service by the Company to the customer, or imposes a charge or tax based upon a percentage of gross receipts, net receipts, or revenues from sale of telephone service by the Company, the charges for local service to customers within such municipality, other political subdivision or local agency of government shall be increased by an amount equal to each such customer's proportionate part of any such charge or tax, and such amount shall be shown separately on the customer's bill.

(N)
|
(N)

Issued: March 28, 2013

James Simon
General Manager
1213 E. Briggs Drive, P.O. Box 67
Macon, MO 63552

Effective: June 1, 2013

CANCELLED
December 1, 2014
Missouri Public
Service Commission
JI-2015-0175

FILED
Missouri Public
Service Commission
JI-2013-0417

P.S.C. Mo. No. 1 Consolidated

~~11th Revised Sheet No. D~~ ~~10th Revised Sheet No. D~~

~~Cancels 10th Revised Sheet No. D~~ ~~Cancels 9th Revised Sheet No. D~~

For All Missouri Exchanges
Section I

Chariton Valley Telephone Corp.

LOCAL EXCHANGE SERVICE TARIFFS

GENERAL

Unless otherwise specified, the charges quoted in this tariff are for one month and entitle the subscriber to an access line and messages to all stations within the calling scope of the exchanges as listed on Sheet F.

(T)
|
(T)

Rates:

Touch Button Access Line:

Business One Party \$13.00

(I)

Residence One Party \$13.00

(I)

When any municipality, other political subdivision or local agency or government, imposes upon the Company any license, occupation, or other similar charge or tax applicable to service by the Company to the customer, or imposes a charge or tax based upon a percentage of gross receipts, net receipts, or revenues from sale of telephone service by the Company, the charges for local service to customers within such municipality, other political subdivision or local agency of government shall be increased by an amount equal to each such customer's proportionate part of any such charge or tax, and such amount shall be shown separately on the customer's bill.

(N)
|
(N)

Issued: May 22, 2012

James Simon

Effective: July 1, 2012

CANCELED
June 1, 2013
Missouri Public
Service Commission
JI-2013-0417

General Manager
1213 E. Briggs Drive, P.O. Box 67
Macon, MO 63552

FILED
Missouri Public
Service Commission
JI-2012-0759

P.S.C. MO. No. 1 CONSOLIDATED

10th Revised Sheet No. D
Cancels 9th Revised Sheet No. D
For All Missouri Exchanges
Section I

Chariton Valley Telephone Corp.

LOCAL EXCHANGE SERVICE TARIFFS

GENERAL

Unless otherwise specified, the rates quoted in this tariff are for the period of one month and entitle the subscriber access to our switching equipment, messages to all stations, and seven-digit dialing to all exchanges herein listed with calls to all listed exchanges to be toll-free and to be part of the local service rates as listed below.

EXCHANGE

Dewitt
Ethel
Forest Green

Atlanta
Bosworth
Clifton Hill
Excello
Jacksonville
New Cambria

Hale

EXCHANGE

Bucklin
New Boston

Bevier
Callao

Bynumville
Huntsville
Prairie Hill
Salisbury

(T)

(T)

Calls to subscribers of Chariton Valley Telecom Corporation service in Macon, Missouri are included in the local calling area of subscribers of Chariton Valley Telephone Corporation.

(N)

(N)

LOCAL SERVICE RATES

RESIDENTIAL RATE

\$ 12.00

BUSINESS RATE

\$ 12.00

(D)

(D)

Issued: July 7, 2003

William Biere
General Manager
606 Oak Street
Bucklin, MO 64631

Effective: August 6, 2003

Filed
MO PSC

CANCELLED
July 1, 2012
Missouri Public
Service Commission
JI-2012-0759

P.S.C. MO. No. 1 CONSOLIDATED

Chariton Valley Telephone Corp.

9th Revised Sheet No. D
Cancels 8th Revised Sheet No. D
For All Missouri Exchanges
Section 1

Missouri Public
Service Commission

LOCAL EXCHANGE SERVICE TARIFFS

REC'D NOV 01 1999

GENERAL

Unless otherwise specified, the rates quoted in this tariff are for the period of one month and entitle the subscriber access to our switching equipment, messages to all stations, and seven-digit dialing to all exchanges herein listed with calls to all listed exchanges to be toll-free and to be part of the local service rates as listed below.

(N)
(N)

<u>CODE</u>	<u>EXCHANGE</u>	<u>CODE</u>	<u>EXCHANGE</u>
A	Dewitt	D	Bucklin (T)
A	Ethel	D	New Boston (T)
A	Forest Green		
B	Atlanta	E	Bevier (T)
B	Bosworth	E	Callao (T)
B	Clifton Hill	F	Bynumville (T)
B	Excello	F	Huntsville
B	Jacksonville	F	Prairie Hill (T)
B	New Cambria	F	Salisbury (T)
C	Hale		

LOCAL SERVICE RATES

<u>CODE</u>	<u>RESIDENTAL RATE</u>	<u>BUSINESS RATE</u>
A	\$12.00	\$12.00
B	\$12.00	\$12.00
C	\$12.00	\$12.00
D	\$12.00	\$12.00
E	\$12.00	\$12.00
F	\$12.00	\$12.00

(I)
|
(I)

Issued: November 1, 1999

William Biere,
General Manager
P. O. Box 470
Bucklin, MO 64631

Effective: December 1, 1999

Missouri Public
Service Commission

FILED DEC 01 1999

Chariton Valley Telephone Corp.

For

All Missouri Exchanges

Name of Issuing Corporation

Community, Town or City (C) (U)
Section I

LOCAL EXCHANGE SERVICE TARIFFS

DEC 1 1987

GENERAL:

Unless otherwise specified, the charges quoted in this tariff are for the period of one month and entitles the subscriber to access to our switching equipment and messages to all stations, and exchanges as follows:

CODE	EXCHANGES
A	Dewitt
A	Ethel
A	Forest Green
B	Atlanta
B	Clifton Hill
B	Bosworth
B	Jacksonville
B	New Cambria
B	Excello
C	Hale
D	Bucklin (EAS to New Boston)
D	New Boston (EAS to Bucklin)
E	Bevier (EAS to Callao)
E	Callao (EAS to Bevier)
F	Bynumville (EAS to Salisbury & Prairie Hill)
F	Huntsville
F	Prairie Hill (EAS to Salisbury & Bynumville)
F	Salisbury (EAS to Bynumville & Prairie Hill)

CANCELLED

DEC 01 1987
By *PHRS*
Public Service Commission
MISSOURI

Class of Service - DIAL ONE PARTY - EXCHANGE WIDE

CODE	RATE	MAIN STATIONS
A	\$8.75 - \$5.55 Residence	0 - 199
B	\$9.05 - \$5.85 Residence	200 - 399
C	\$9.40 - \$6.20 Residence	400 - 599
D	\$9.75 - \$6.50 Residence	600 - 799
E	\$10.05 - \$6.85 Residence	800 - 999
F	\$10.35 - \$7.15 Residence	1000

*Indicates new rate of tax
+Indicates change

JAN 01 1988

Public Service Commission

DATE OF ISSUE DEC 18 1987
month day year

DATE EFFECTIVE January 1, 1988
month day year

ISSUED BY Robert E. Wright
name of officer

General Manager
title

Bucklin, Mo. 64631
address

Chariton Valley Telephone Corporation For
Name of Issuing Corporation

See Below
Community: Town or City

RECEIVED

RATES WITHIN THE INITIAL RATE AREA
LOCAL EXCHANGE SERVICE

MAY 20 1974

MISSOURI
Public Service Commission

GENERAL:

Unless otherwise specified, the charges quoted in this tariff are for the period of one month and entitles the subscriber to standard telephone equipment and messages to all station, in exchanges as follows:

BEVIER, MO. (EAS to Callao)	EXCELLO, MO.
BOSWORTH, MO.	HALE, MO.
CALLAO, MO. (EAS to Bevier)	NEW BOSTON, MO. (EAS to Bucklin)
DEWITT, MO.	NEW CAMBRIA, MO.

RATES WITHIN THE INITIAL RATE AREA:

CLASS OF SERVICE (DIAL)	MONTHLY - RATE
*Business one party	\$7.25 Available in all exchanges listed above.
*Residence one party	\$5.00 Available in all exchange listed above.
*Residence two party	\$4.50 Applicable in Hale, Excello, New Cambria, DeWitt, and New Boston only.
*Residence four party	\$4.00 Not available in Hale, Excello, New Cambria, DeWitt or New Boston.
Business Extensions	\$1.40 Monthly for the first extension
	\$1.25 Monthly for the second extension
	\$1.10 Monthly for the third extension and each additional extension.
Residence Extensions	\$.90 Monthly for the first extension
	\$.75 Monthly for the second extension
	\$.60 Monthly for the third and each additional extension.

CANCELLED
JAN 01 1988
P.S.C.
BY EXTENSION COMMISSION
PUBLIC SERVICE COMMISSION
OF MISSOURI

*These rates will apply in exchanges of Bevier, Callao, New Cambria, New Boston, Hale, Bosworth, DeWitt, and Excello until such time as facilities are available in those exchanges for ALL ONE PARTY SERVICE EXCHANGE WIDE, at which time rates as shown on 3rd revised sheet F will apply, and this sheet will then become obsolete.

FILED
JUL 1 1974
Public Service Commission

* Indicates new rate or text
+ Indicates change

DATE OF ISSUE June 1, 1974
month day year

DATE EFFECTIVE July 1, 1974
month day year

ISSUED BY H. Selman General Manager Bucklin, Missouri
name of officer title address

Chariton Valley Telephone Corporation For See Below
Name of Issuing Corporation Community, Town or City

RECEIVED
OCT 27 1972

RATES WITHIN THE INITIAL RATE AREA

LOCAL EXCHANGE SERVICE

MISSOURI

Public Service Commission

DISCOUNTS APPLYING TO THE ABOVE RATES --- NONE

Except that extension phones may be installed free of any charge whatsoever for a period of not to exceed 2 months, after which, if the customer notifies the company of his desire to have the extension removed, the company shall promptly remove same. Otherwise, the company shall, at the end of said 2 month period, begin billing the customer for the extension so installed.

ANY LICENSE TAX, GROSS RECEIPTS TAX, OCCUPATIONAL TAX, OR OTHER FEE, LEVIED BY ANY OF THE ABOVE MUNICIPALITIES IS TO BE ADDED TO THE ABOVE RATE AS A SEPARATE ITEM.

CONVERSATION TIMING

Conversation timing will continue to apply, exchange wide, including extended area service, in multi-party exchanges.

In one party exchanges with extended area service, conversation timing will apply to extended area service only.

Such conversation timing allows the customer totalk for approximately five (5) to seven (7) minutes. A warning tone is given over the line to the customer approximately one (1) minute before the circuit is interrupted.

CANCELLED

JAN 01 1988

BY PH R.S. D
PUBLIC SERVICE COMMISSION
OF MISSOURI

FILED

DEC 1 1972

Public Service Commission

*Indicates new rate or text
+Indicates change

DATE OF ISSUE November 1, 1972
monthly day year

DATE EFFECTIVE December 1, 1972
month day year

ISSUED BY T. L. Selmon
name of officer

General Manager Bucklin, Mo.
title address

Chariton Valley Telephone Corporation For
Name of Issuing Corporation

See Below

Community, Town or City

RECEIVED

RURAL RATES OUTSIDE THE INITIAL RATE AREA
LOCAL EXCHANGE SERVICE

MAY 20 1974

MISSOURI

Public Service Commission

GENERAL:

Unless otherwise specified, the charges quoted in this tariff are for the period of one month, and entitle the subscriber to standard telephone equipment and messages to all stations, and exchanges as follows:

BEVIER, MO. (EAS TO Callao)	EXCELLO, MO.
BOSWORTH, MO.	HALE, MO.
CALLAO, MO. (EAS to Bevier)	NEW BOSTON, MO. (EAS to Bucklin)
DEWITT, MO.	NEW CAMBRIA, MO.

RATES OUTSIDE THE INITIAL RATE AREA, BUT within the Exchange area (Rural Multi Party)

CLASS OF SERVICE (DIAL)	MONTHLY - RATE
*Rural 8 party business	\$4.75 (not available in Hale and Excello)
*Rural 8 party residence	\$4.25 (not available in Hale and Excello)
*Rural 5 party business	\$5.25 (available in Hale and Excello only)
*Rural 5 party residence	\$4.75 (available in Hale and Excello only)

All rural facilities are company owned. The company owns and maintains all equipment for rendering service.
Discounts applying to the above rates --- NONE
Except that extension phones may be installed free of any charge whatsoever for a period of not to exceed 2 months, after which, if the customer notifies the company of his desire to have the extension removed, the company shall promptly remove same. Otherwise, the company shall, at the end of said 2 month period, begin billing the customer for the extension so installed.

*These rates will apply in exchanges of Bevier, Callao, New Cambria, New Boston, Hale, Bosworth, DeWitt and Excello until such time as facilities are available in those exchanges for ALL ONE PARTY SERVICE EXCHANGE WIDE, at which time rates as shown on 3rd revised sheet F will apply.

CANCELLED

JAN 01 1988

BY *RA R. S. #E*
PUBLIC SERVICE COMMISSION
OF MISSOURI

FILED

JUL 1 1974

Public Service Commission

*Indicates new rate or text
+Indicates change

DATE OF ISSUE June 1, 1974 DATE EFFECTIVE July 1, 1974
month day year month day year
ISSUED BY *H. Selmer* General Manager Bucklin, Mo.
name of officer title address

Chariton Valley Telephone Corp.
Name of Issuing Corporation

For All Missouri Exchanges
Community, Town or City

Section 7-300020

1981 06 30 10 81

EXCHANGE WIDE RATES ALL ONE PARTY SERVICE

GENERAL:

Unless otherwise specified, the charges quoted in this tariff are for the period of one month and entitles the subscriber to access switching equipment and messages to all stations, and exchanges as follows:

CODE	EXCHANGES
A	Dewitt
A	Ethel
A	Forest Green
B	Atlanta
B	Clifton Hill
B	Bosworth
B	Jacksonville
B	New Cambria
B	Excello
C	Hale
D	Bucklin (EAS to New Boston)
D	New Boston (EAS to Bucklin)
E	Bevier (EAS to Callao)
E	Callao (EAS to Bevier)
F	Bynumville (EAS to Salisbury & Prairie Hill)
F	Huntsville
F	Prairie Hill (EAS to Salisbury & Bynumville)
F	Salisbury (EAS to Bynumville & Prairie Hill)

CANCELLED

JAN 01 1988
BY R.A.B.S.#F
PUBLIC SERVICE COMMISSION
OF MISSOURI

Class of Service - DIAL ONE PARTY - EXCHANGE WIDE

The following rates apply at cutover to dial - All one (1) party service - exchange wide:

CODE	RATE	MAIN STATIONS
A	\$ 8.75 - \$5.55 Residence	0 - 199
B	9.05 - 5.85 Residence	200 - 399
C	9.40 - 6.20 Residence	400 - 599
D	9.75 - 6.50 Residence	600 - 799
E	10.05 - 6.85 Residence	800 - 999
F	10.35 - 7.15 Residence	1000 and over

FILED
AUG - 1 1981

*Indicates new rate or text
+Indicates change

DATE OF ISSUE June 30, 1981
month day year

DATE EFFECTIVE August 1, 1981
month day year

ISSUED BY Robert E. Wright Gen. Mgr. Bucklin, MO 64631
name of officer title address

Robert E. Wright

Public Service Commission

Chariton Valley Telephone Corporation For
Name of Issuing Corporation

See Below
Community, Town or City
Section I

EXCHANGE WIDE RATES
ALL ONE PARTY SERVICE

RECEIVED
MAR 24 1980
MISSOURI
Public Service Commission

GENERAL:

Unless otherwise specified, the charges quoted in this tariff are for the period of one month and entitles the subscriber to standard telephone equipment and messages to all stations, and

CODE	EXCHANGES
A	Dewitt
A	Ethel
A	Forest Green
B	Atlanta
B	Clifton Hill
B	Bosworth
B	Jacksonville
B	New Cambria
B	Excello
C	Hale
D	Bucklin (EAS to New Boston)
D	New Boston (EAS to Bucklin)
E	Bevier (EAS to Callao)
E	Callao (EAS to Bevier)
F	Bynumville (EAS to Salisbury & Prairie Hill)
F	Huntsville
F	Prairie Hill (EAS to Salisbury & Bynumville)
F	Salisbury (EAS to Bynumville & Prairie Hill)

CANCELLED
MAY 1 1981
BY *TERSE*
PUBLIC SERVICE COMMISSION
OF MISSOURI

CLASS OF SERVICE - DIAL ONE PARTY - EXCHANGE WIDE

The following rates apply at cutover to dial - All one (1) party service - exchange wide:

CODE	RATE	MAIN STATIONS
A	\$ 9.65 - \$6.45 Residence	0 - 199
B	9.95 - 6.75 Residence	200 - 399
C	10.30 - 7.10 Residence	400 - 599
D	10.65 - 7.40 Residence	600 - 799
E	10.95 - 7.75 Residence	800 - 999
F	11.25 - 8.05 Residence	1000 and over

FILED
MAY 1 - 1980
Public Service Commission

*Indicates new rate or text
+Indicates change

DATE OF ISSUE April 1, 1980
month day year

DATE EFFECTIVE May 1, 1980
month day year

ISSUED BY Robert E. Wright name of officer
General Manager title
Bucklin, MO 64631 address

FORM NO. 13

P.S.C.MO. No. 1 Consolidated

Interim

5th

{ Original }

SHEET No. F

Interim

{ Revised }

Cancelling P.S.C.MO. No. 1 Consolidated

4th

{ Original }

SHEET No. F

{ Revised }

Chariton Valley Telephone Corporation

For See Below

Name of Issuing Corporation

Community, Town or City

EXCHANGE WIDE RATES

ALL ONE PARTY SERVICE

GENERAL:

Unless otherwise specified the charges quoted in this tariff are for the period of one month and entitles the subscriber to standard telephone equipment and messages to all stations, and exchanges as follows

CODE

EXCHANGES

- A CLIFTON HILL, MO.
- A DEWITT, MO.
- A ETHEL, MO.
- A FOREST GREEN, MO.
- B ATLANTA, MO.
- B BOSWORTH, MO.
- B HALE, MO.
- B JACKSONVILLE, MO.
- B NEW CAMBRIA, MO.
- B EXCELLO, MO.
- C BUCKLIN, MO. (EAS to New Boston)
- C NEW BOSTON, MO. (EAS to Bucklin)
- E BEVIER, MO. (EAS to Callao)
- E CALLAO, MO. (EAS to Bevier)
- E HUNTSVILLE, MO.
- F BYNUMVILLE, MO. (EAS to Salisbury & Prairie Hill)
- F PRAIRIE HILL, MO. (EAS to Salisbury & Bynumville)
- F SALISBURY, MO. (EAS to Bynumville & Prairie Hill)

CANCELLED

MAY - 1 1980
BY 6th R.S.F.
PUBLIC SERVICE COMMISSION
OF MISSOURI

RECEIVED
JAN 29 1979
MISSOURI
Public Service Commission

CLASS OF SERVICE - DIAL ONE PARTY - EXCHANGE WIDE

The following rates apply at cutover to dial - All one (1) party service - exchange wide:

CODE	RATE	MAIN STATIONS
A	\$ 9.65 Business - \$6.45 Residence	0 - 199
B	\$ 9.95 Business - \$6.75 Residence	200 - 399
C	\$10.30 Business - \$7.10 Residence	400 - 500
D	\$10.65 Business - \$7.40 Residence	600 - 799
E	\$10.95 Business - \$7.75 Residence	800 - 999
F	\$11.25 Business - \$8.05 Residence	1000 and over

*Indicates new rate or text
+Indicates change

FILED
MAR 1 - 1979
78 - 237
Public Service Commission

DATE OF ISSUE January 29, 1979
month day year

DATE EFFECTIVE March 1, 1979
month day year

ISSUED BY Robert E. Wright General Manager, Bucklin, Missouri 64631
name of officer title address

Chariton Valley Telephone Corporation
Name of Issuing Corporation

For

See Below

Community, Town or City

EXCHANGE WIDE RATES
ALL ONE PARTY SERVICE

GENERAL:

Unless otherwise specified the charges quoted in this tariff are for the period of one month and entitles the subscriber to standard telephone equipment and messages to all stations, and exchanges as follows:

CODE	EXCHANGE
A	CLIFTON HILL, MO.
A	DEWITT, MO.
A	ETHEL, MO.
A	FOREST GREEN, MO.
B	ATLANTA, MO.
B	BOSWORTH, MO.
B	HALE, MO.
B	JACKSONVILLE, MO.
B	NEW CAMBRIA, MO.
B	EXCELLO, MO.
C	BUCKLIN, MO. (EAS to New Boston)
C	NEW BOSTON, MO. (EAS to Bucklin)
E	BEVIER, MO. (EAS to Callao)
E	CALLAO, MO. (EAS to Bevier)
E	HUNTSVILLE, MO.
F	BYNUMVILLE, MO. (EAS to Salisbury & Prairie Hill)
F	PRAIRIE HILL, MO. (EAS to Salisbury & Bynumville)
F	SALISBURY, MO. (EAS to Bynumville & Prairie Hill)

RECEIVED
APR 14 1978
MISSOURI
Public Service Commission

CANCELLED

MAR 1 - 1979
Inter 5th RS F
BY
PUBLIC SERVICE COMMISSION

FILED
SEP 1 1978
Public Service Commission

CLASS OF SERVICE - DIAL ONE PARTY - EXCHANGE WIDE

The following rates apply at cutover to dial - All one (1) party service - exchange wide:

CODE	RATE	MAIN STATIONS
A	\$ 9.65 Business - \$6.45 Residence	0 - 199
B	\$ 9.95 Business - \$6.75 Residence	200 - 399
C	\$10.30 Business - \$7.10 Residence	400 - 599
D	\$10.65 Business - \$7.40 Residence	600 - 799
E	\$10.95 Business - \$7.75 Residence	800 - 999
F	\$11.25 Business - \$8.05 Residence	1000 and over

*Indicates new rate or text
+Indicates change

Case # 78-237

SEP 1 - 1978

DATE OF ISSUE April 14, 1978
month day year

DATE EFFECTIVE May 15, 1978
month day year

ISSUED BY Robert E. Wright
name of officer

General Manager Bucklin, MO. 64631
title address

Chariton Valley Telephone Corporation For
Name of Issuing Corporation

See Below

Community, Town or City

RECEIVED

EXCHANGE WIDE RATES
ALL ONE PARTY SERVICE

MAY 20 1974

MISSOURI

Public Service Commission

GENERAL:

Unless otherwise specified the charges quoted in this tariff are for the period of one month and entitles the subscriber to standard telephone equipment and messages to all stations, and exchanges as follows:

CODE	EXCHANGE
A	CLIFTON HILL, MO.
A	DEWITT, MO.
A	ETHEL, MO.
A	FOREST GREEN, MO.
B	ATLANTA, MO.
B	BOSWORTH, MO.
B	HALE, MO.
B	JACKSONVILLE, MO.
B	NEW CAMBRIA, MO.
B	EXCELLO, MO.
C	BUCKLIN, MO. (EAS to New Boston)
C	NEW BOSTON, MO. (EAS to Bucklin)
E	BEVIER, MO. (EAS to Callao)
E	CALLAO, MO. (EAS to Bevier)
E	HUNTSVILLE, MO.
F	BYNUMVILLE, MO. (EAS to Salisbury & Prairie Hill)
F	PRAIRIE HILL, MO. (EAS to Salisbury & Bynumville)
F	SALISBURY, MO. (EAS to Bynumville & Prairie Hill)

CANCELLED

SEP 1 1978

BY *Int. 472 RS F*
PUBLIC SERVICE COMMISSION
OF MISSOURI

CLASS OF SERVICE - DIAL ONE PARTY - EXCHANGE WIDE

The following rates apply at cutover to dial - All one (1) party service - exchange wide:

CODE	RATE	MAIN STATIONS
A	\$7.50 Business - \$5.00 Residence	0 - 199
B	\$7.75 Business - \$5.25 Residence	200 - 399
C	\$8.00 Business - \$5.50 Residence	400 - 599
D	\$8.25 Business - \$5.75 Residence	600 - 799
E	\$8.50 Business - \$6.00 Residence	800 - 999
F	\$8.75 Business - \$6.25 Residence	1000 and over

FILED

JUL 1 1974

Public Service Commission

DATE OF ISSUE June 1, 1974
month day year

DATE EFFECTIVE July 1, 1974
month day year

ISSUED BY *J. C. Selmon*
name of officer

General Manager Bucklin, Missouri
title address

FORM NO. 13 P.S.C.MO. No. 1 Consolidated 6th {Original} SHEET No. F1

Cancelling P.S.C.MO. No. 1 Consolidated 5th {Original} SHEET No. F1

CHARITON VALLEY TELEPHONE CORP. For See Below
Name of Issuing Corporation Community, Town or City

RECEIVED

EXCHANGE WIDE RATES ALL ONE PARTY SERVICE

DEC 20 1982

GENERAL (cont'd)

Standard Instrument Charge (1)

Monthly R MISSOURI
Public Service Commission

All facilities are company owned. The company owns and maintains all equipment for rendering service.

The Instrument Charge does not apply to customer-owned equipment.

ANY LICENSE TAX, GROSS RECEIPTS TAX, OCCUPATIONAL TAX, OR OTHER FEE, LEVIED BY ANY OF THE ABOVE MUNICIPALITIES IS TO BE ADDED TO THE ABOVE RATES AS A SEPARATE ITEM.

CANCELLED

JAN 01 1983
BY 84 R.S.#F
PUBLIC SERVICE COMMISSION
OF MISSOURI

(1) Limited Availability. See General Rules and Regulations, 2nd Revised Sheet No. 45.

*Indicates new rate or text
+Indicates change

FILED
JAN - 1 1983
TAC # 803
Public Service Commission

DATE OF ISSUE December 20, 1982 DATE EFFECTIVE January 1, 1983
month day year month day year

ISSUED BY Robert E. Wright General Mgr. Bucklin, MO.
Robert E. Wright name of officer title address

Chariton Valley Telephone Corp. For See Below
 Name of Issuing Corporation Community, Town or City

EXCHANGE WIDE RATES ALL ONE PARTY SERVICE		RECEIVED JUN 30 1981 Monthly Rate <u>MISSOURI</u> \$1.90 Public Service Commission
GENERAL (continued)		
Standard Instrument Charge		
<p>All facilities are company owned. The company owns and maintains all equipment for rendering service.</p> <p>The Instrument Charge does not apply to customer-owned equipment.</p> <p>ANY LICENSE TAX, GROSS RECEIPTS TAX, OCCUPATIONAL TAX, OR OTHER FEE, LEVIED BY ANY OF THE ABOVE MUNICIPALITIES IS TO BE ADDED TO THE ABOVE RATES AS A SEPARATE ITEM.</p>		
<p>CANCELLED</p> <p>JAN - 1 1983</p> <p>BY <u>Lot RS FL</u></p> <p>PUBLIC SERVICE COMMISSION OF MISSOURI</p>		
<p>*Indicates new rate or text</p> <p>+Indicates change</p>		<div style="border: 1px solid black; padding: 5px;"> <p>FILED</p> <p>AUG - 1 1981</p> <p>Public Service Commission</p> </div>

DATE OF ISSUE June 30 1981 DATE EFFECTIVE August 1 1981
month day year month day year

ISSUED BY Robert E. Wright Gen. Mgr. Bucklin, MO 64631
name of officer title address

Robert E. Wright

FORM NO. 13 P.S.C.MO. No. 1 Consolidated 4th (~~ORIGINAL~~) SHEET No. F1
 (Revised)
 Cancelling P.S.C.MO. No. 1 Consolidated 3rd (~~ORIGINAL~~) SHEET No. F1
 (Revised)
Chariton Valley Telephone Corp. For See Below
 Name of Issuing Corporation Community, Town or City

EXCHANGE WIDE RATES		RECEIVED
ALL ONE PARTY SERVICE		
GENERAL (continued)		FEB 8 - 1980
		MISSOURI Public Service Commission
Business Extensions:	\$1.10	
Residence Extensions:	\$.90	
<p>All facilities are company owned. The company owns and maintains all equipment for rendering service.</p> <p>ANY LICENSE TAX, GROSS RECEIPTS TAX, OCCUPATIONAL TAX, OR OTHER FEE, LEVIED BY ANY OF THE ABOVE MUNICIPALITIES IS TO BE ADDED TO THE ABOVE RATES AS A SEPARATE ITEM.</p>		
<p>CANCELLED</p> <p>AUG - 1 1981</p> <p>BY <u>5th RS F1</u></p> <p>PUBLIC SERVICE COMMISSION OF MISSOURI</p>		
<p>FILED</p> <p>MAR 10 1980</p> <p>79 - 165</p>		
<p>*Indicates new rate or text †Indicates change</p>		

DATE OF ISSUE February 8, 1980 DATE EFFECTIVE March 10, 1980
 month day year month day year
 ISSUED BY Robert E. Wright General Manager Bucklin, Missouri
 name of officer title address

FORM NO. 13

P.S.C.MO. No. 1 Consolidated

Interim

3 rd

{ Original }

SHEET No. F 1

Interim

{ Revised }

Cancelling P.S.C.MO. No. 1 Consolidated 2 nd

{ Original }

SHEET No. F 1

{ Revised }

Chariton Valley Telephone Corporation
Name of Issuing Corporation

For See Below

Community, Town or City

RECEIVED

JAN 29 1979

MISSOURI

Public Service Commission

EXCHANGE WIDE RATES

ALL ONE PARTY SERVICE

GENERAL (continued)

Monthly Rate

Business Extensions:

- \$1.40 - First Extension
- 1.25 - Second Extension
- 1.10 - Third and Each Additional Extension

Residence Extensions:

- \$.90 - First Extension
- .75 - Second Extension
- .60 - Third and Each Additional Extension

All facilities are company owned. The company owns and maintains all equipment for rendering service.

ANY LICENSE TAX, GROSS RECEIPTS TAX, OCCUPATIONAL TAX, OR OTHER FEE, LEVIED BY ANY OF THE ABOVE MUNICIPALITIES IS TO BE ADDED TO THE ABOVE RATES AS A SEPARATE ITEM.

CANCELLED

MAR 16 1980

BY 4th R.S. F1
PUBLIC SERVICE COMMISSION
OF MISSOURI

FILED

MAR 1 - 1979

78 - 237

Public Service Commission

*Indicates new rate or text
+Indicates change

DATE OF ISSUE January 29, 1979
month day year

DATE EFFECTIVE March 1, 1979
month day year

ISSUED BY Robert E. Wright
Robert E. Wright name of officer

General Manager Bucklin, Missouri 6463
title address

RECEIVED

EXCHANGE WIDE RATES		APR 11 1978
ALL ONE PARTY SERVICE		
GENERAL (continued)		MISSOURI Public Service Commission
	Monthly Rate	
Business Extensions:	\$1.40 - First Extension 1.25 - Second Extension 1.10 - Third and Each Additional Extension	
Residence Extensions:	\$.90 - First Extension .75 - Second Extension .60 - Third and Each Additional Extension	
All facilities are company owned. The company owns and maintains all equipment for rendering service.		
ANY LICENSE TAX, GROSS RECEIPTS TAX, OCCUPATIONAL TAX, OR OTHER FEE, LEVIED BY ANY OF THE ABOVE MUNICIPALITIES IS TO BE ADDED TO THE ABOVE RATES AS A SEPARATE ITEM.		
CANCELLED		FILED
MAR 1 - 1979		SEP 1 1978
BY <u>Judy 3rd RS F1</u> PUBLIC SERVICE COMMISSION OF MISSOURI		Public Service Commission
*Indicates new rate or text +Indicates change	Case # 78 - 237	

Chariton Valley Telephone Corporation For See Below
Name of Issuing Corporation Community, Town or City

RECEIVED

EXCHANGE WIDE RATES
ALL ONE PARTY SERVICE

MAR 7 1978

GENERAL (continued)

MISSOURI

Business Extensions:

Monthly Rate Public Service Commission

\$1.40 - First Extension
1.25 - Second Extension
1.10 - Third and Each
Additional Extension

Residence Extensions:

\$.90 - First Extension
.75 - Second Extension
.60 - Third and Each
Additional Extension

All facilities are company owned. The company owns and maintains all equipment for rendering service.

ANY LICENSE TAX, GROSS RECEIPTS TAX, OCCUPATIONAL TAX, OR OTHER FEE, LEVIED BY ANY OF THE ABOVE MUNICIPALITIES IS TO BE ADDED TO THE ABOVE RATES AS A SEPARATE ITEM.

CANCELLED

SEP 1 1978

BY Int. 2485 F1
PUBLIC SERVICE COMMISSION
OF MISSOURI

FILED

MAY 1 1978

Public Service Commission

*Indicates new rate or text
+Indicates change

DATE OF ISSUE March 1, 1978 DATE EFFECTIVE May 1, 1978
month day year month day year

ISSUED BY Robert E. Haight General Manager Bucklin, MO
name of officer title address

Chariton Valley Telephone Corp.
Name of Issuing Corporation

For All-Missouri Exchanges
Community, Town or City

Section I

CUSTOMER PROVIDED EQUIPMENT

RECEIVED

JUN 30 1981

PUBLIC SERVICE COMMISSION

1. Upon proper notice to the Telephone Company, a customer may connect customer-owned instruments to one-party residence or business exchange facilities. If a customer-owned instrument is used, there will be no recurring monthly charge for that instrument.
2. A customer desiring to connect customer provided instruments to the telephone network must make application to the company. The customer shall provide the following information regarding the customer-provided equipment:
 - a. The type and manufacturer of each item of grandfathered equipment or
 - b. The registration number and ringer equivalence of the registered equipment.
3. Installation charges are applicable to the installation of jacks as reflected elsewhere in this tariff.
4. The Telephone Company shall not be responsible for the installation, operation or maintenance of customer-provided equipment.
5. Upon notification from the Company that the customer-provided equipment is causing or is likely to cause harm, the customer shall make such change as is necessary to remove such harm. Failure to make such change will result in disconnection of service until such change is completed to the satisfaction of the Company.

CANCELLED

JAN 01 1988

BY *SJA* FILED
 PUBLIC SERVICE COMMISSION
 OF MISSOURI
 AUG - 1 1981
 Public Service Commission

*Indicates new rate or text

+Indicates change

DATE OF ISSUE June 30 1981
month day year

DATE EFFECTIVE August 1 1981
month day year

ISSUED BY *Robert E. Wright*
name of officer

General Manager Bucklin, MO
title address

Robert E. Wright

Chariton Valley Telephone Corp.

For

All Missouri Exchanges

Name of Issuing Corporation

Community Town or City
Section RECEIVED

Customer Provided Equipment

SEP 21 1979

MISSOURI
Public Service Commission

1. Upon proper notice to the Telephone Company, a customer ~~may connect~~ customer-owned instruments to one-party residence or business exchange facilities. If a customer-owned instrument is used as an extension station there will be no recurring monthly charge for that extension.
2. A customer desiring to connect customer provided instruments to the telephone network must make application to the company. The customer shall provide the following information regarding the customer-provided equipment:
 - a. The type and manufacturer of each item of grandfathered equipment or
 - b. The registration number and ringer equivalence of the registered equipment.
3. Installation charges are applicable to the installation of jacks as reflected elsewhere in this tariff.
4. The Telephone Company shall not be responsible for the installation, operation or maintenance of customer-provided equipment.
5. Upon notification from the Company that the customer-provided equipment is causing or is likely to cause harm, the customer shall make such change as is necessary to remove such harm. Failure to make such change will result in disconnection of service until such change is completed to the satisfaction of the Company.

CANCELLED

AUG - 1 1981
BY Let R S F2
PUBLIC SERVICE COMMISSION
OF MISSOURI

FILED

NOV 1 - 1979

Public Service Commission

*Indicates new rate or text
+Indicates change

DATE OF ISSUE September 29, 1979
month day year

DATE EFFECTIVE November 1, 1979
month day year

ISSUED BY Robert E. Wright
name of officer
Robert E. Wright

General Manager
title

Bucklin, Missouri
address

Chariton Valley Telephone Corporation For _____
 Name of Issuing Corporation Community-Town-or-City

RECEIVED

MOVEMENT OF EXCHANGES BETWEEN RATE GROUPS		DEC 19 1975
<ol style="list-style-type: none"> 1. The term "Rate Group" refers to applicable codes and main station limitations for all exchanges as shown on 3rd revised sheet of this tariff section. 2. An exchange is placed in a Rate Group on the basis of the number of main stations in that exchange. Two or more exchanges are so placed when Extended Area Service between such exchanges provides toll free calling between them. In the foregoing the exchange area is also the "Local Calling Area" and in the case of Extended Area Service, the areas included would be referred to as an "Extended Calling Area." 3. When the number of main stations in either a local or extended calling area changes by growth or loss of main stations so that the aggregate numbers of main stations exceeds the maximum or falls below the minimum number of main stations allowed in the rate group for that exchange by as many as ten (10) main stations, and such station count position is maintained for four (4) consecutive months, then the exchange thus affected will be moved to the appropriate rate group, provided that notification of such change be given to all affected customers and such notification be also given to the Missouri Public Service Commission by letter, explaining the changes to be made, including applicable revised tariff sheets. 4. The new-local service rates as set forth in the revised tariff sheet referred to in paragraph #3 above will be made effective on the 1st billing date after acceptance of the filing by the Missouri Public Service Commission. 	<p style="text-align: center; font-weight: bold; font-size: 1.2em;">MISSOURI</p> <p style="text-align: center; font-weight: bold;">PUBLIC SERVICE COMMISSION</p>	
<p>*Indicates new rate or text †Indicates change</p>		<div style="border: 1px solid black; padding: 10px; width: fit-content; margin: 0 auto;"> <p style="font-size: 1.5em; font-weight: bold; margin: 0;">FILED</p> <p style="margin: 0;">FEB 1 1976</p> <p style="font-weight: bold; margin: 0;">Public Service Commission</p> </div>

DATE OF ISSUE January 1, 1976 DATE EFFECTIVE February 1, 1976
month day year month day year

ISSUED BY T. L. Selmon General Manager Bucklin, MO
name of officer title address

Chariton Valley Telephone Corporation

For


Atlanta, Missouri

Name of Issuing Corporation

Community, Town or City

Section 1

ATLANTA EXCHANGE AREA MAP

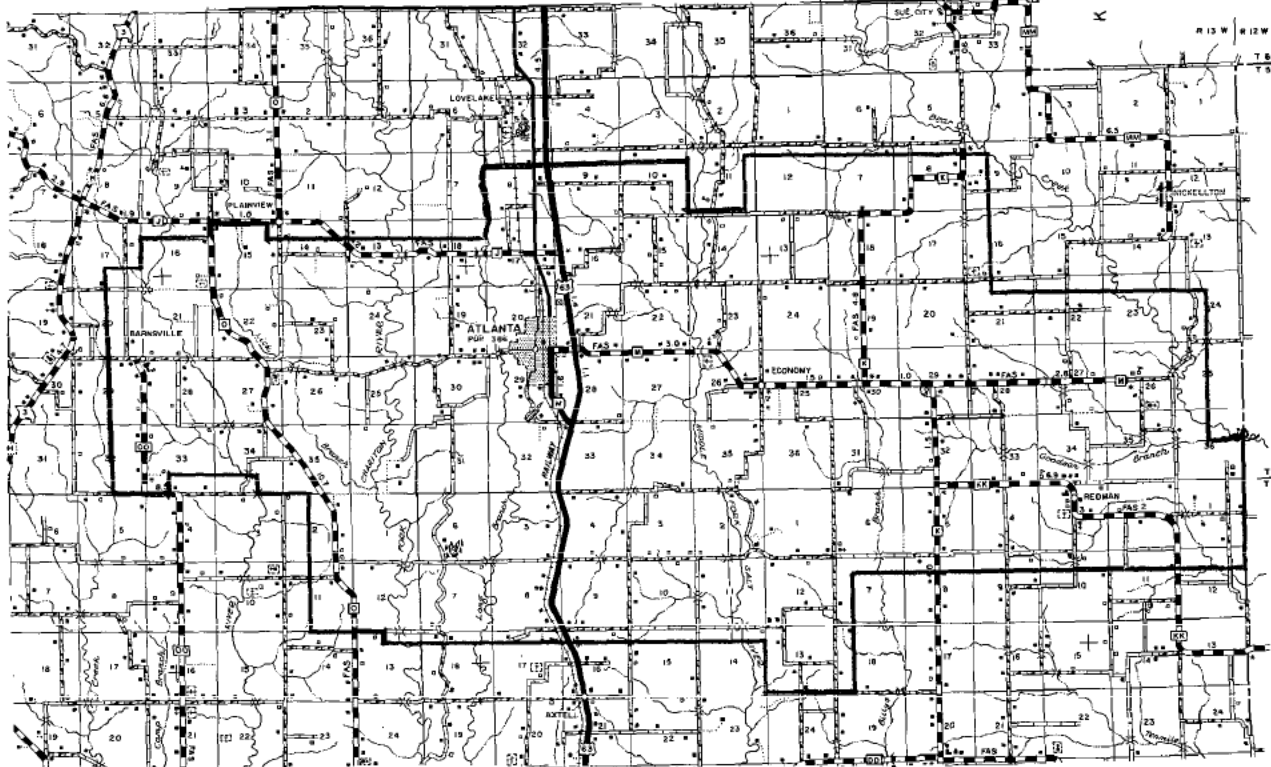

COUNTY

CANCELLED

SEP 1 1910

*Indicates new rate or text

+Indicates change

PUBLIC SERVICE COMMISSION

FIL

MAY 1 1975

Public Service Commission

DATE OF ISSUE April 18, 1975
month day year

DATE EFFECTIVE May 1, 1975
month day year

ISSUED BY T. L. Selmon
name of officer
T. L. Selmon

General Manager, Bucklin, Missouri
title address

Chariton Valley Telephone Corp.
Name of Issuing Corporation

For

Bevier, Missouri


Community, Town or City

Section 1

JUL 12 1978

MISSOURI
Public Service Commission

EXCHANGE AREA MAP

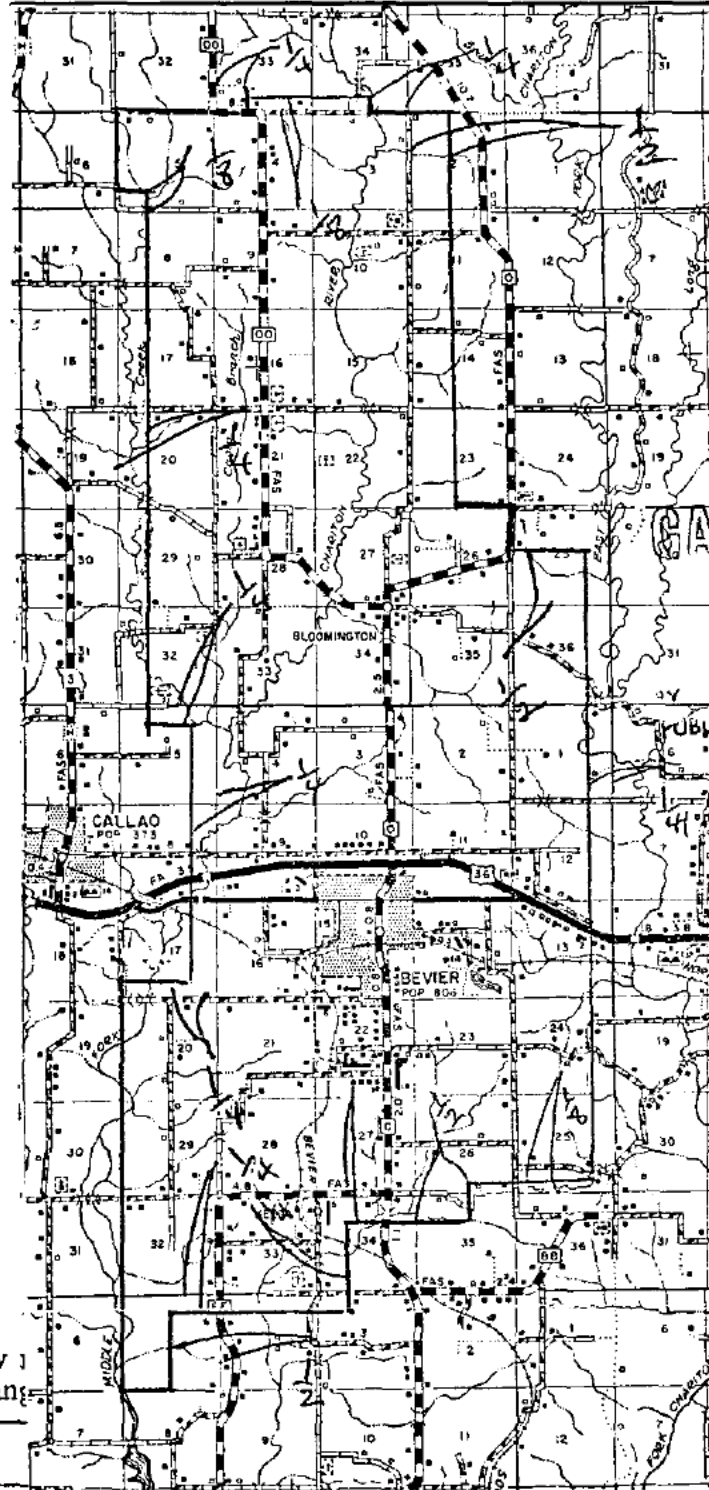

CANCELLED

JUL - 8 1984

3rd RS 3

PUBLIC SERVICE COMMISSION
OF MISSOURI

FILED

SEP 1 1978

*Indicates new
+Indicates change

DATE OF ISSUE

month day year

Public Service Commission
Sept. 1, 1978

month day year

ISSUED BY

Robert E. Wright
name of officer

General Manager

title

Bucklin, Mo.


address

Chariton Valley Telephone Corporation
Name of Issuing Corporation or Municipality

For Bevier, Missouri
Community, Town or City

Section No. 1

EXCHANGE AREA MAP

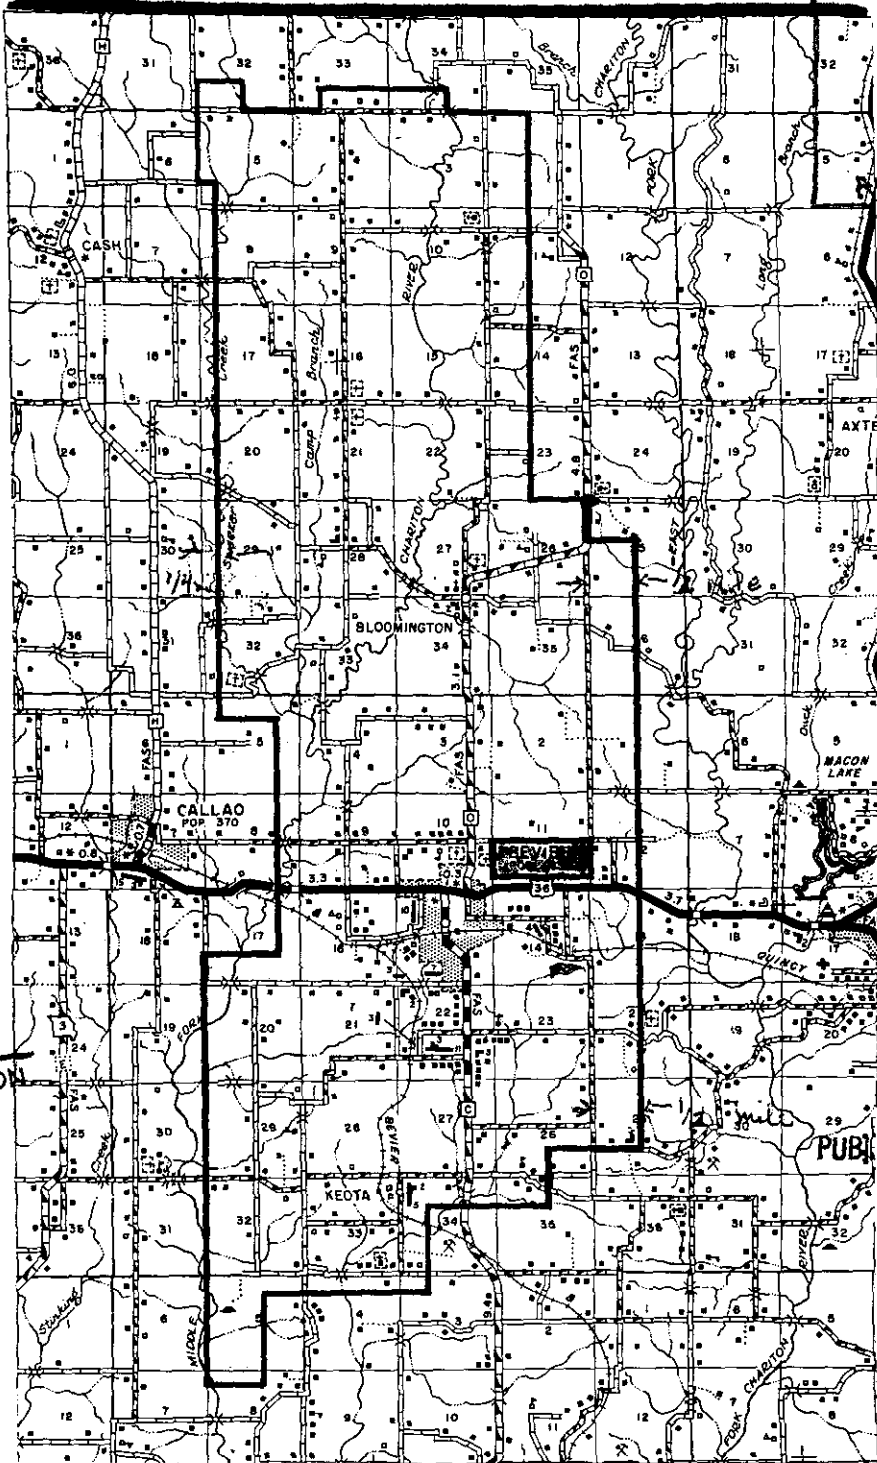

RECEIVED
JAN 15 1960
MISSOURI
Public Service Comm.

TELEPHONE AUTHORITY
ORDER NO. 302

FILED
FEB 15 1960

PUBLIC SERVICE COMMISSION

CANCELLED

SEP 1 1978
BY *2nd R 5 3*
PUBLIC SERVICE COMMISSION
OF MISSOURI

DATE OF ISSUE January 15, 1960
month day year

DATE EFFECTIVE February 15, 1960
month day year

ISSUED BY

Carl H. ...
name of officer

General Manager
title

Bucklin, Missouri
address


Cancelling P. S. C. MO. No. All Previous Schedules

Chariton Valley Telephone Corporation
Name of Issuing Corporation or Municipality

For Bosworth, Missouri
Community, Town or City

Section I

EXCHANGE AREA MAP

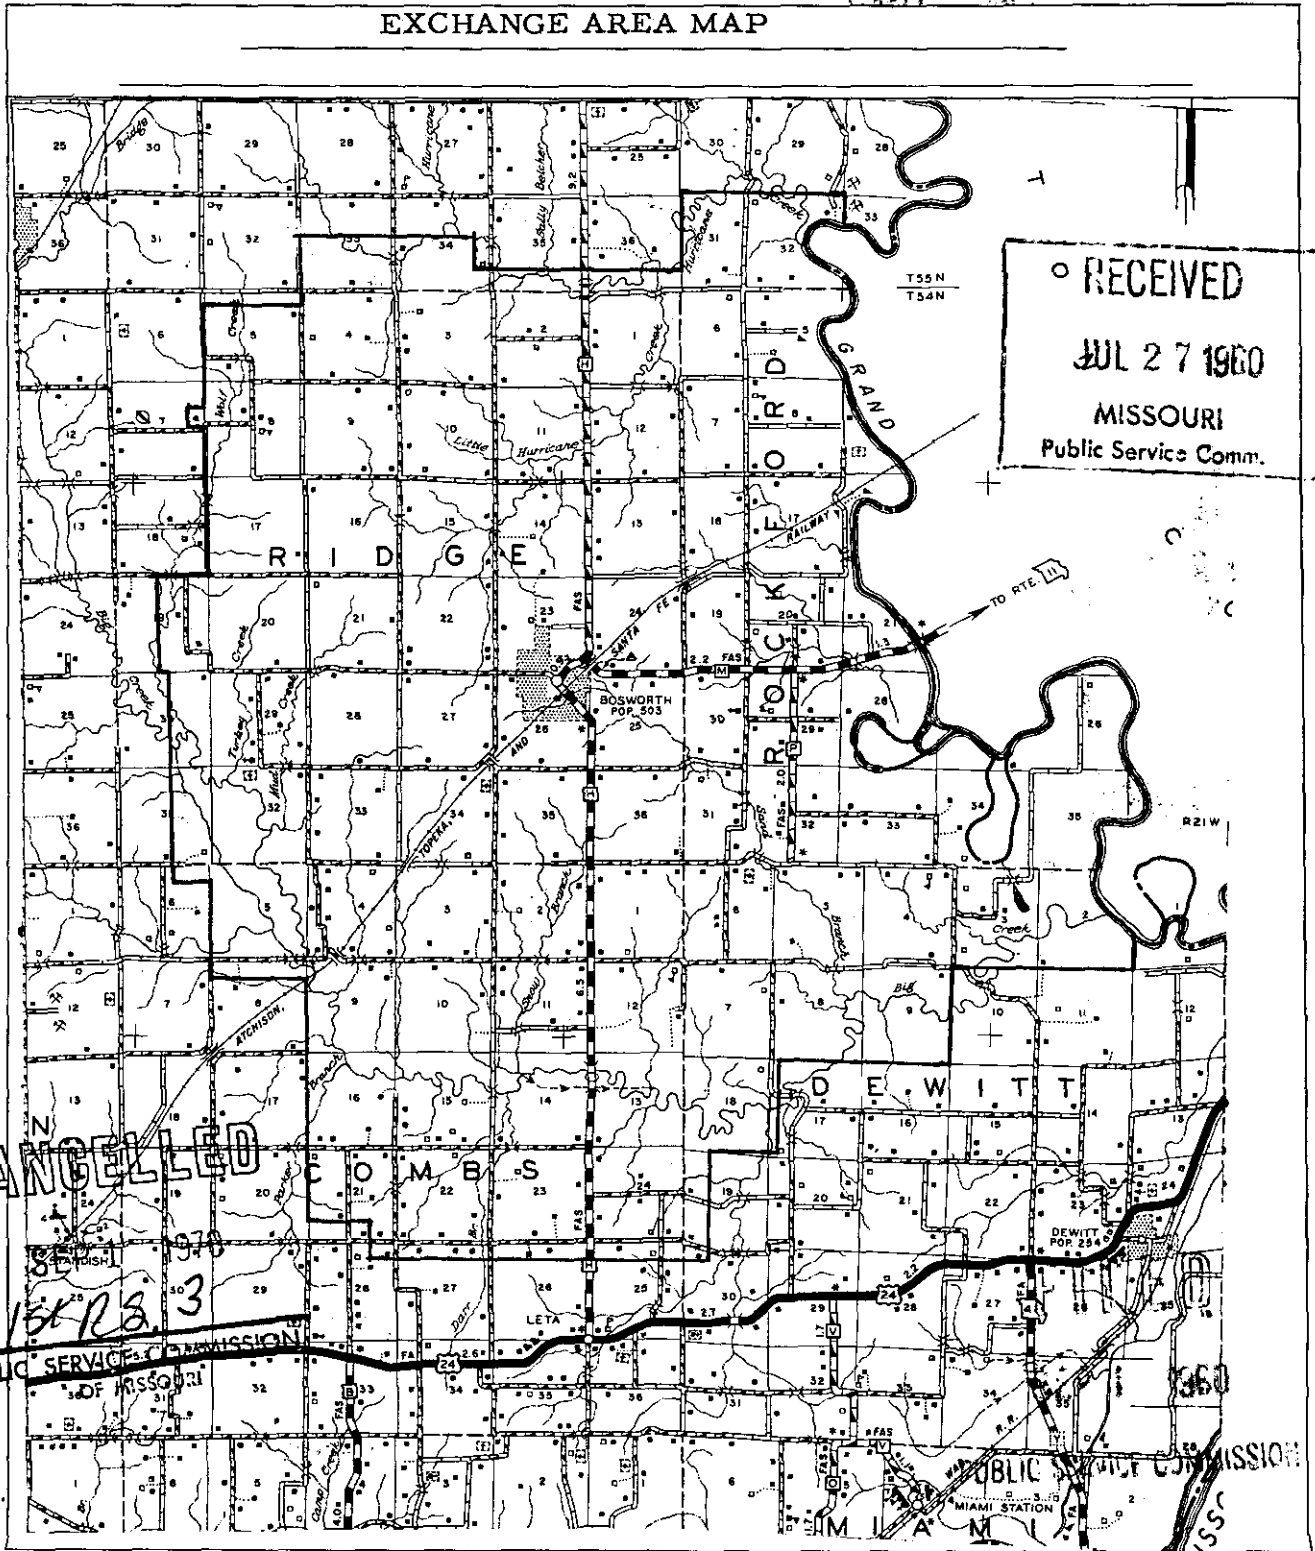

CANCELLED
BY 156 R.S. 3
PUBLIC SERVICE COMMISSION
OF MISSOURI

TELEPHONE AUTHORITY
ORDER NO. 355

DATE OF ISSUE August 1, 1960
month day year

DATE EFFECTIVE September 1, 1960
month day year

ISSUED BY H. L. Schurz
name of officer


General Manager Bucklin, Missouri
title address

~~Original~~
Revised

~~Original~~
Revised

Chariton Valley Telephone Corp.
Name of Issuing Corporation

For Bucklin, Missouri
Community Town or City
Section **RECEIVED**

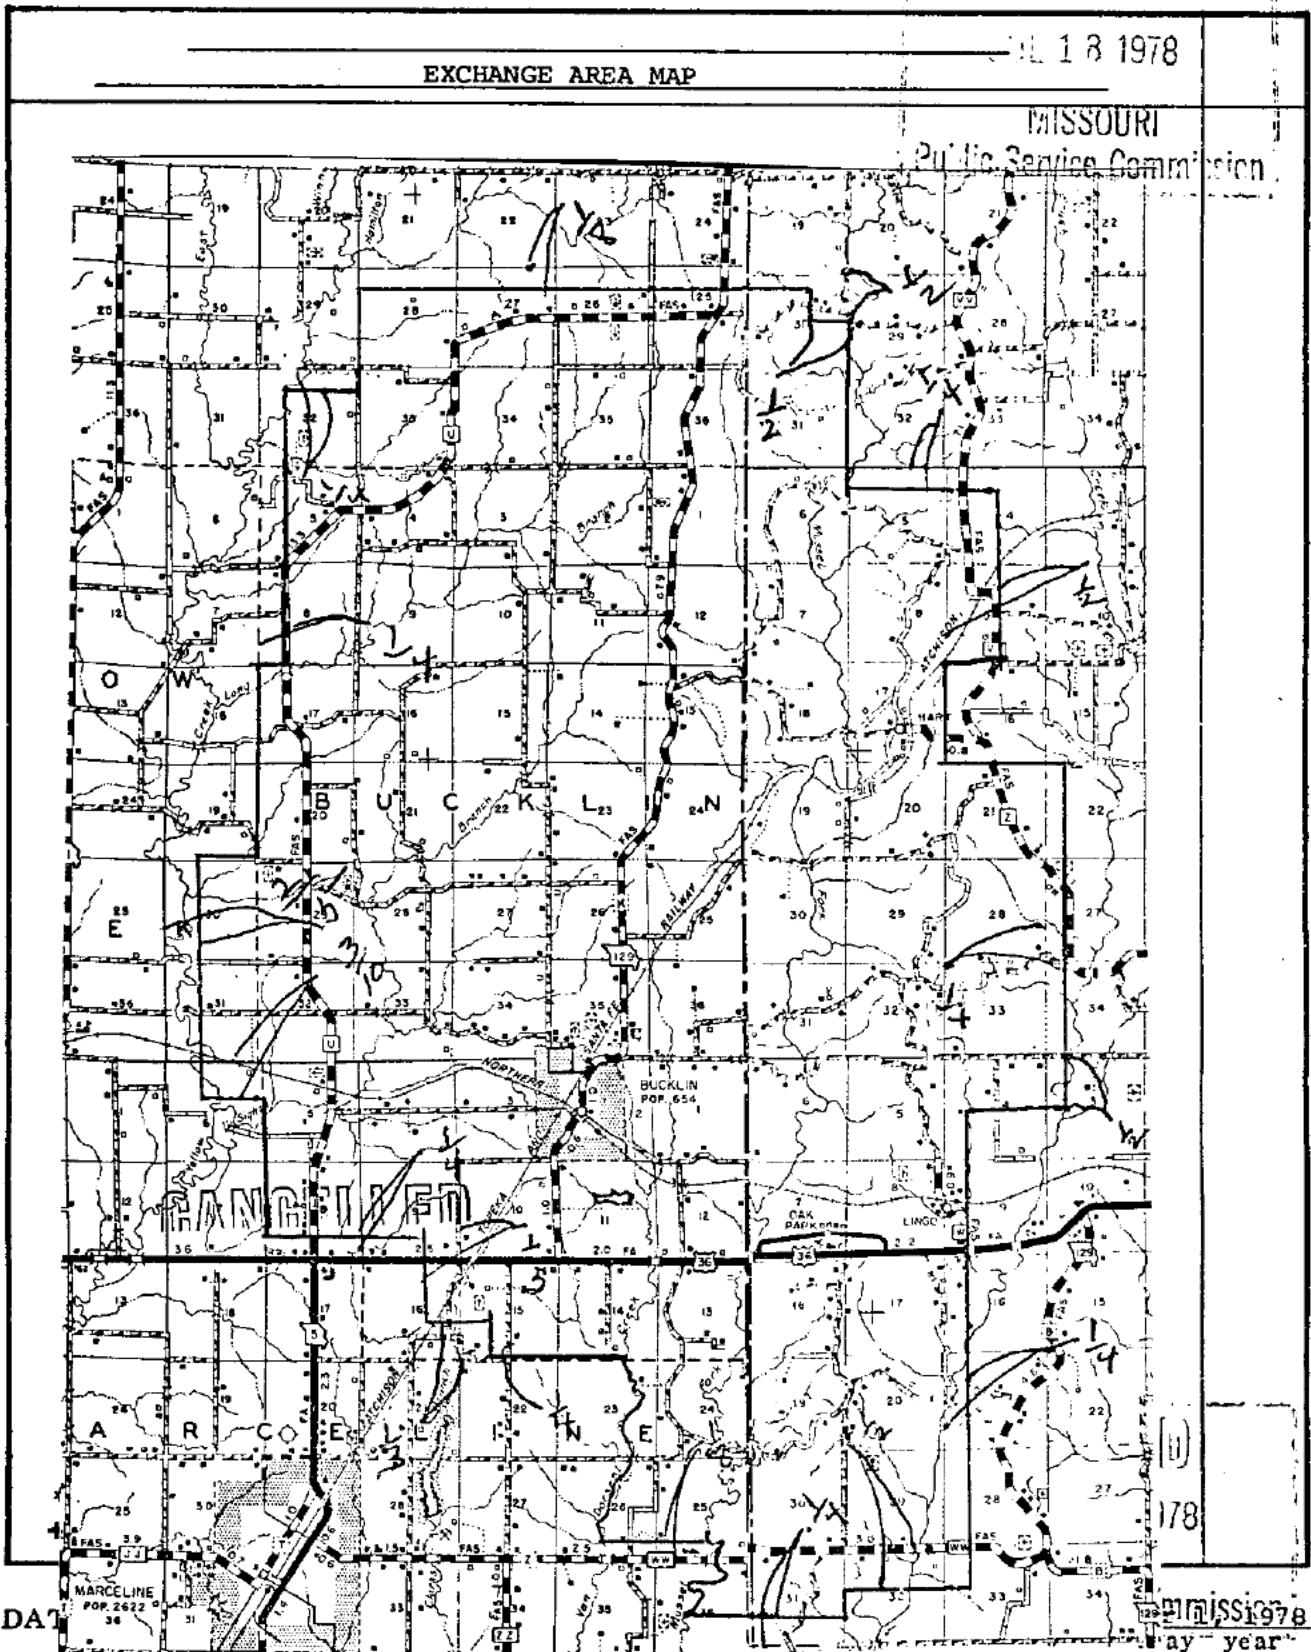

DATE

ISSUED BY Robert E. Wright General Manager Bucklin, Mo.
 name of officer title address

Chariton Valley Telephone Corporation For Bucklin, Missouri

Name of Issuing Corporation


Community, Town or City

Section 1

11262177

EXCHANGE AREA MAP

MAY 16 1975

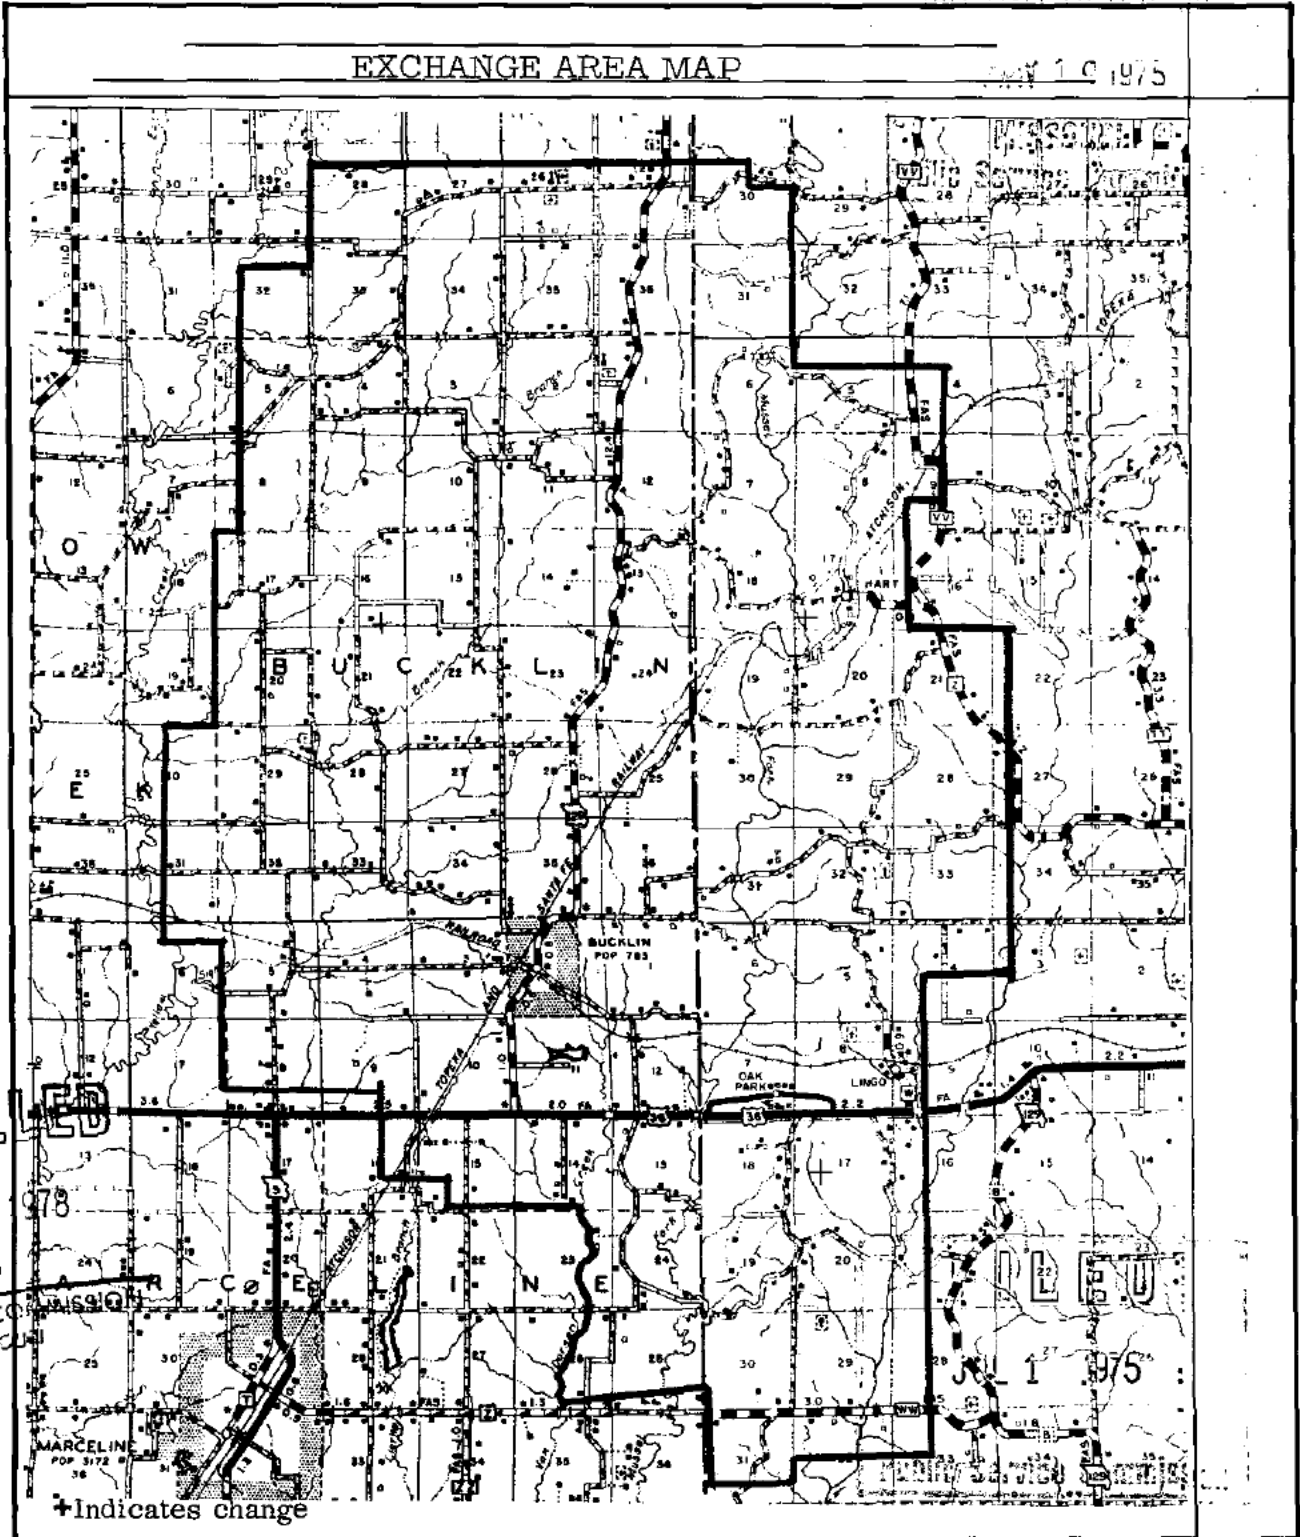

CANCELLED

SEP 1 1978

BY 9th RS3
PUBLIC SERVICE COMMISSION
OF MISSOURI

JUL 1 1975

*Indicates change

DATE OF ISSUE May 16, 1975
month day year

DATE EFFECTIVE July 1, 1975
month day year

ISSUED BY T. L. Selmon
T. L. Selmon name of officer


General Manager - Bucklin, Missouri
title address

~~Original~~
Revised
~~Original~~
Revised

Chariton Valley Telephone Corporation For
Name of Issuing Corporation or Municipality

Bynumville, Missouri
Community, Town or City

Section I

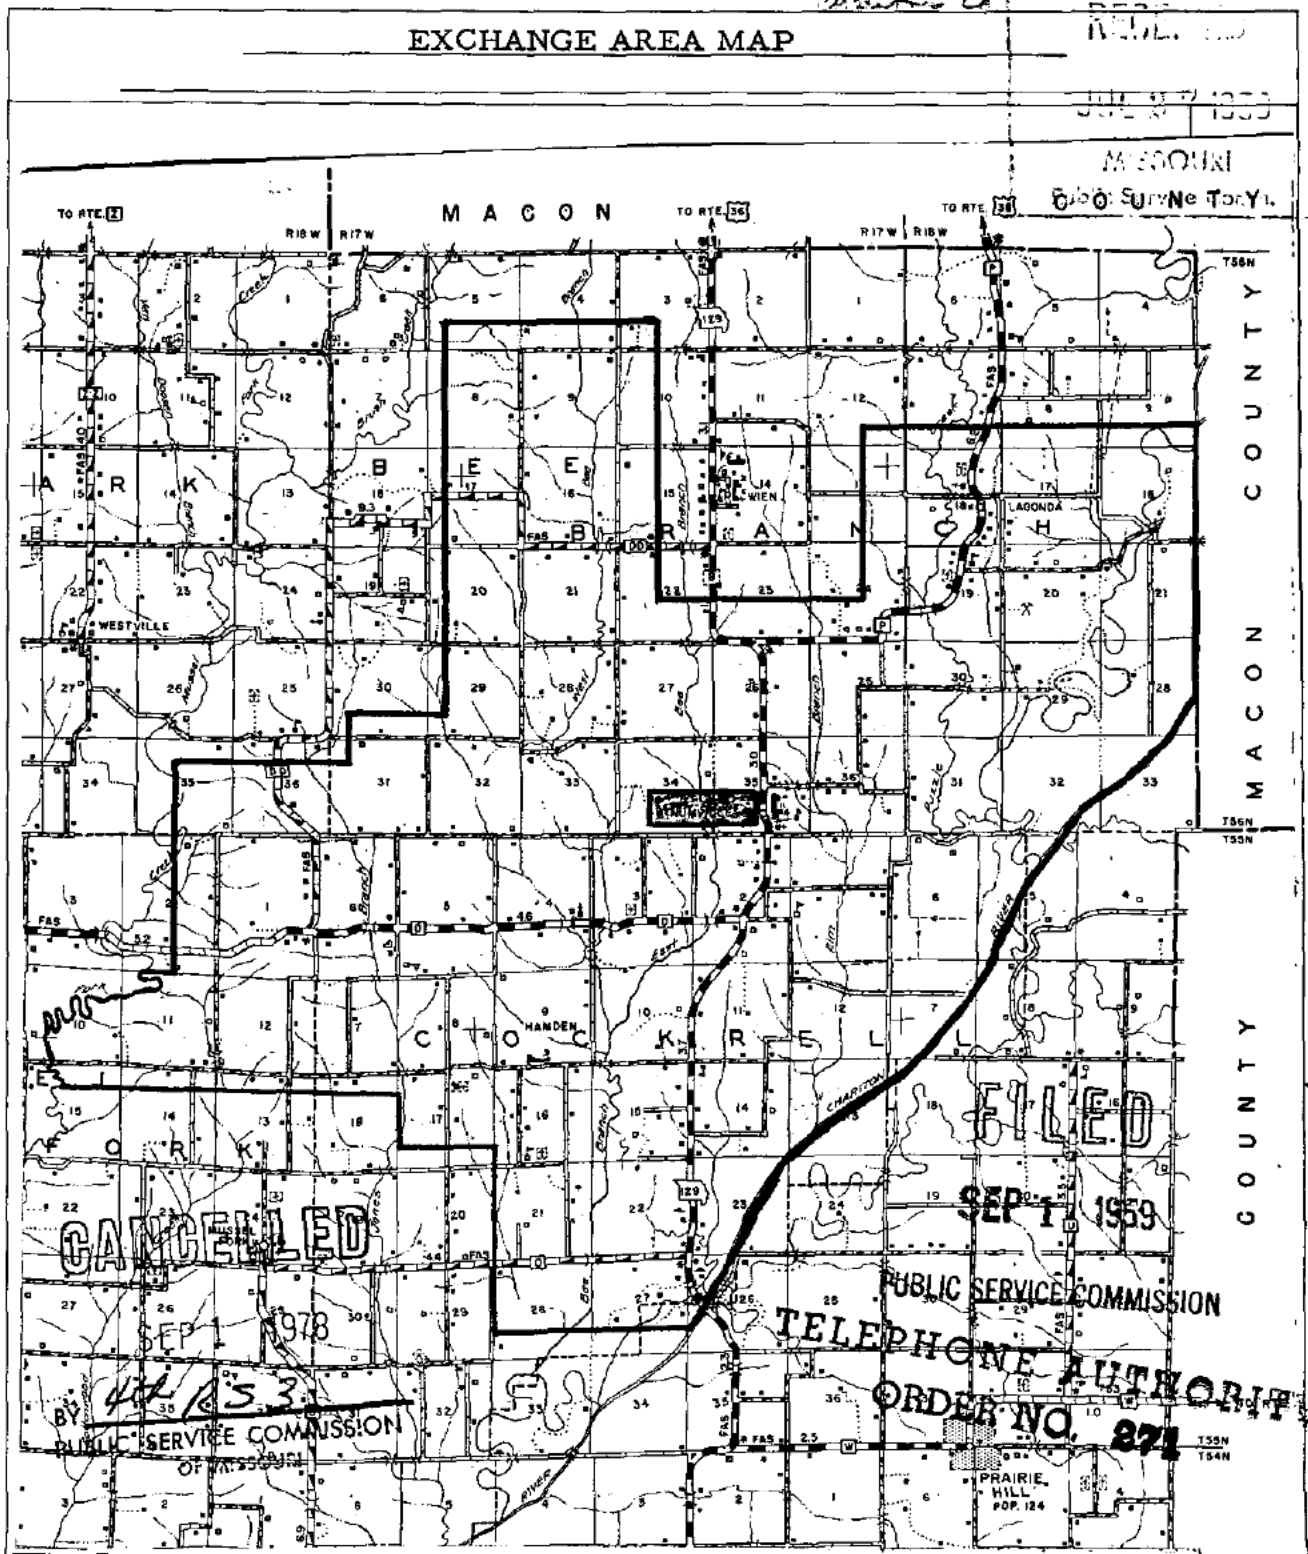

DATE OF ISSUE July 23, 1959
month day year

DATE EFFECTIVE September 1, 1959
month day year

ISSUED BY *Carl A. ...*
name of officer

General Manager Bucklin, Missouri
title address

Chariton Valley Telephone Corporation
Name of Issuing Corporation


For

Callao, Missouri
Community, Town or City

Section No. 1

Map No.

EXCHANGE AREA MAP

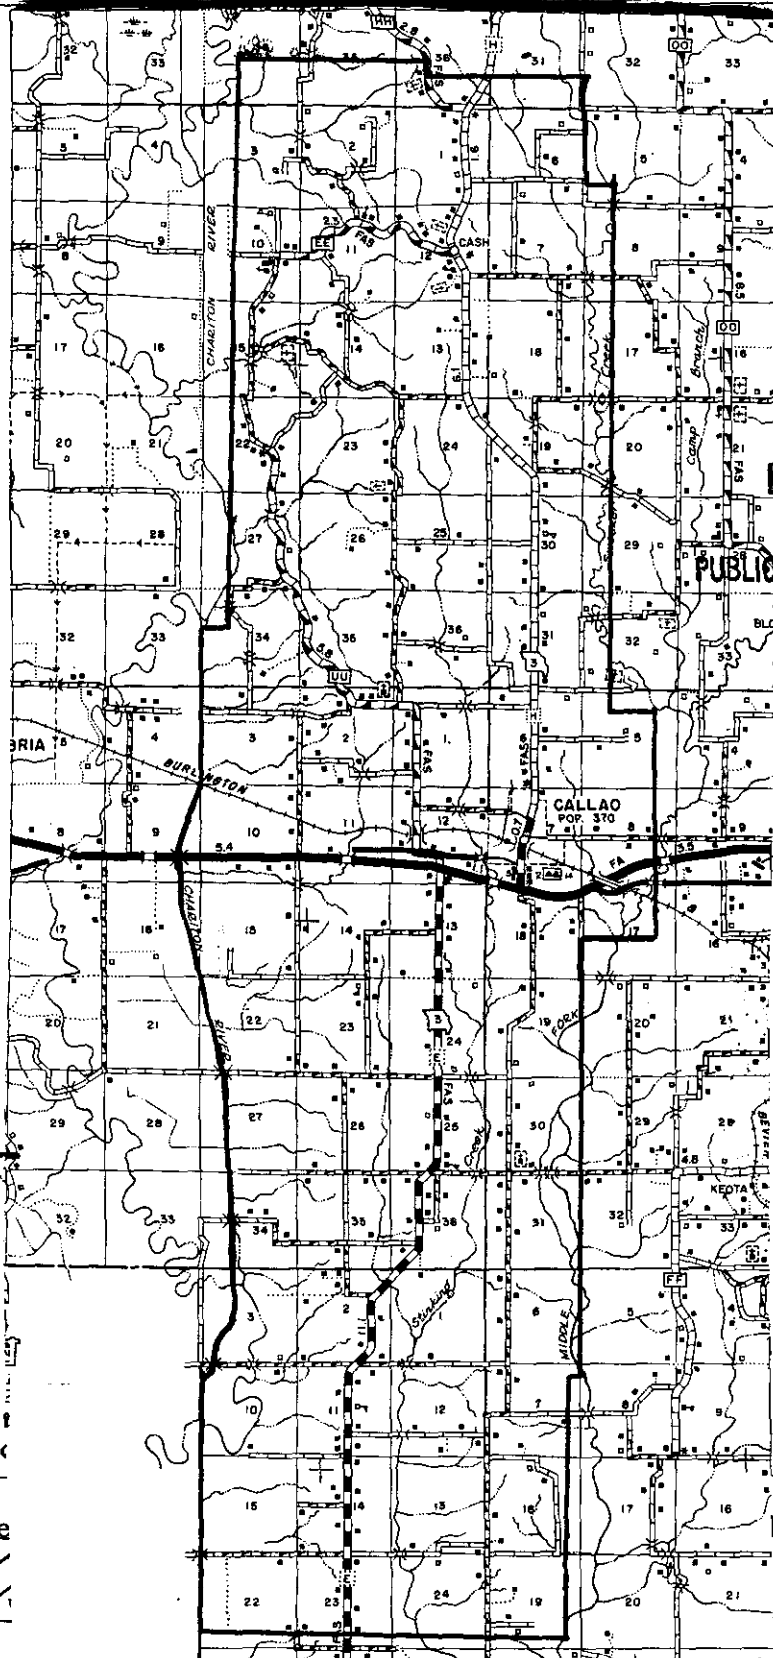

RECEIVED

OCT 4 - 1961

MISSOURI
Public Service Commission

FILED

DEC 1 - 1961

PUBLIC SERVICE COMMISSION

TELEPHONE AUTHORITY
ORDER NO. 450

CANCELLED

SEP 1 1978

BY JMR RS 3
PUBLIC SERVICE COMMISSION
OF MISSOURI

* Indicates
+ Indicates

DATE OF ISSUE See

ISSUED BY JMR

DEC 1 1961

November 5, 1961
month day year

Bucklin, Missouri
address

(Original)
(Revised)
(Original)
(Revised)

Chariton Valley Telephone Corp.
Name of Issuing Corporation

For

Clifton Hill, Missouri


Community, Town or City

Section 1

RECEIVED

EXCHANGE AREA MAP

SEP 18 1978

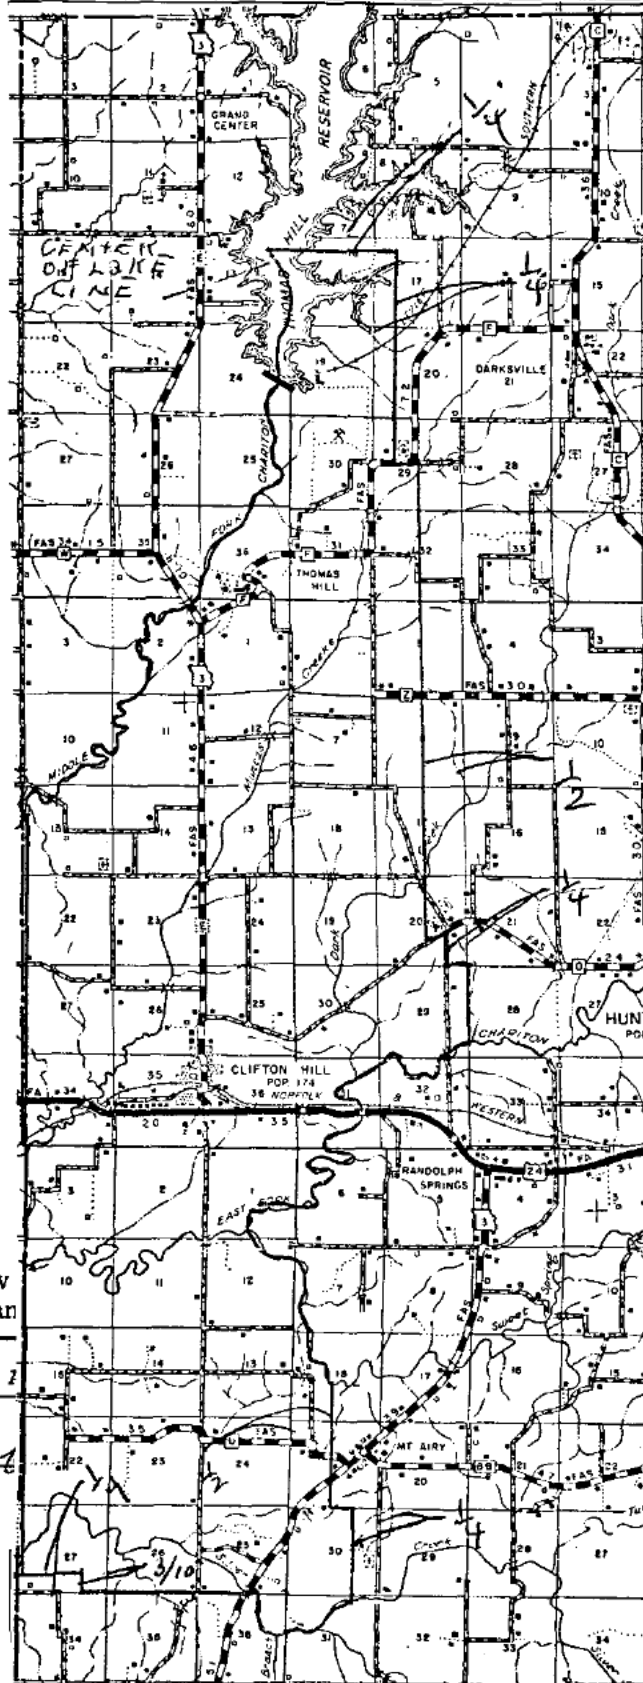

MISSOURI
Public Service Commission

*Indicates new
+Indicates chan

FILED

SEP 1 1978

Public Service Commission

DATE OF ISSUE

September 1, 1978
month day year

ISSUED BY

Rog


ucklin, Missouri
address

Chariton Valley Telephone Corporation
Name of Issuing Corporation or Municipality

For

Clifton Hill, Missouri
Community, Town or City

EXCHANGE AREA MAP

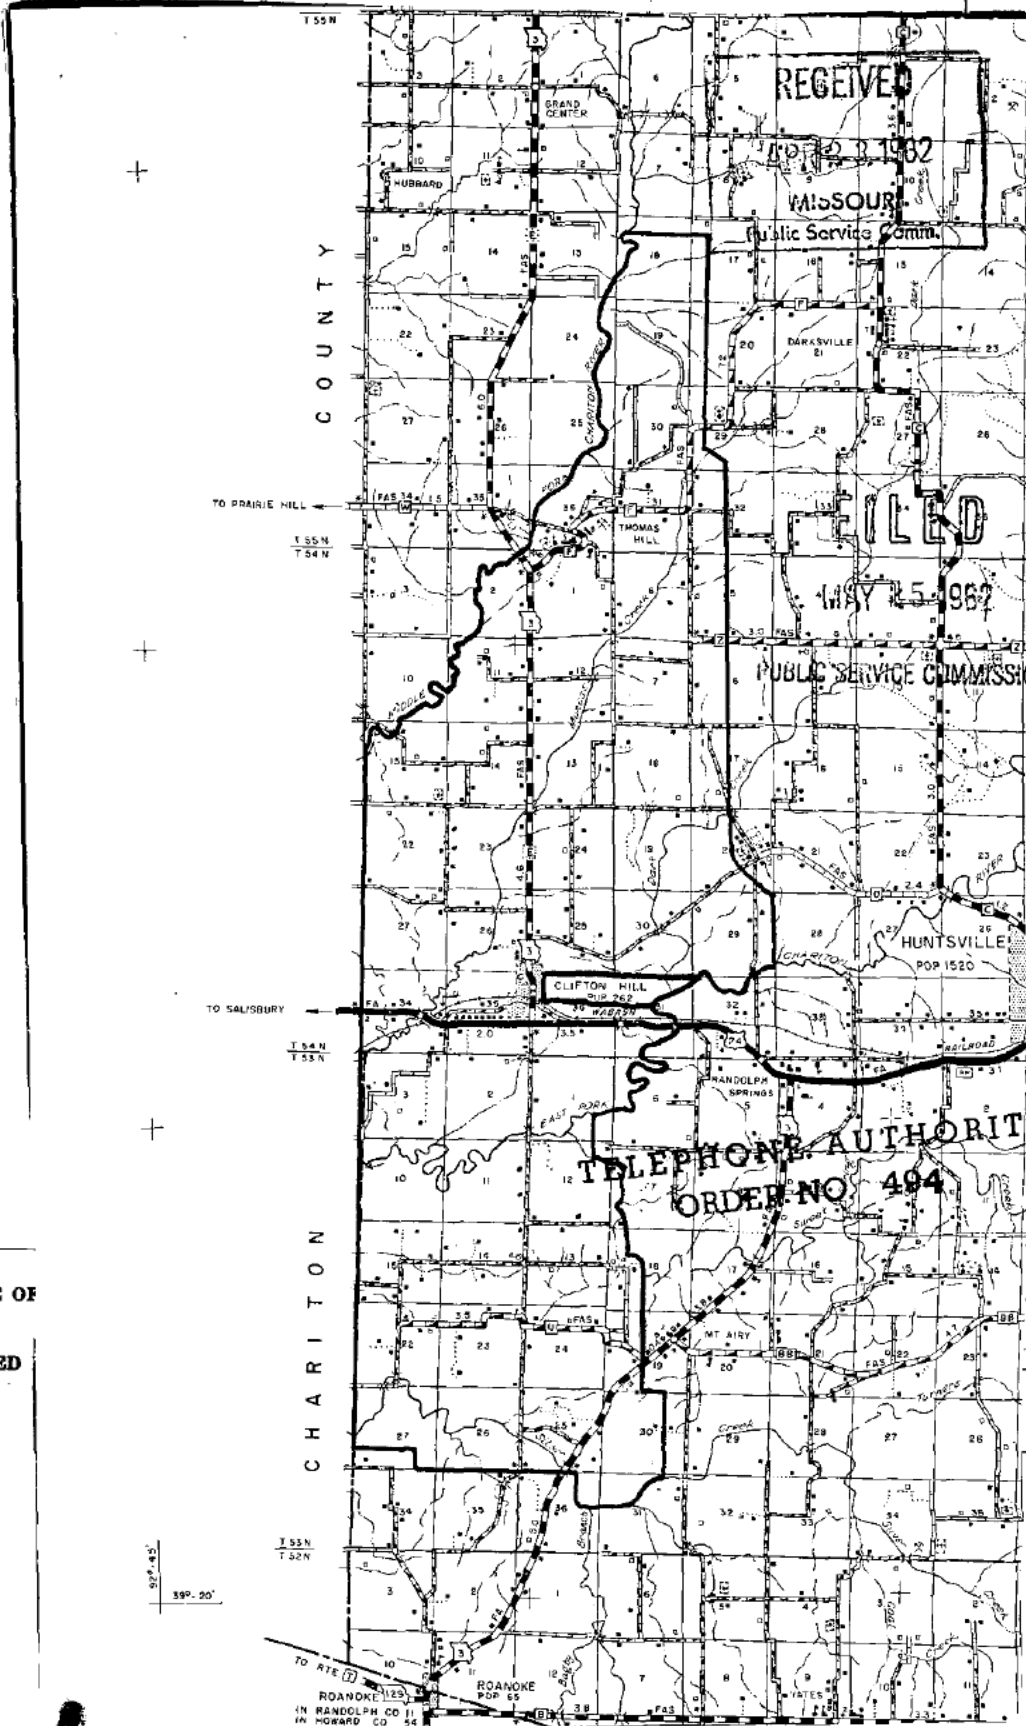

C O U N T Y

C H A R I T O N

DATE OF
ISSUED

52
ouri

{ Original }
{ Revised }
{ Original }
{ Revised }

Cancelling P.S.C.MO. No. All Previous Schedules

Chariton Valley Telephone Corporation For DeWitt, Missouri

Name of Issuing Corporation

Community, Town or City


Section 1

RECEIVED

EXCHANGE AREA MAP

NOV 29 1971

Public Service Commission

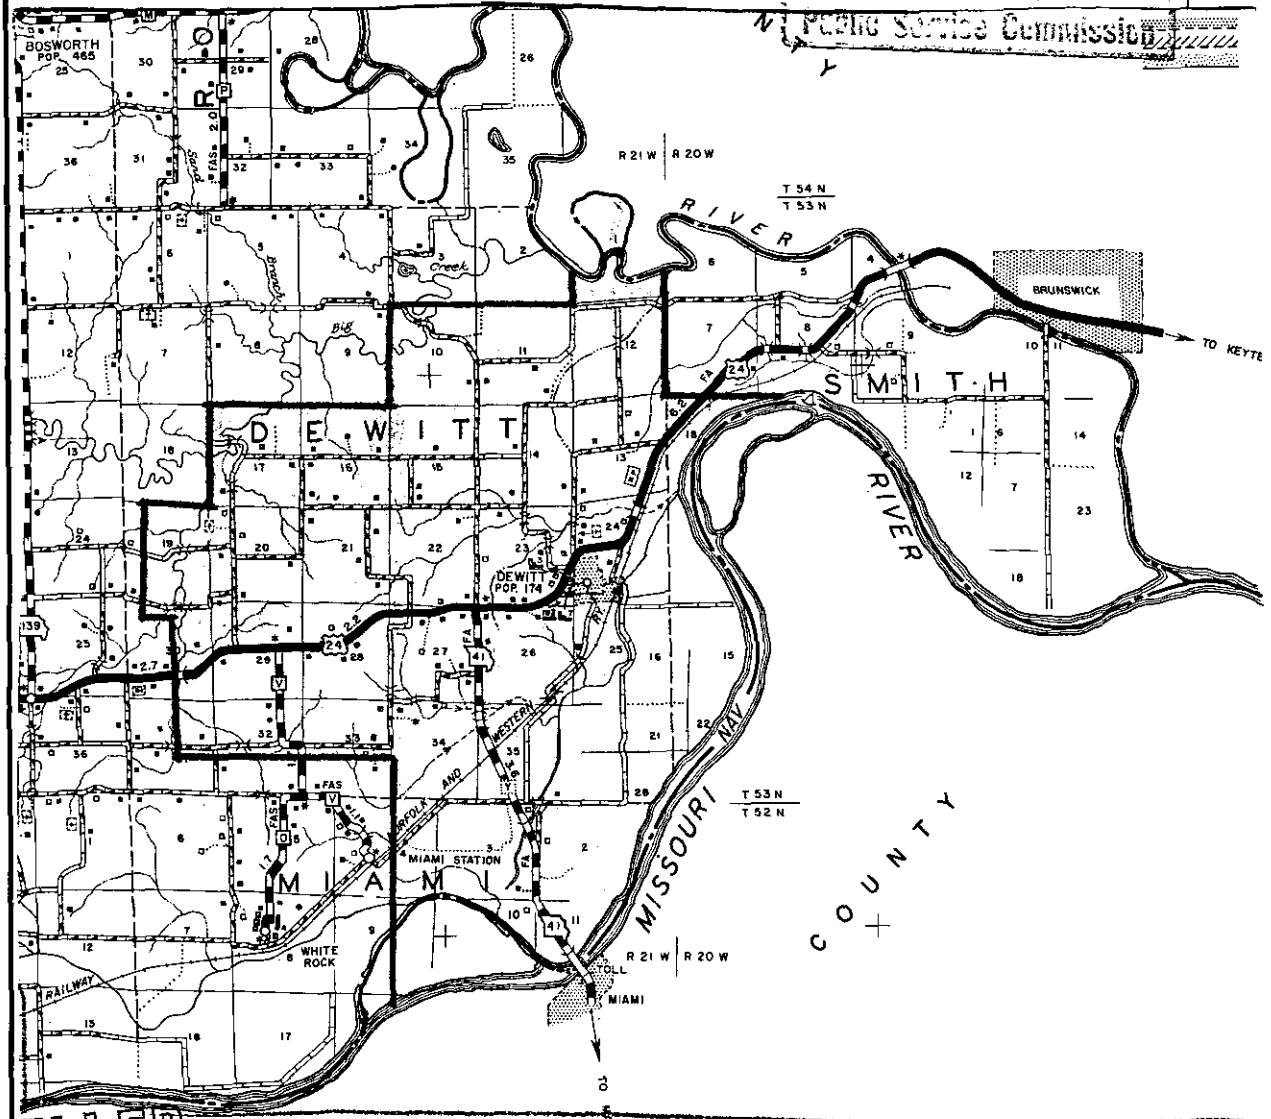

CANCELLED

SEP 1 1978

BY 2nd RS 3

PUBLIC SERVICE COMMISSION OF MISSOURI
* Indicates new rate or text
+ Indicates change

FILED
JAN 1 1972
Public Service Commission

DATE OF ISSUE December 1 1971
month day year

DATE EFFECTIVE January 1 1972
month day year

ISSUED BY *H. Schum*
name of officer

General Manager Bucklin Mo.
title address

Chariton Valley Telephone Corporation
Name of Issuing Corporation

For Ethel, Missouri
Community, Town or City

Section 1


RECEIVED

MAR 14 1968

MISSOURI

Public Service Comm.

AREA EXCHANGE MAP

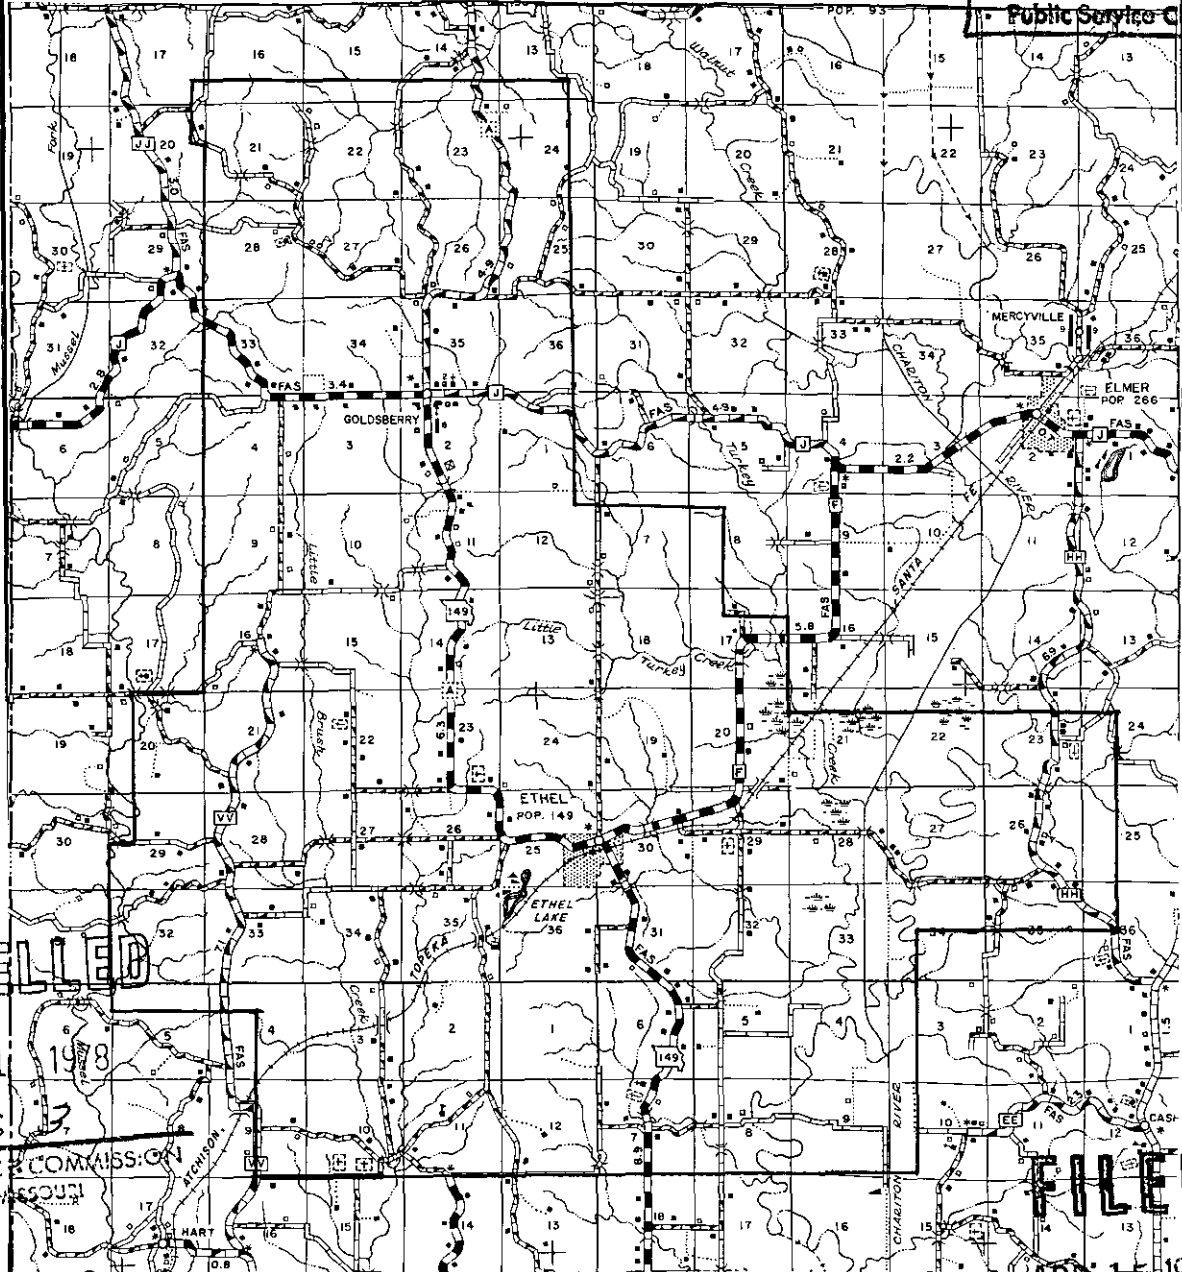

CANCELLED

SEP 1 1968

BY 3rd RS. [Signature]
PUBLIC SERVICE COMMISSION
OF MISSOURI

FILED

APR 15 1968

* Indicates new rate or text
+ Indicates change

PUBLIC SERVICE COMMISSION

DATE OF ISSUE March 15, 1968
month day year


DATE EFFECTIVE April 15, 1968
month day year

ISSUED BY [Signature]
name of officer

General Manager Bucklin, Mo.
title address

Chariton Valley Telephone Corporation For Excello, Missouri
Name of Issuing Corporation Community, Town or City

EXCHANGE AREA MAP	REVISED
	JAN 15 1963
	MISSOURI Public Service Comm.

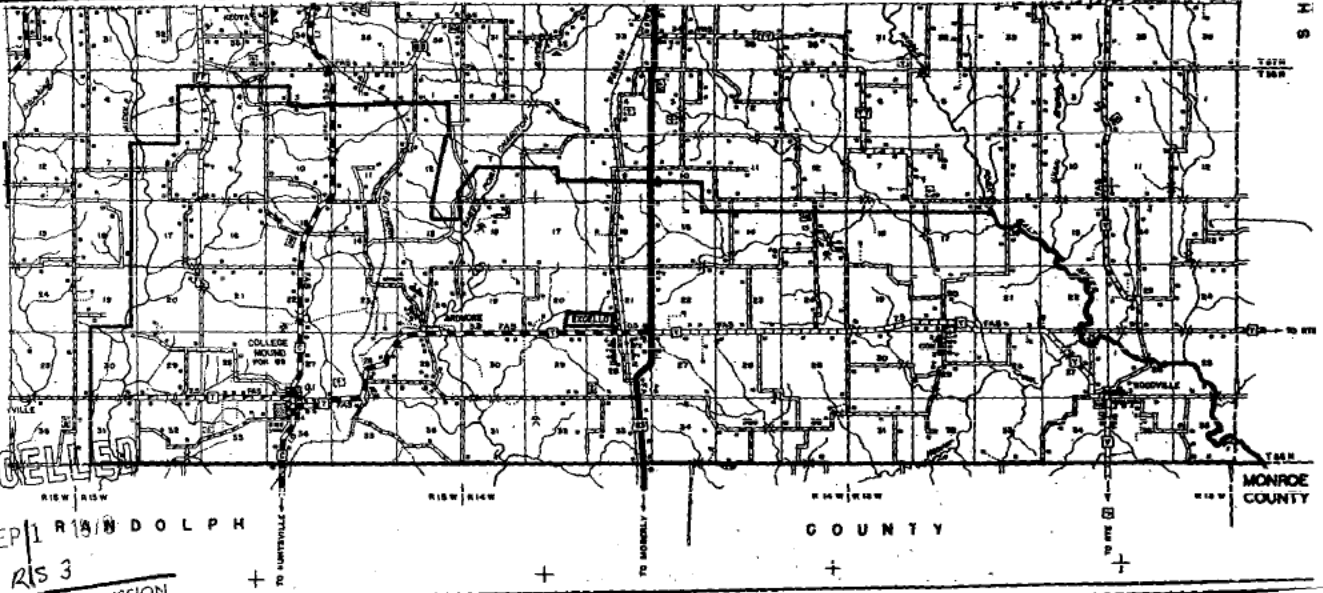

CANCELLED

SEP 1 1963
BY 1st RIS 3
PUBLIC SERVICE COMMISSION
OF MISSOURI

STATE OF MISSOURI PUBLIC SERVICE COMMISSION CASE NO. <u>15.101</u>
--

FILED

JAN 15 1963

PUBLIC SERVICE COMMISSION

* Indicates new rate or text
+ Indicates change

DATE OF ISSUE January 10, 1963
month day year

DATE EFFECTIVE February 15, 1963
month day year

ISSUED BY T. L. Selmon
name of officer

General Manager Bucklin, Mo.
title address

Chariton Valley Telephone Corp.
Name of Issuing Corporation


For Forest Green, Missouri
Community, Town or City

Section 1 RECEIVED

EXCHANGE AREA MAP

AUG 1 1978

MISSOURI
Public Service Commission

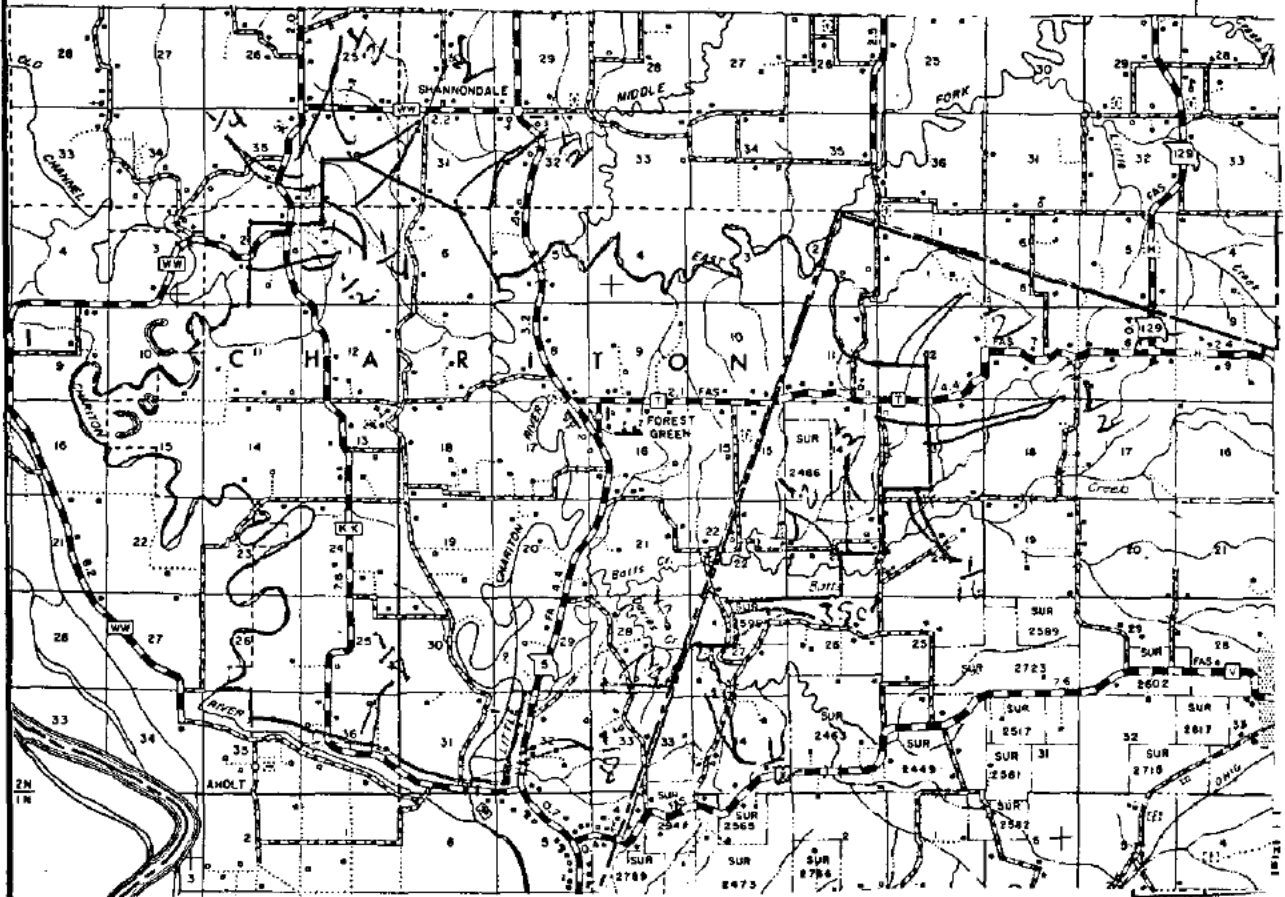

CANCELLED

FILED

SEP 1 1978

*Indicates new rate or text
+Indicates change

MAY 24 1994
BY *gnd R.S.H.3*
Public Service Commission
MISSOURI

Public Service Commission

DATE OF ISSUE August 1, 1978
month day year

DATE EFFECTIVE Sept. 1, 1978
month day year

ISSUED BY *Robert E. Wright*
name of officer

General Manager

Bucklin, Missouri

title


address

Chariton Valley Telephone Corporation
Name of Issuing Corporation or Municipality

For Forrest Green, Missouri
Community, Town or City

Section 1

EXCHANGE AREA MAP

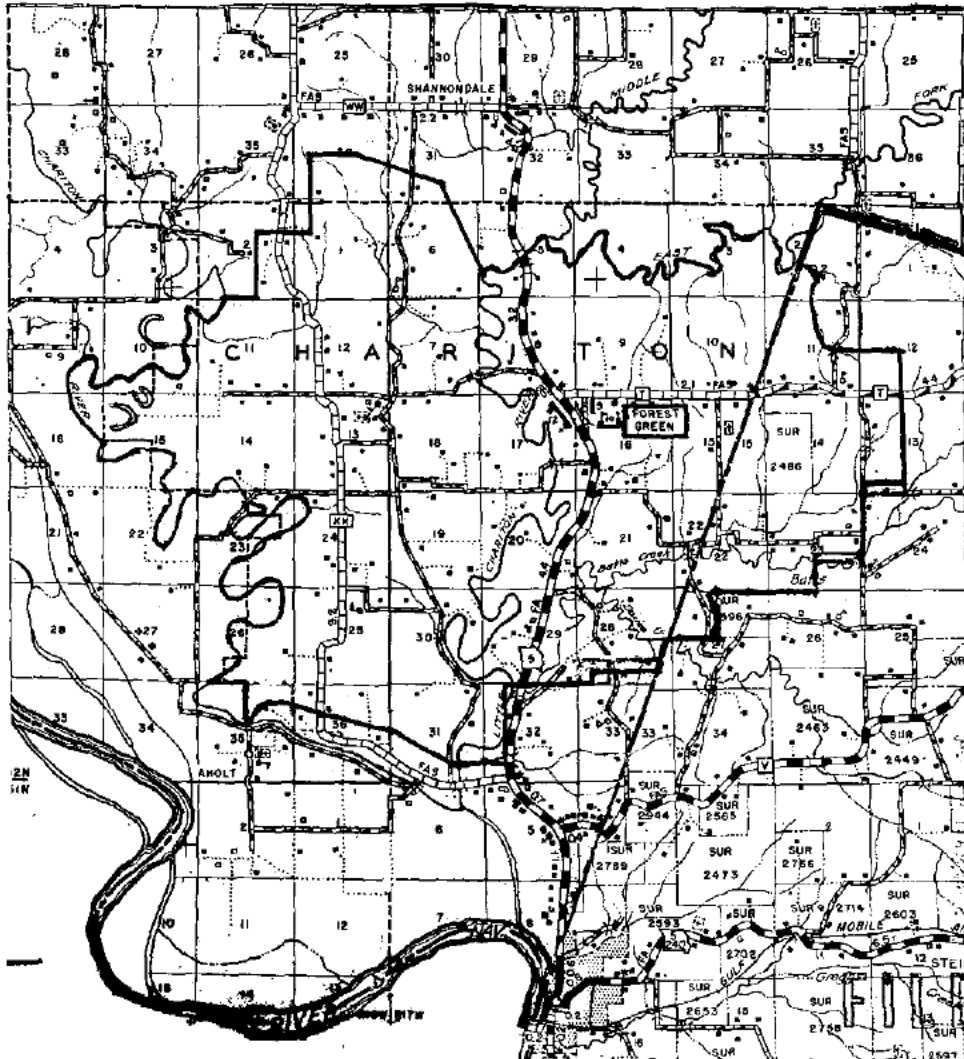

CANCELLED

SER 1 1978

BY 1st RS 3
PUBLIC SERVICE COMMISSION
OF MISSOURI

STATE OF MISSOURI
PUBLIC SERVICE COMMISSION
CASE NO. 14.887

JUN 1 - 1962

PUBLIC SERVICE COMMISSION

JUN 1 - 1962

DATE OF ISSUE May 22, 1962
~~September 28, 1961~~
month day year

DATE EFFECTIVE June 28, 1962
~~November 5, 1961~~
month day year

ISSUED BY J. H. Schuman
name of officer

General Manager Bucklin, Missouri
title address

Chariton Valley Telephone Corporation
Name of Issuing Corporation or Municipality

For

Hale, Missouri

Community, Town or City


Case 1

EXCHANGE AREA MAP

RECEIVED

MAY 31 1962

MISSOURI
Public Service Comm.

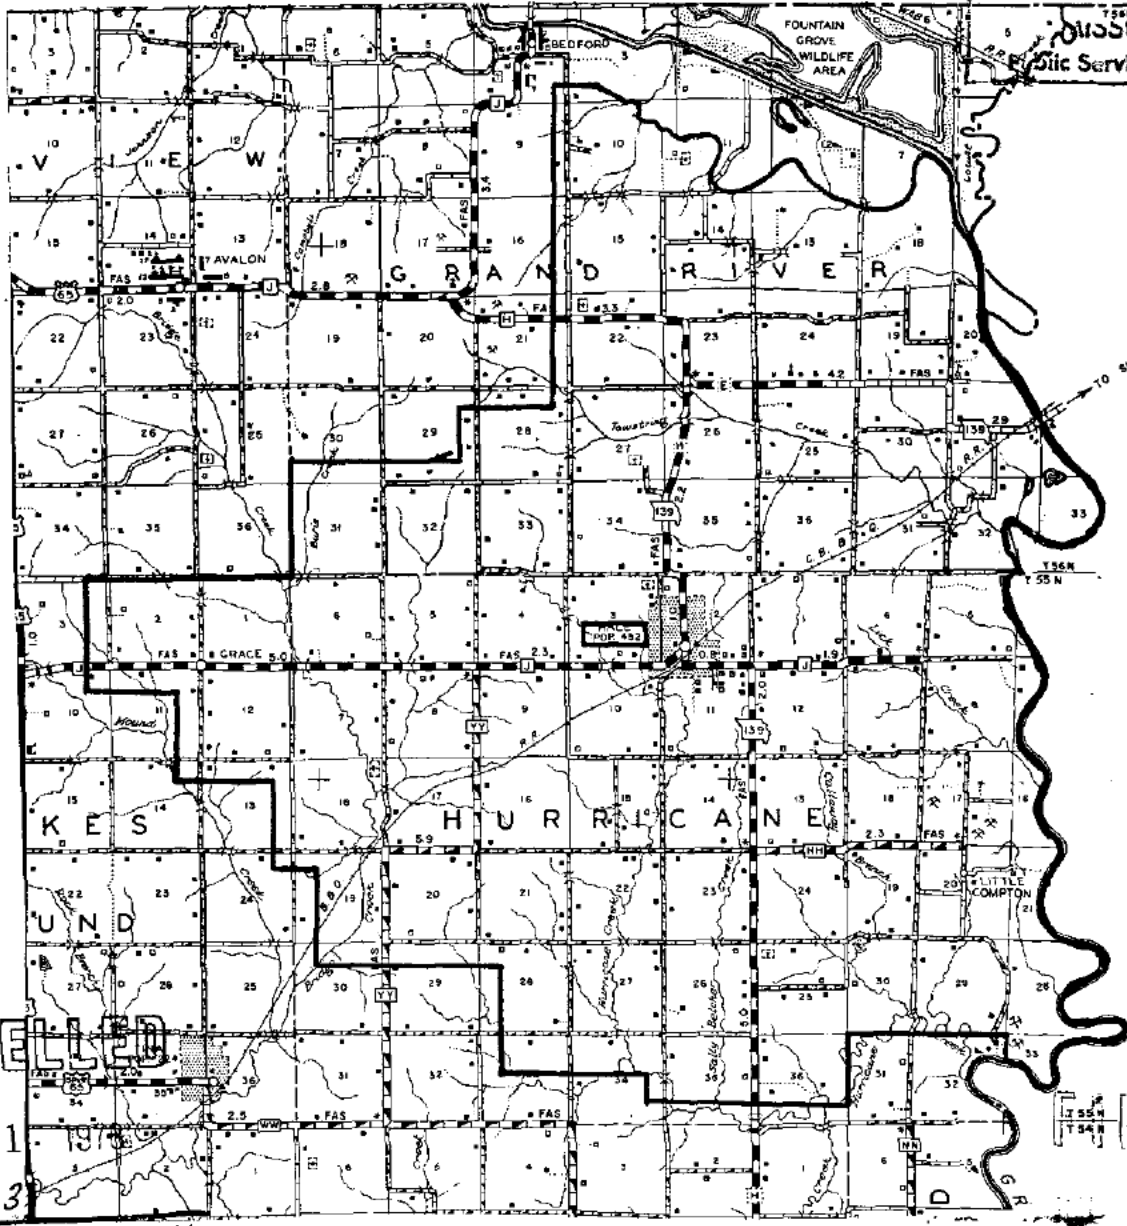

STATE OF MISSOURI
PUBLIC SERVICE COMMISSION
CASE NO. 14,859

CANCELLED

SEP 1 1962

BY 1st RS 3
PUBLIC SERVICE COMMISSION
OF MISSOURI REISSUE

Effective 4/1/62 in P. S. C. Mo. No. 3 2nd RS No 9

DATE OF ISSUE May 29, 1962
month day year

DATE EFFECTIVE July 3, 1962
month day year

ISSUED BY [Signature]
name of officer

General Manager, Bucklin, Missouri
title address

Original
Revised

Original
Revised


Chariton Valley Telephone Corp.
Name of Issuing Corporation

For Huntsville, Missouri
Community, Town or City
Section 1

JUL 16 1978

EXCHANGE AREA MAP

MISSOURI

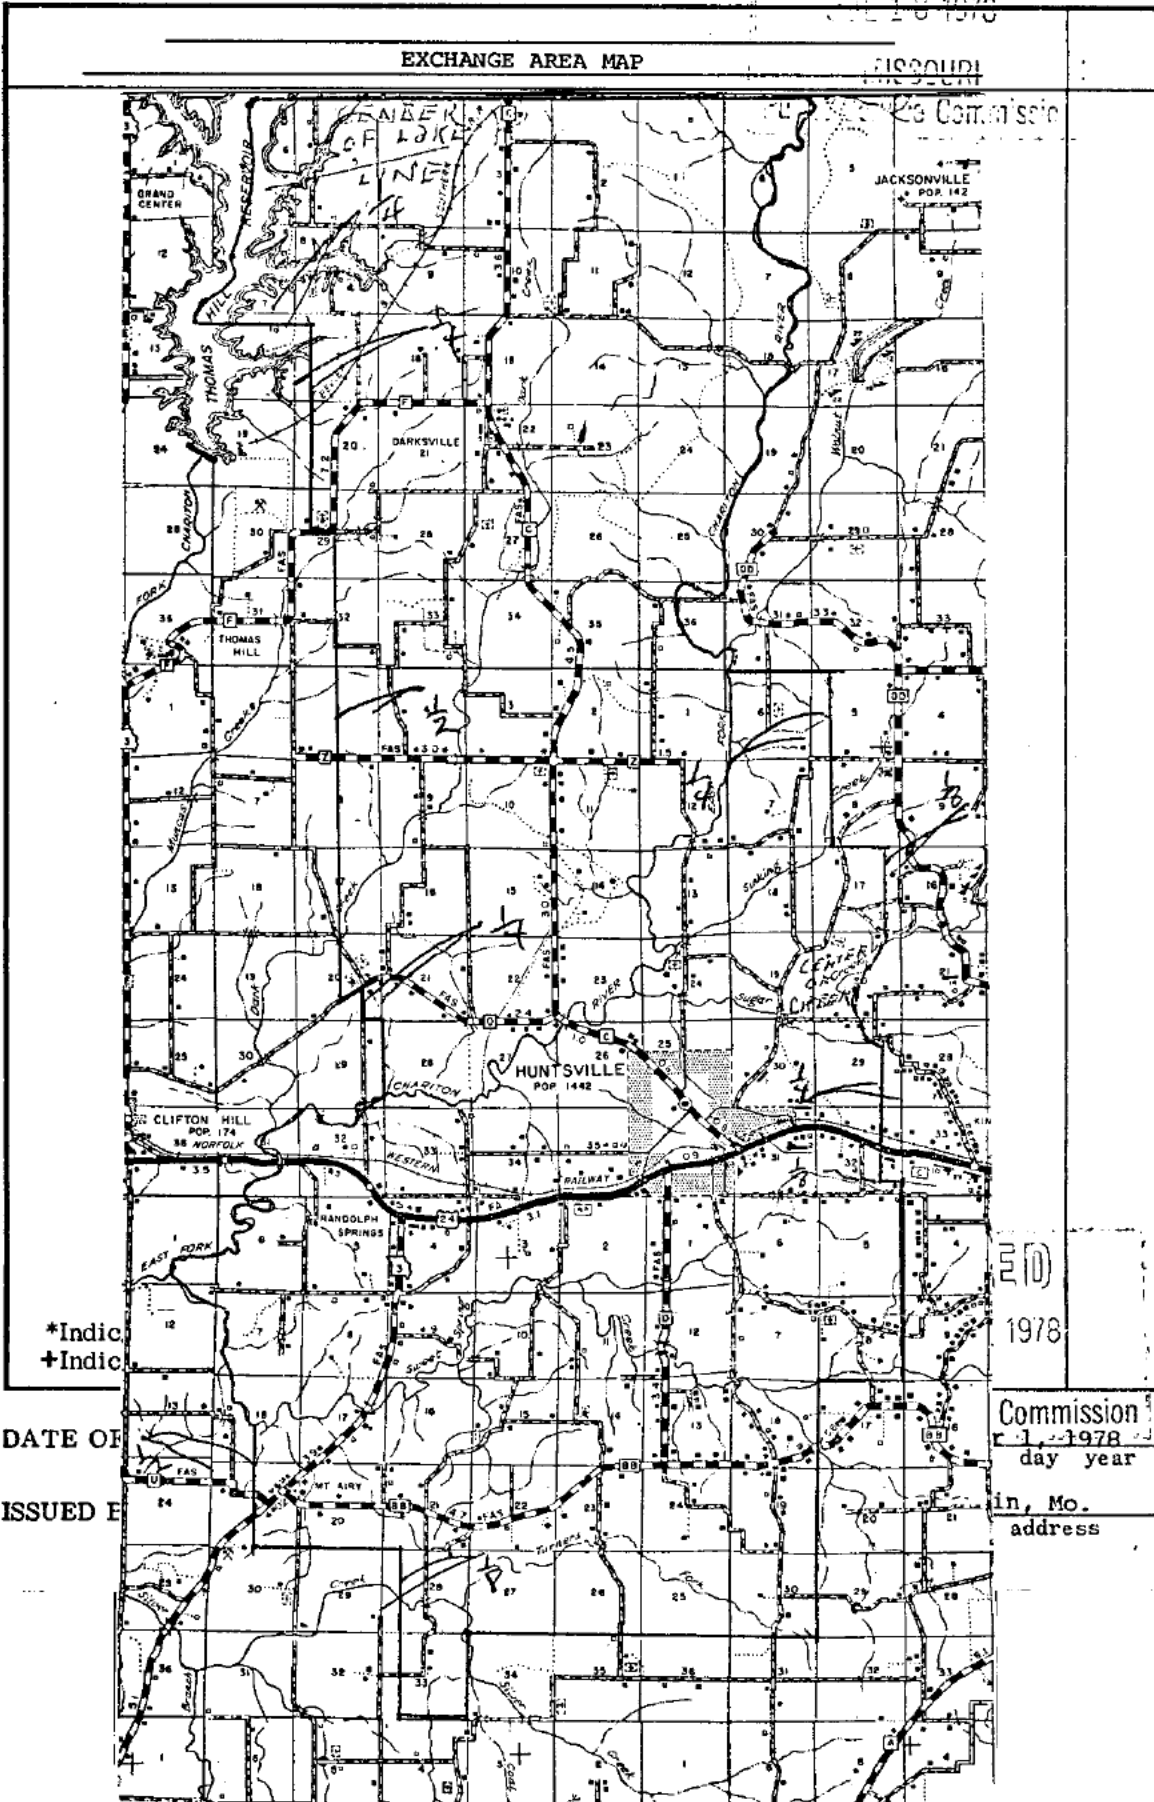


Chariton Valley Telephone Corporation
Name of Issuing Corporation or Municipality

For New Cambria, Missouri
Community, Town or City

Section I

EXCHANGE AREA MAP

AUG 12 1960

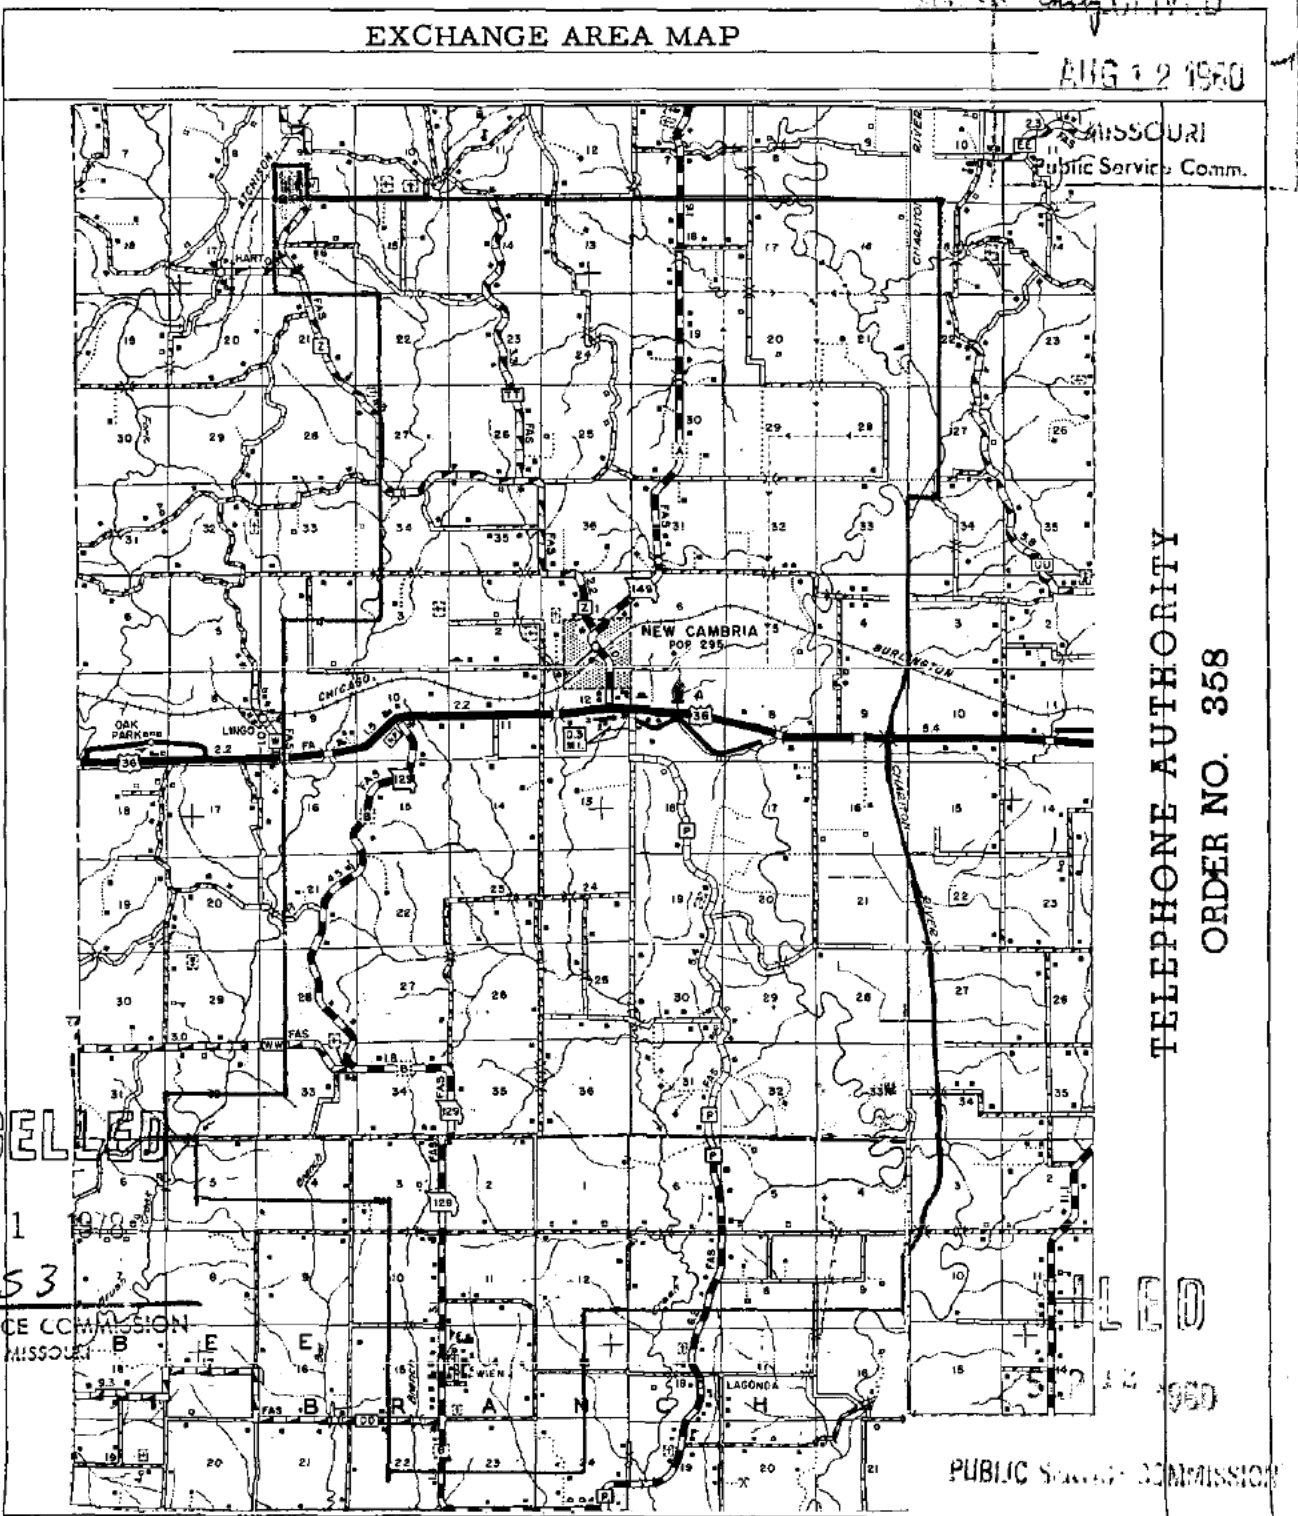

TELEPHONE AUTHORITY
ORDER NO. 358

CANCELLED

SEP 1 1978

BY 314RS3
PUBLIC SERVICE COMMISSION
OF MISSOURI

PUBLIC SERVICE COMMISSION

DATE OF ISSUE August 1, 1960

month day year

DATE EFFECTIVE September 12, 1960

month day year

ISSUED BY

J. H. Schuman
name of officer

General Manager
title

Bucklin, Missouri
address

Chariton Valley Telephone Corporation For Huntsville, Missouri
Name of Issuing Corporation or Municipality Community, Town or City


Randolph County

EXCHANGE AREA MAP

RECEIVED

MAR 15 1962

MISSOURI
Public Service Comm.

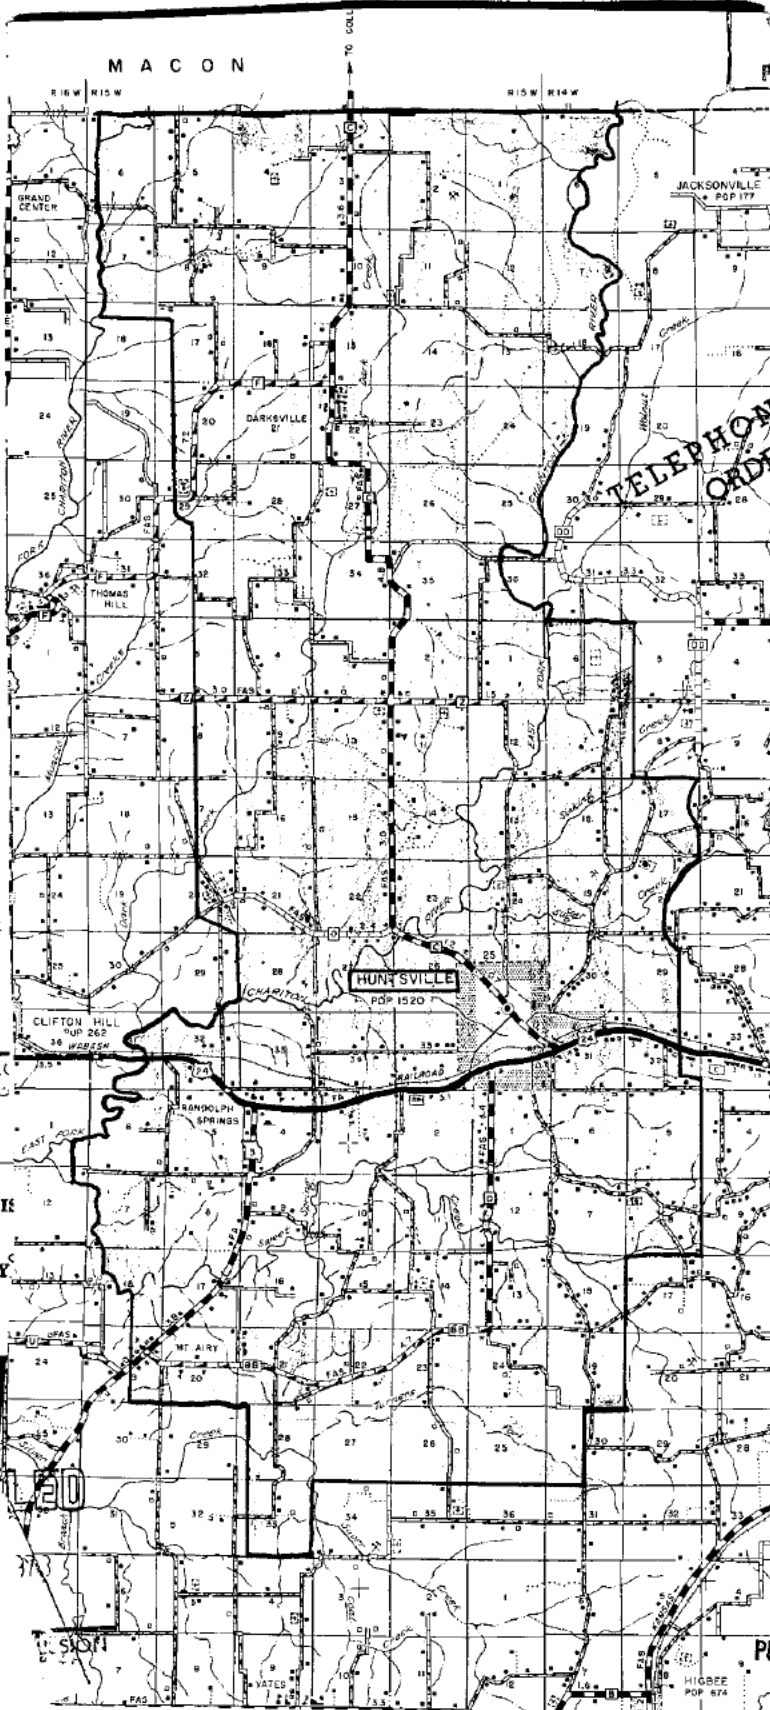

TELEPHONE AUTHORITY
ORDER NO. 481

CANCEL

SEP 1

BY PUBLIC SERVICE COMMISSION
Of MISSOURI

FILED

APR 15 1962

PUBLIC SERVICE COMMISSION

DATE OF ISSUE

15, 1962
day year

ISSUED BY

Bucklin, Missouri
address


LEO

PU

Chariton Valley Telephone Corporation
Name of Issuing Corporation or Municipality

For Jacksonville, Missouri
Community, Town or City

Section I

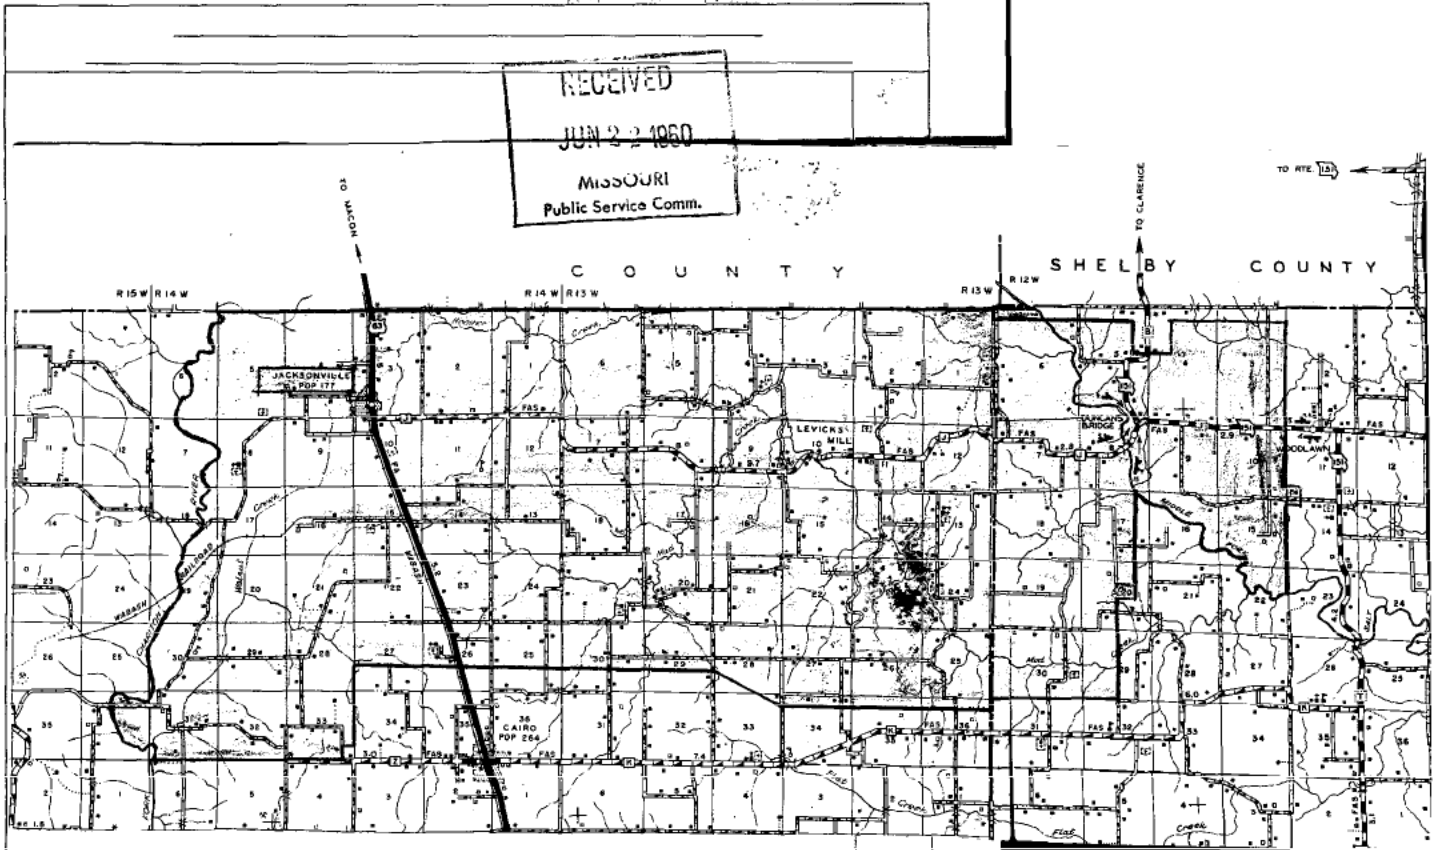

CANCELLED

SEP 1 1978

BY 2nd R53 TELEPHONE AUTHORITY
PUBLIC SERVICE COMMISSION OF MISSOURI

ORDER NO. 344

FILED

JUN 22 1960

PUBLIC SERVICE COMMISSION

DATE OF ISSUE June 22 ~~May 20~~ 1960
month day year

DATE EFFECTIVE July 22 ~~May 23~~ 1960
month day year

ISSUED BY J. P. Selmer name of officer General Manager title Bucklin, Missouri address

Chariton Valley Telephone Corporation
Name of Issuing Corporation


For New Boston, Missouri
Community, Town or City

Section I

EXCHANGE AREA MAP

RECEIVED
OCT 4 - 1961

MISSOURI
PUBLIC SERVICE COMMISSION

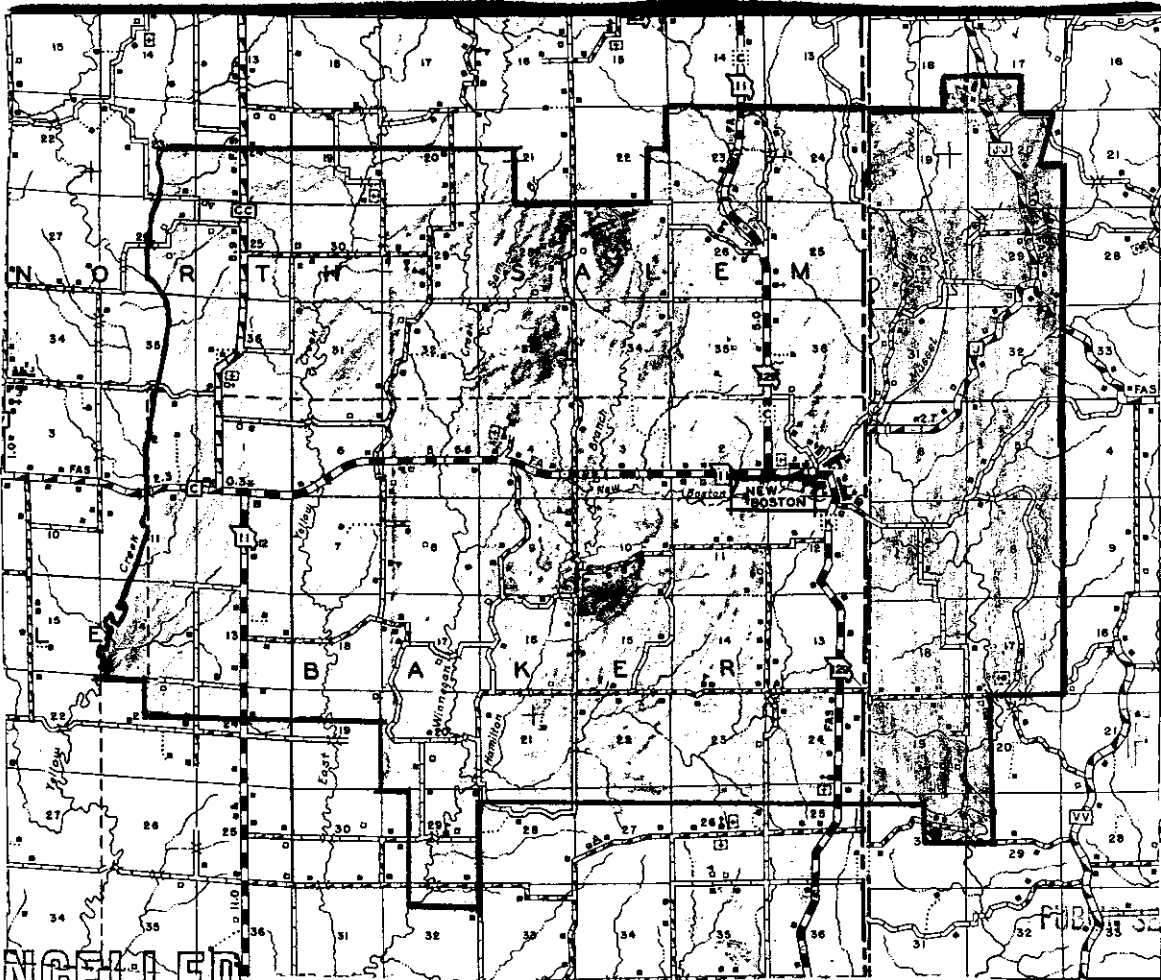

CANCELLED

SEP 1 1978

BY 2nd RS3

PUBLIC SERVICE COMMISSION
* Indicates new rate or text
+ Indicates change

TELEPHONE AUTHORITY
ORDER NO. 450

DATE OF ISSUE September 28, 1961
month day year

DATE EFFECTIVE DEC 1 - 1961
month day year


ISSUED BY J. L. Schma
name of officer

General Manager Bucklin, Missouri
title address

Chariton Valley Telephone Corporation For Prairie Hill, Missouri
Name of Issuing Corporation Community, Town or City

Section I

EXCHANGE AREA MAP

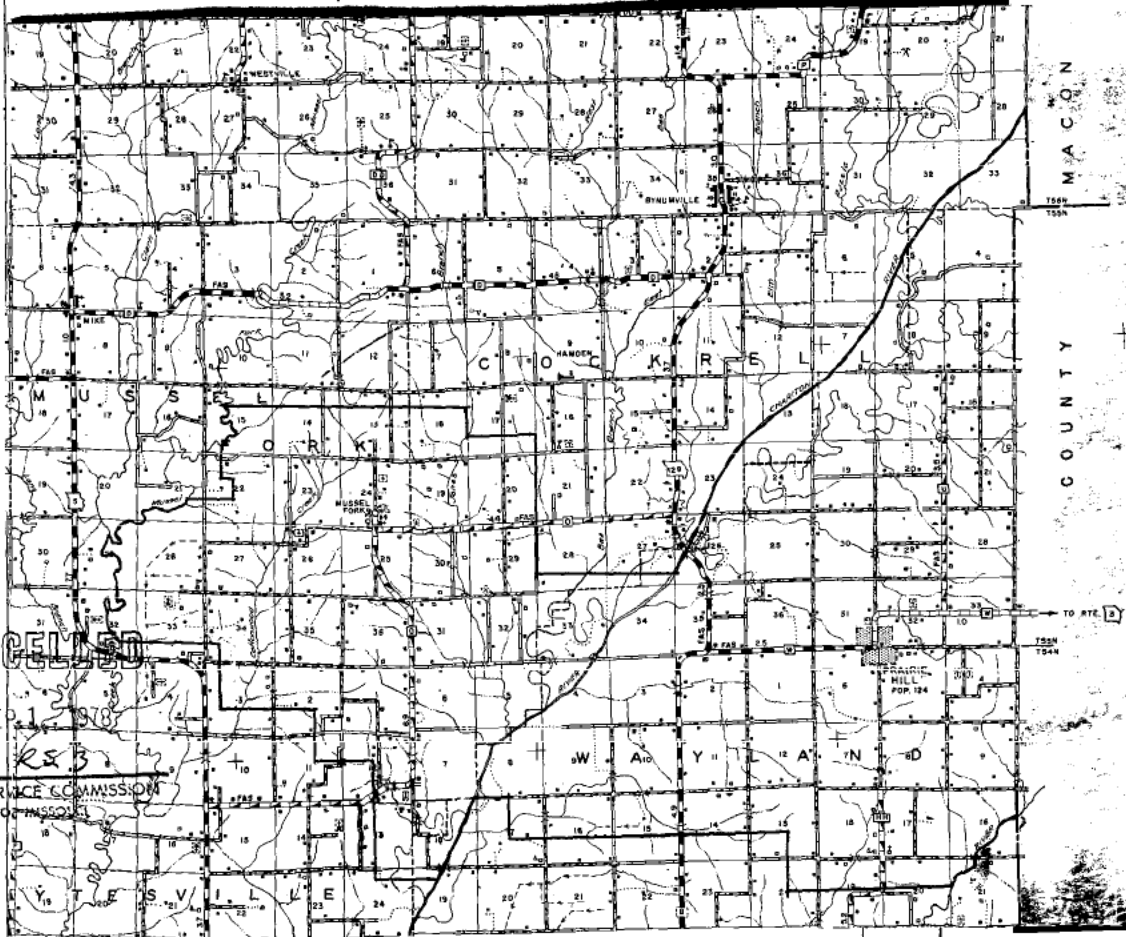

CANCELLED
 SEP 1 1963
 BY 502 RSB
 PUBLIC SERVICE COMMISSION
 MISSOURI

* Indicates new rate or text
 + Indicates change

Delayed filing


DATE OF ISSUE July 9, 1963
month day year

DATE EFFECTIVE August 16, 1963
month day year

ISSUED BY T. L. Selmon
T. L. Selmon of officer

General Manager Bucklin, Missouri
title address

Chariton Valley Telephone Corp. For Prairie Hill, Missouri
Name of Issuing Corporation Community, Town or City
Section 45061V(20)

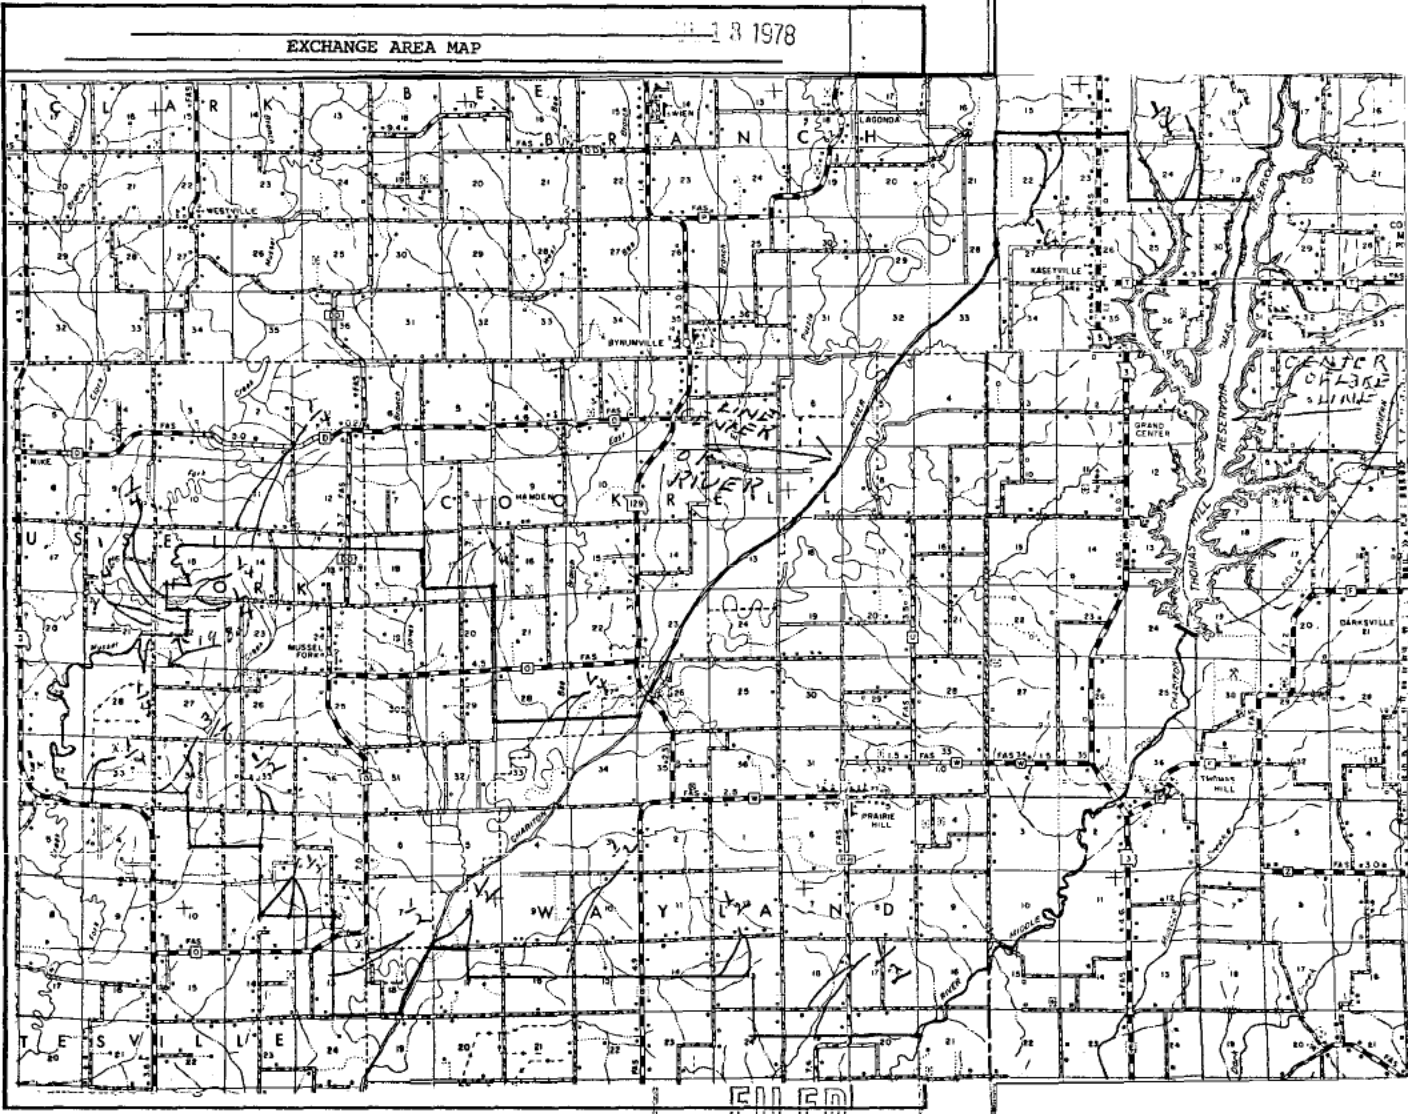

DATE OF ISSUE August 1, 1978 DATE EFFECTIVE Sept. 1, 1978
month day year month day year


ISSUED BY Robert E. Wright General Mgr. Bucklin, Mo.
name of officer title Public Service Commission

Chariton Valley Telephone Corporation
Name of Issuing Corporation or Municipality

For

Salisbury, Missouri
Community, Town or City

EXCHANGE AREA MAP

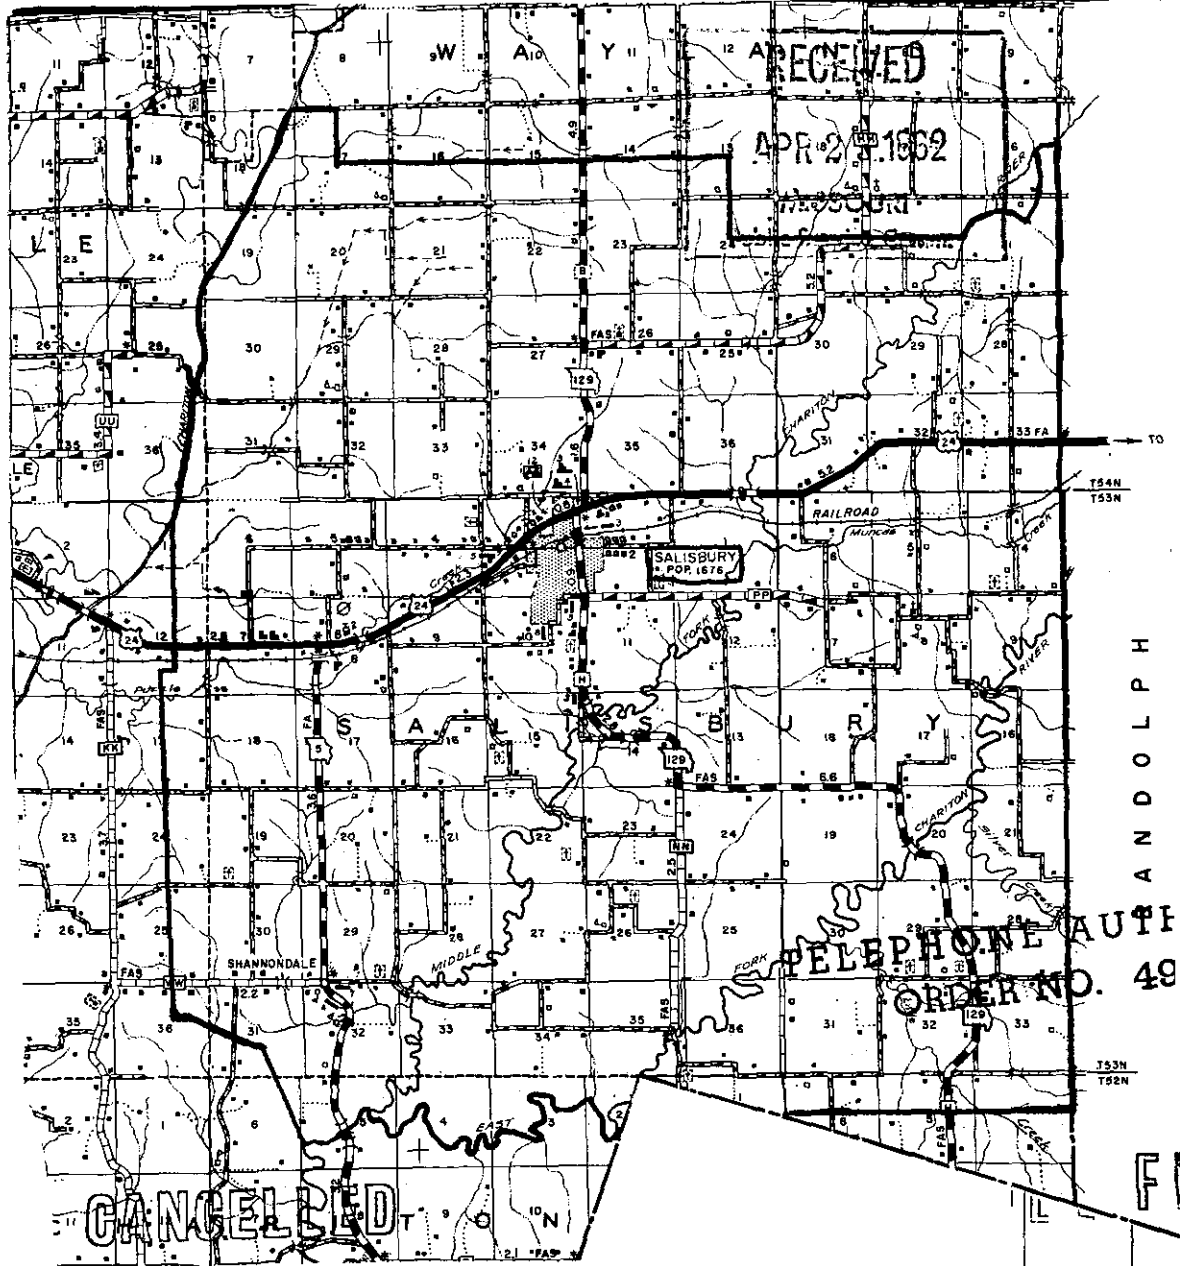

SEP 1 1978

MAY 25 1962

BY 312 RS 3
PUBLIC SERVICE COMMISSION

PUBLIC SERVICE COMMISSION

DATE OF ISSUE April 18 1962
month day year

DATE EFFECTIVE May 25 1962
month day year

ISSUED BY T. L. Selmon
name of officer

General Manager, Bucklin, Missouri
title address