

ARRAY SUMMARY

DC SYSTEM SIZE:	1,065.600 [kW-DC (STC)]
AC SYSTEM SIZE:	942.000 [KW-AC]
MODULES:	(2,880) GCL-M6/72H 370W MODULE
INVERTERS:	(7) SOLECTRIA PVI-60TL-480
	(9) SOLECTRIA PVI-50TL-480
	(2) SOLECTRIA PVI-36TL-480
STRINGS:	(160) STRINGS OF (18) MODULES
RACKING:	(80) SOLAR FLEX RACK G3L-X 4HX9
TILT ANGLE:	25°

SUB-ARRAY 1: WEST

DC SYSTEM SIZE:	412.920 [kW-DC (STC)]
AC SYSTEM SIZE:	340.000 [KW-AC]
MODULES:	(1,116) GCL-M6/72H 370W MODULE
INVERTERS:	(4) SOLECTRIA PVI-60TL-480
	(2) SOLECTRIA PVI-50TL-480
STRINGS:	(62) STRINGS OF (18) MODULES
RACKING:	(31) SOLAR FLEX RACK G3L-X 4HX9
AZIMUTH:	202°

SUB-ARRAY 2: CENTRAL


DC SYSTEM SIZE:	399.600 [kW-DC (STC)]
AC SYSTEM SIZE:	372.000 [KW-AC]
MODULES:	(1,080) GCL-M6/72H 370W MODULE
INVERTERS:	(6) SOLECTRIA PVI-50TL-480
	(2) SOLECTRIA PVI-36TL-480
STRINGS:	(60) STRINGS OF (18) MODULES
RACKING:	(30) SOLAR FLEX RACK G3L-X 4HX9
AZIMUTH:	165.5°, 202°

SUB-ARRAY 3: EAST




DC SYSTEM SIZE:	253.080 [kW-DC (STC)]
AC SYSTEM SIZE:	230.000 [KW-AC]
MODULES:	(684) GCL-M6/72H 370W MODULE
INVERTERS:	(3) SOLECTRIA PVI-60TL-480
	(1) SOLECTRIA PVI-50TL-480
STRINGS:	(38) STRINGS OF (18) MODULES
RACKING:	(19) SOLAR FLEX RACK G3L-X 4HX9
AZIMUTH:	175°

SHEET LEGEND

	NEW FENCE
	SUB-ARRAY
	EXISTING OVERHEAD POWER
	PROPERTY LINE
	PROPERTY LINE SETBACK
	EXISTING GRAVEL ROADWAY
	FABRIC AND ROCK
	LAYDOWN AREA
	MEDIUM VOLTAGE CONDUCTOR BY OTHERS

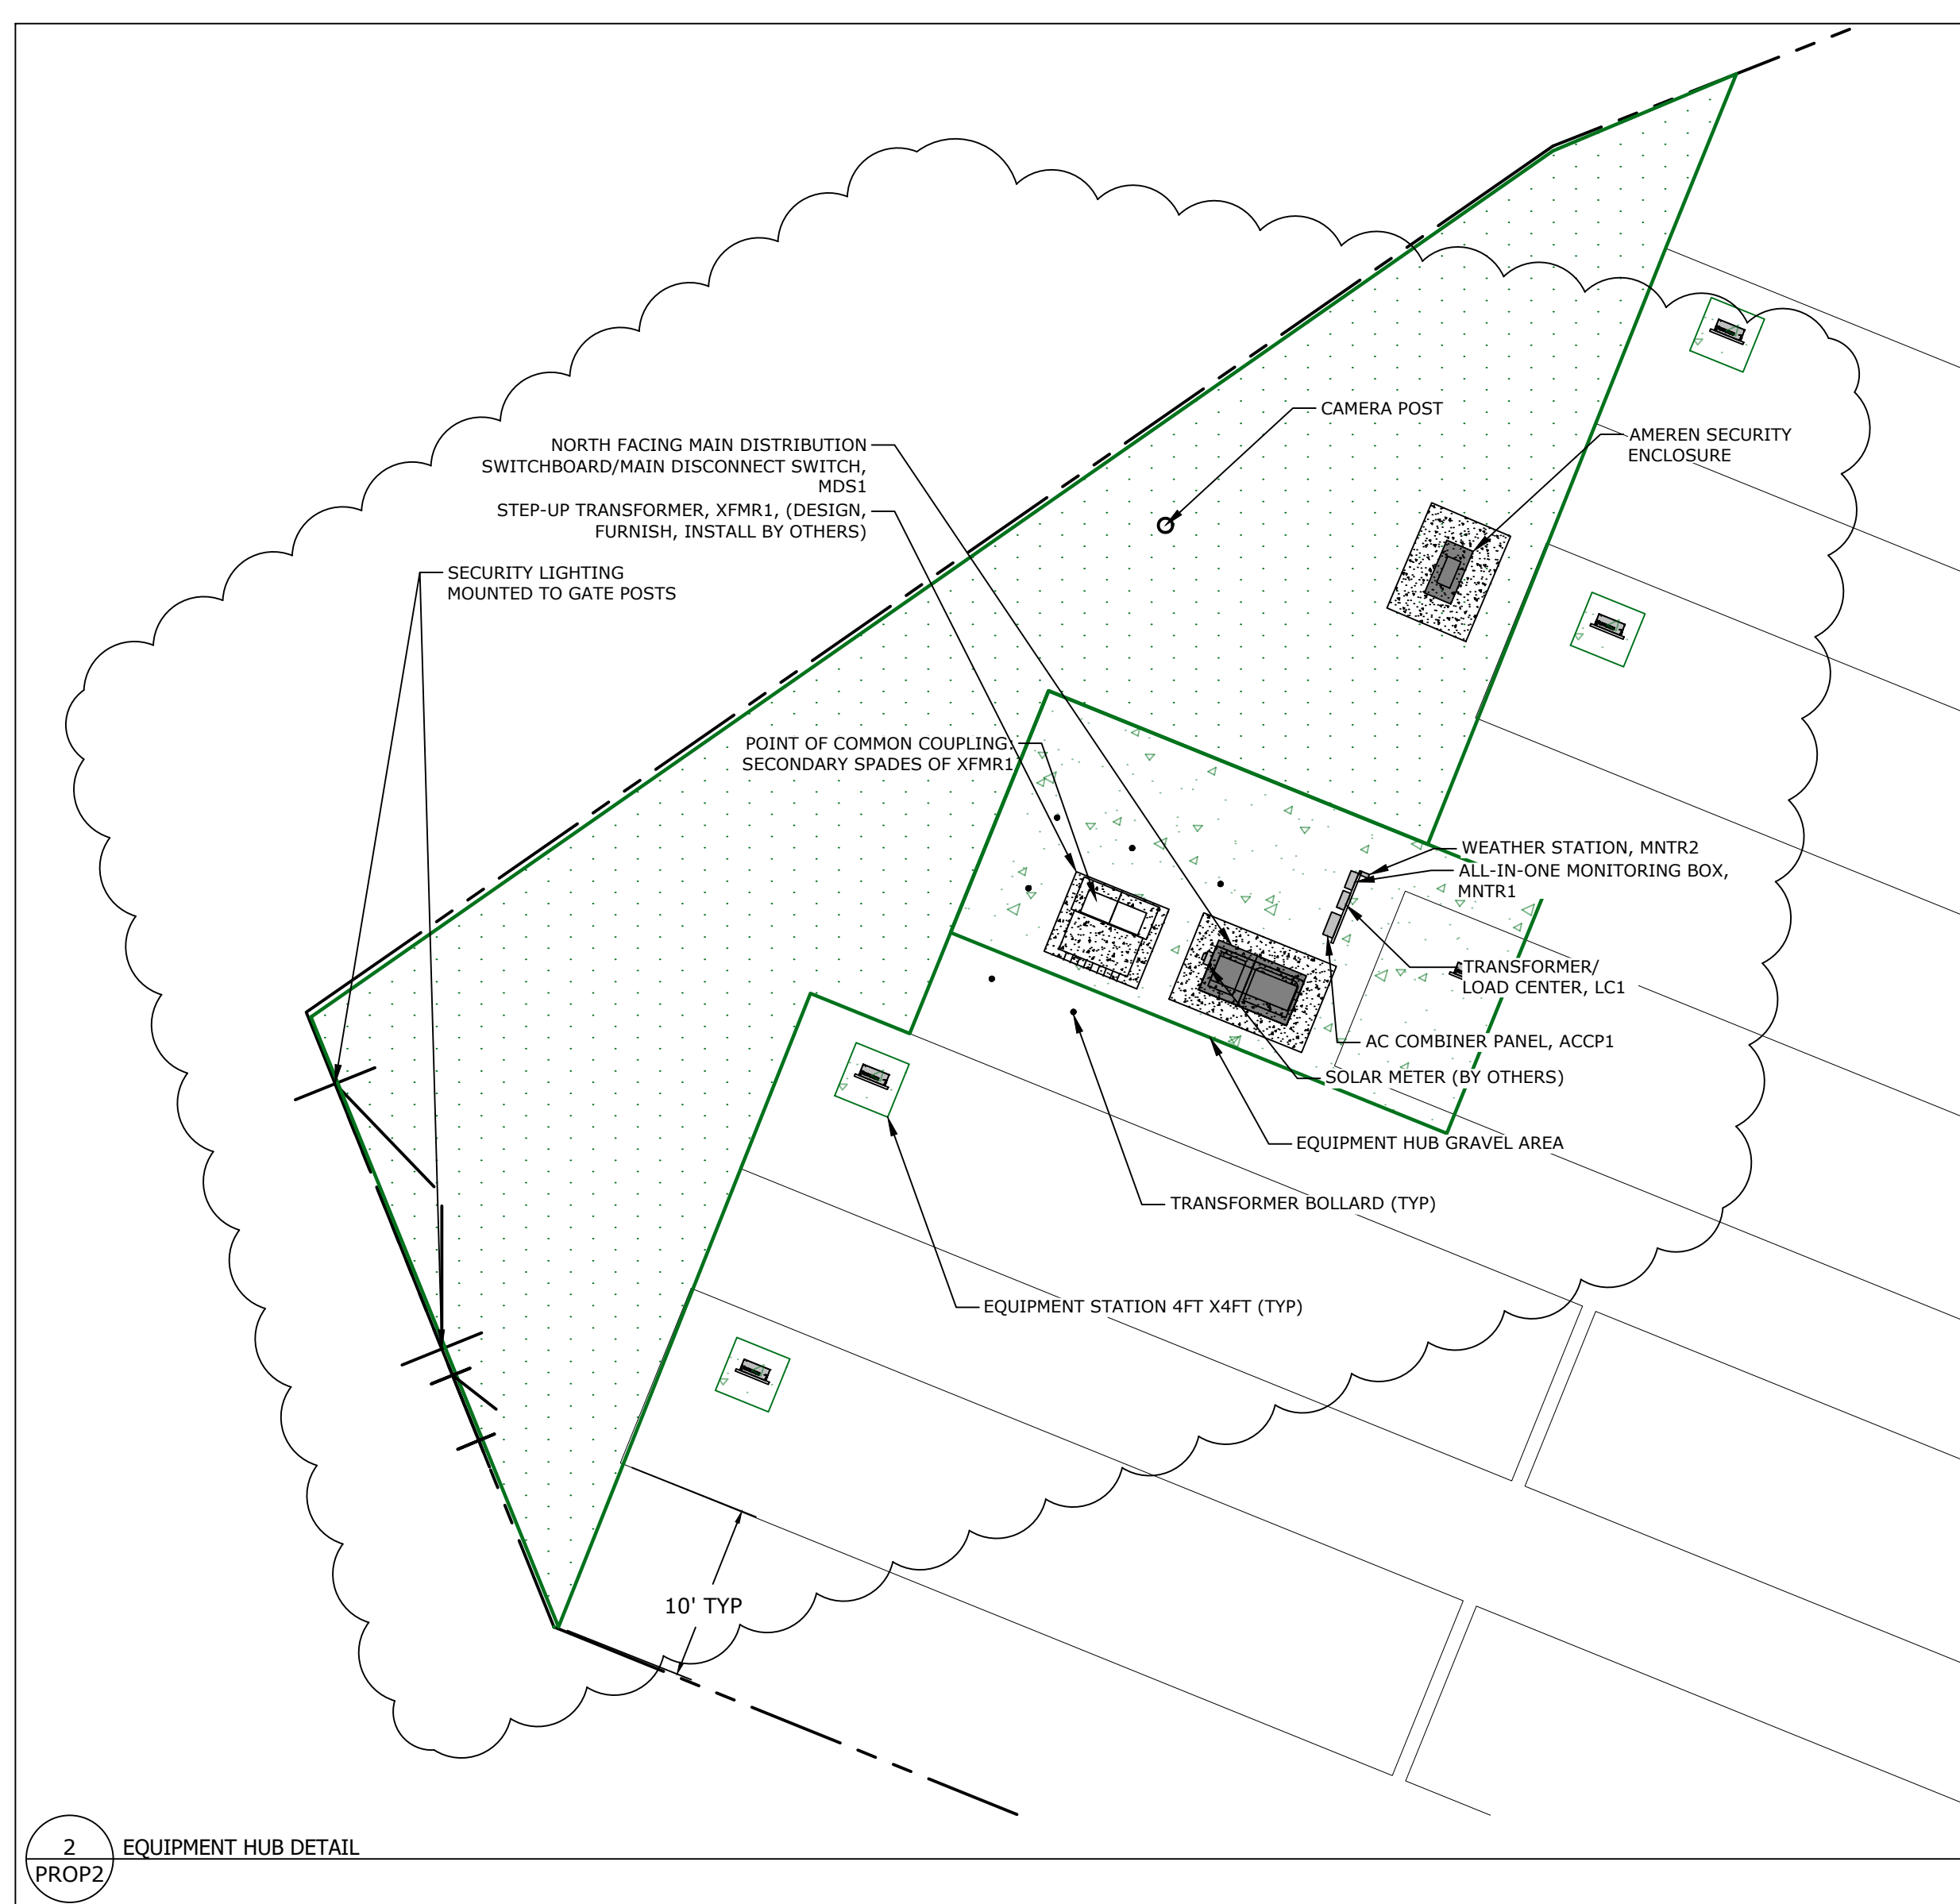

		CERTIFICANTS: MARC LOPATA, PE CERT # 091110-241 DANIEL STROH, EIT CERT # 042013-130				OPERATING DIAGRAM NOTICE OF LIMITED RESPONSIBILITY THE RESPONSIBILITY OF THE UNDERSIGNED ENGINEER IS LIMITED TO THE DESIGN WORK SHOWN ON PROJECT AND DOCUMENTS BEARING HIS/HER SEAL, SIGNATURE OR INITIALS. HE/SHE DOES NOT HAVE AUTHORITY OVER THE PROJECT AS A WHOLE. THE UNDERSIGNED DISCLAIMS ANY RESPONSIBILITY FOR WORK DONE UNDER SUBSEQUENT REVISIONS AND ANY OTHER DOCUMENTS ASSOCIATED WITH THE PROJECT WHICH DO NOT BEAR HIS/HER SEAL, SIGNATURE OR INITIALS.		MARK UP DRAWING NO. --- REV. ---	
		CERTIFICANTS: MARC LOPATA, PE CERT # PWSI-120917-006937		SCALE 1" = 60'-0" DWG. SIZE Y ARCH D (36X24) SUB CLASS ---		SITE LAYOUT PLAN SITE: AMEREN MISSOURI LAMBERT COMMUNITY SOLAR CENTER DRAWING NO. LC-DWG-PROP-000002 REVISION NO. 0	
<table border="1"> <thead> <tr> <th>REV.</th> <th>DATE</th> <th>PROJECT NO.</th> <th>DRAFTING</th> <th>CHKD</th> <th>SUPV</th> <th>ENGR</th> <th>DESCRIPTION</th> </tr> </thead> <tbody> <tr> <td>A</td> <td>03/04/19</td> <td>1704-101</td> <td>CJB</td> <td>DIR</td> <td>DAS</td> <td>ML</td> <td>CONSTRUCTION DRAWINGS</td> </tr> <tr> <td>B</td> <td>3/15/2019</td> <td>1704-101</td> <td>CJB</td> <td>DAS</td> <td>DAS</td> <td>ML</td> <td>FENCE UPDATES</td> </tr> <tr> <td>C</td> <td>5/6/2019</td> <td>1704-101</td> <td>CJB</td> <td></td> <td></td> <td></td> <td>MONITORING UPDATES</td> </tr> <tr> <td>D</td> <td>5/21/2019</td> <td>1704-101</td> <td>CJB</td> <td></td> <td></td> <td></td> <td>SECURITY ENCLOSURE</td> </tr> </tbody> </table>										REV.	DATE	PROJECT NO.	DRAFTING	CHKD	SUPV	ENGR	DESCRIPTION	A	03/04/19	1704-101	CJB	DIR	DAS	ML	CONSTRUCTION DRAWINGS	B	3/15/2019	1704-101	CJB	DAS	DAS	ML	FENCE UPDATES	C	5/6/2019	1704-101	CJB				MONITORING UPDATES	D	5/21/2019	1704-101	CJB				SECURITY ENCLOSURE
REV.	DATE	PROJECT NO.	DRAFTING	CHKD	SUPV	ENGR	DESCRIPTION	
A	03/04/19	1704-101	CJB	DIR	DAS	ML	CONSTRUCTION DRAWINGS	
B	3/15/2019	1704-101	CJB	DAS	DAS	ML	FENCE UPDATES	
C	5/6/2019	1704-101	CJB				MONITORING UPDATES	
D	5/21/2019	1704-101	CJB				SECURITY ENCLOSURE	

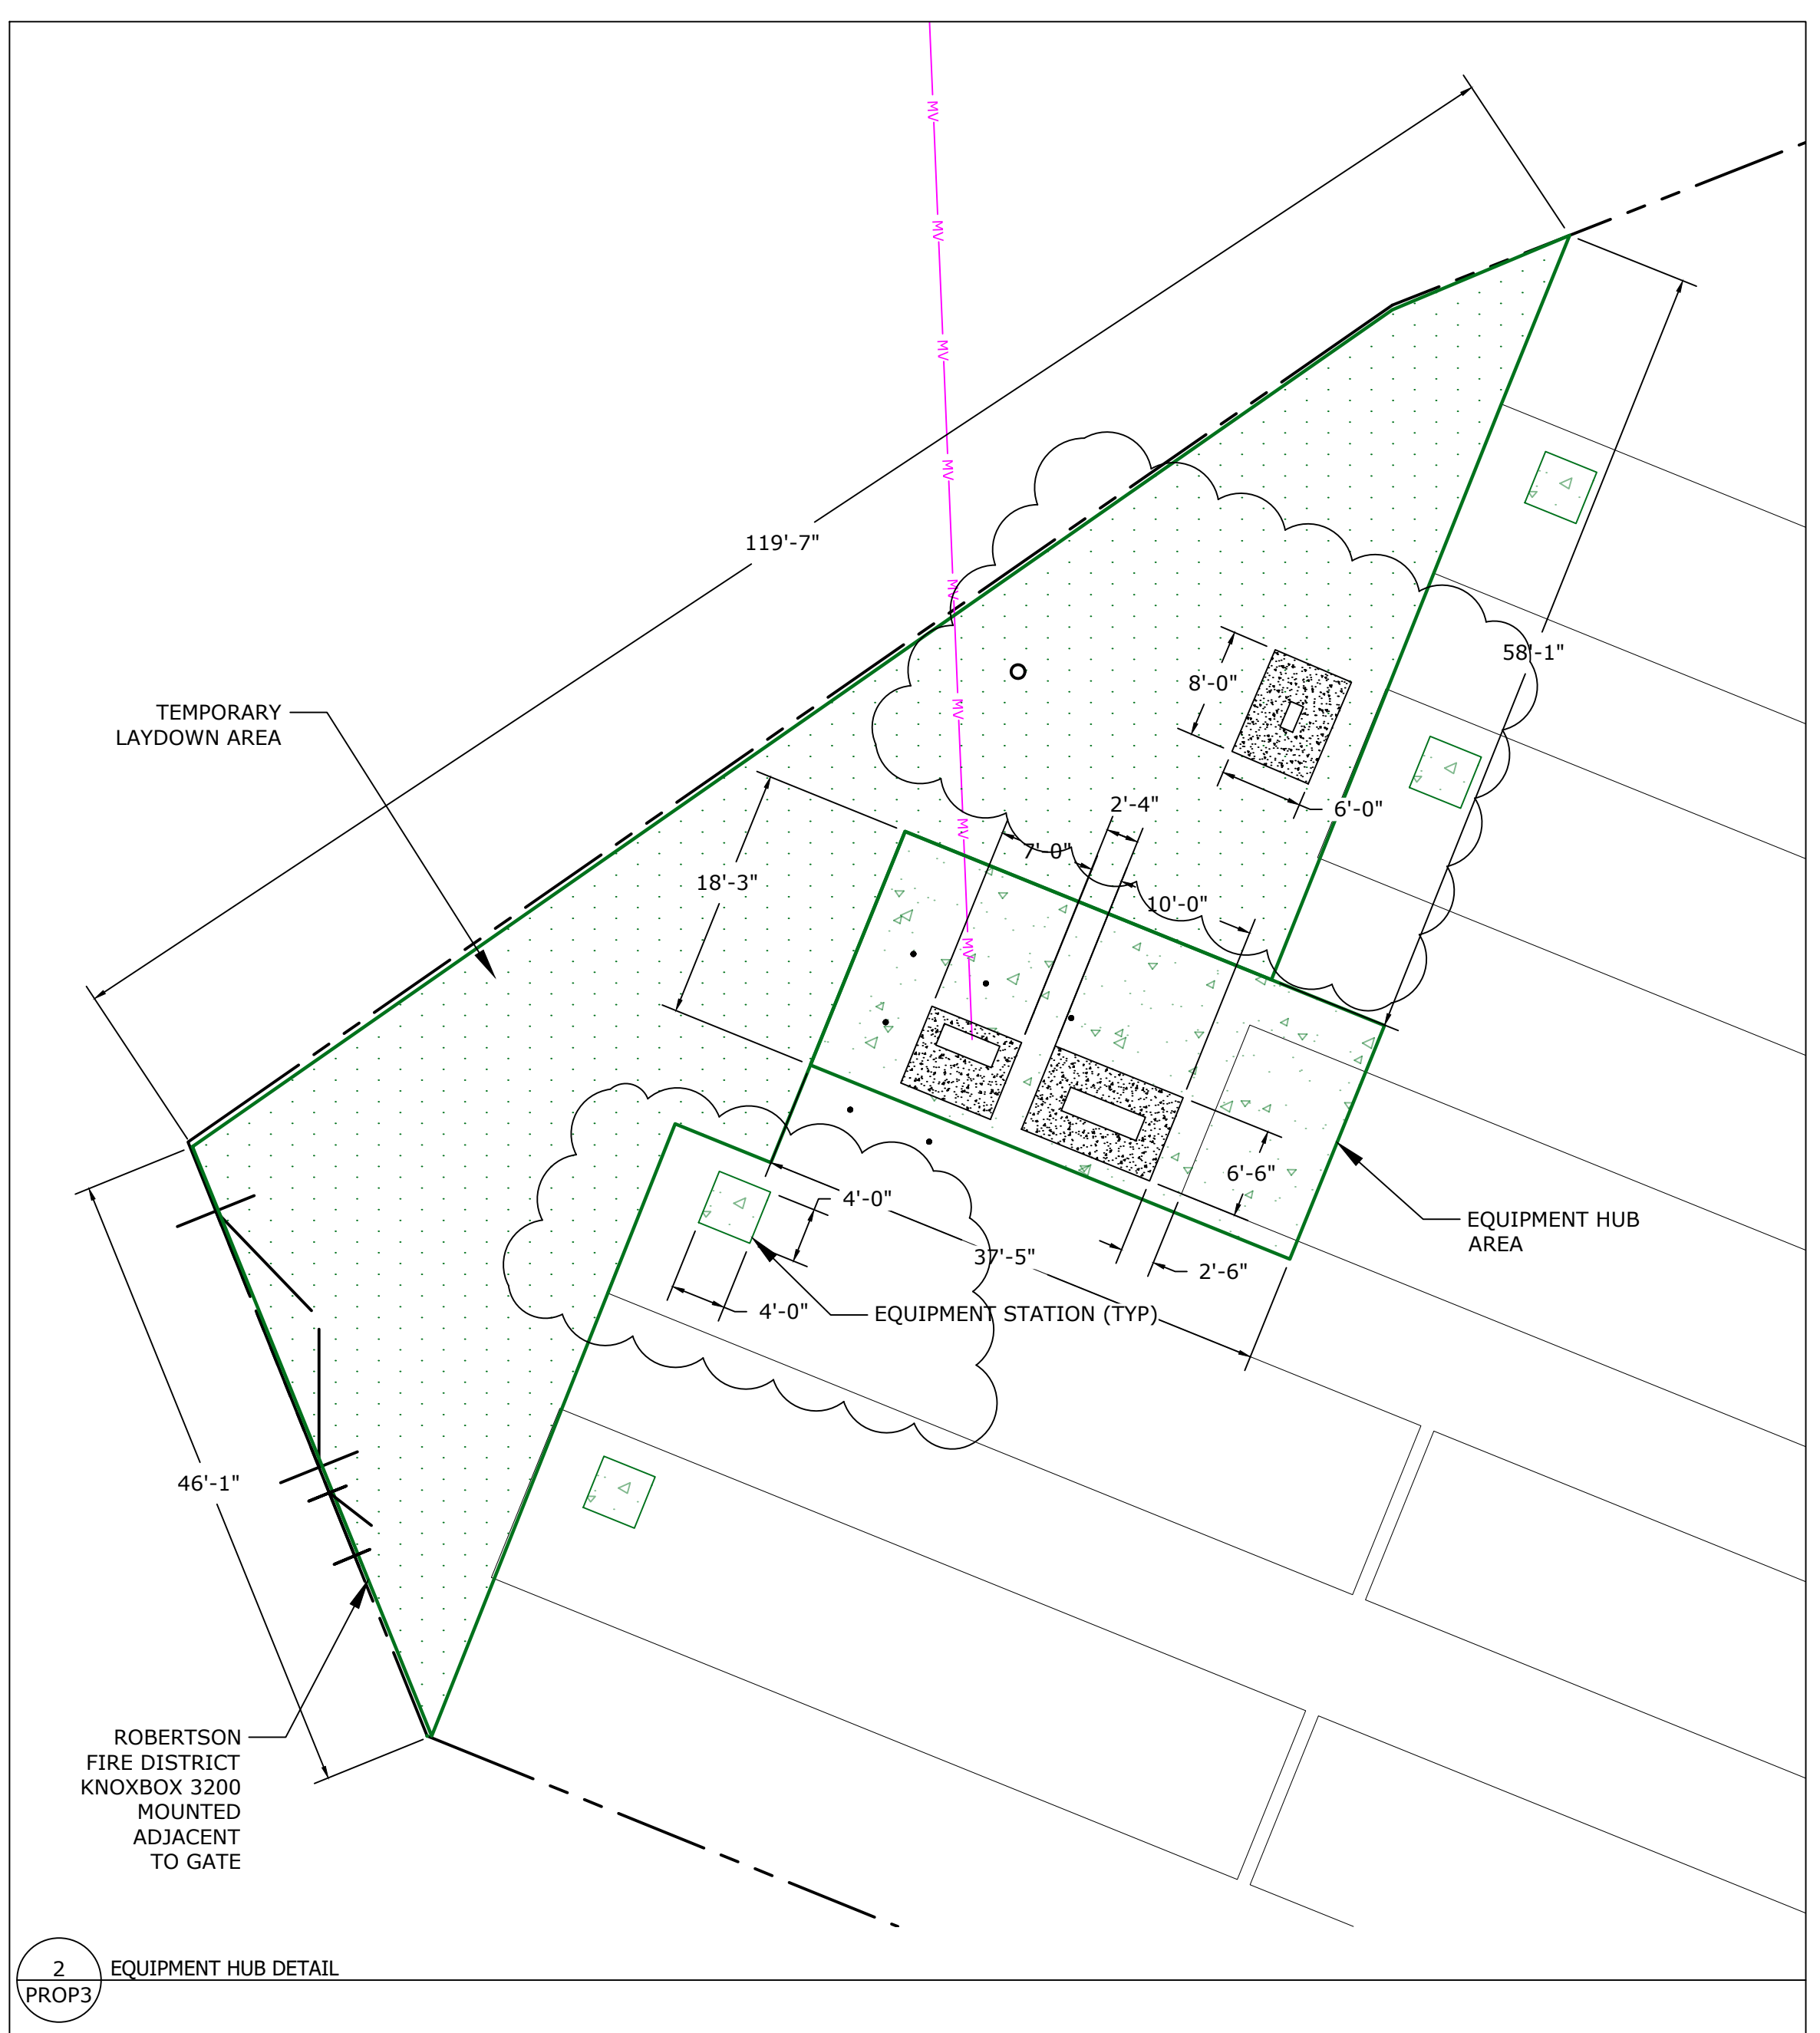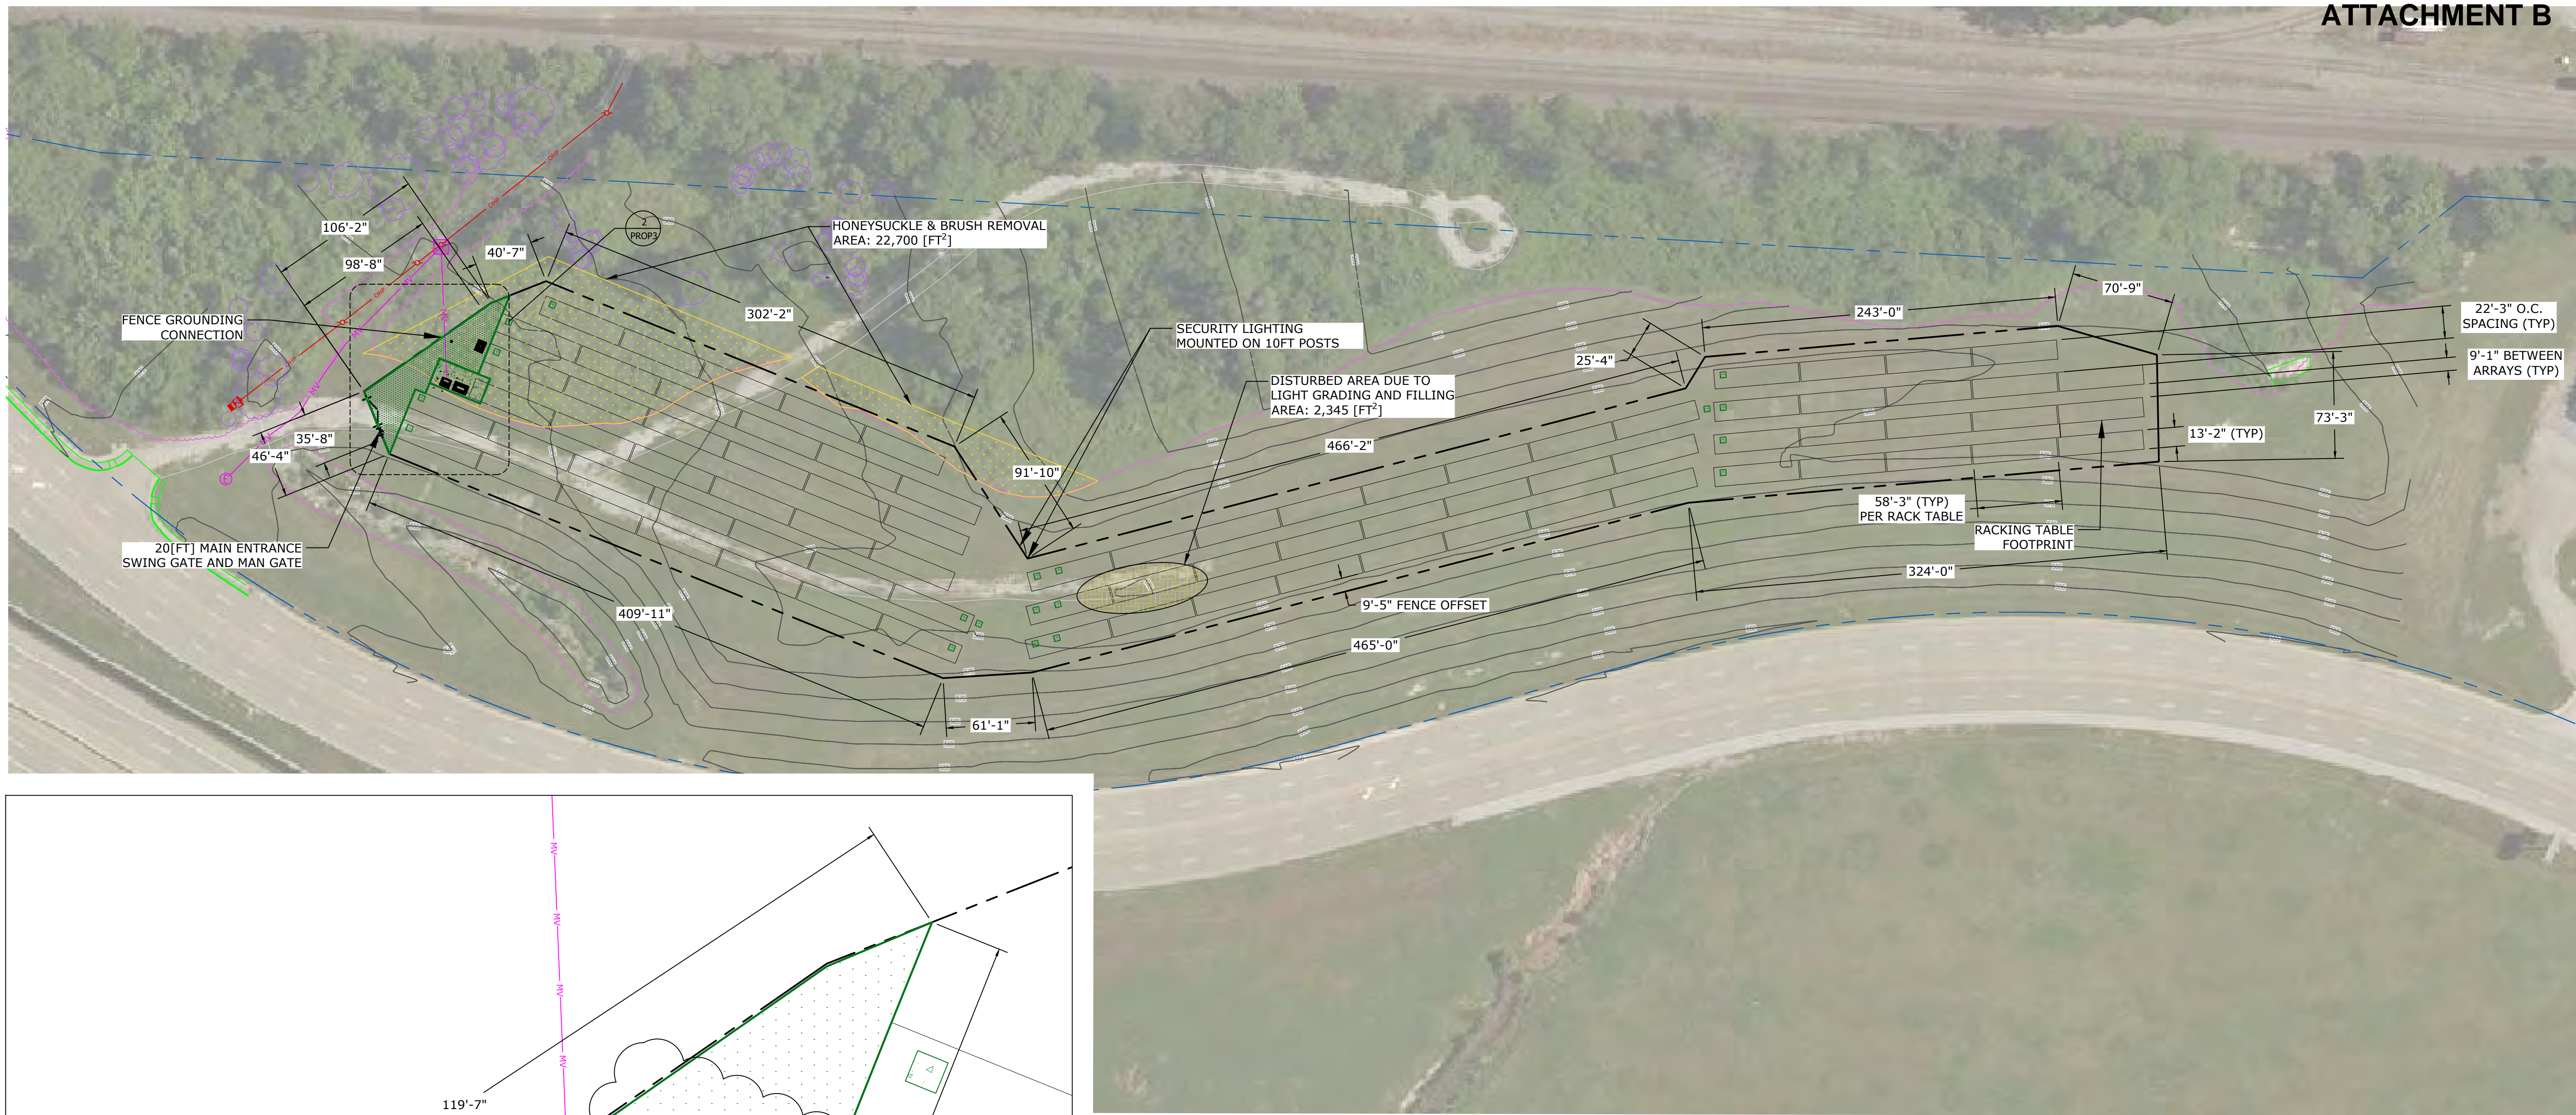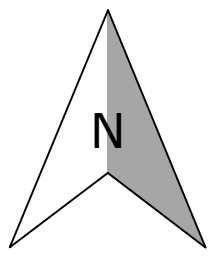

- SHEET NOTES**
1. TRANSFORMER PAD SURVEY STAKES LOCATE ALL FOUR PAD CORNERS, LOW VOLTAGE AND HIGH VOLTAGE INTERCONNECTION POINTS. TRANSFORMER DOORS TO OPEN NORTH.
 2. VEGETATION SHALL BE REMOVED 10[FT] BEYOND THE SECURITY FENCE LINE FOR THE SITE. LARGE TREES ARE EXCLUDED.
 3. FABRIC & ROCK EQUIPMENT HUB AND EQUIPMENT STATIONS AFTER PROJECT ENERGIZATION: 3[IN] THICK OF 1.5[IN] CLEAN AGGREGATE, UNDERLAIN WITH POLYPROPYLENE GEOTEXTILE FABRIC.
 4. LAYDOWN AREA SECTION: 3[IN] THICK OF 1.5[IN] MINUS CRUSHED AGGREGATE; UNDERLAIN WITH 3[IN] THICK OF 3[IN] COARSE AGGREGATE.
 5. WHERE GEOTEXTILE FABRIC IS INSTALLED, CIVIL SUB-CONTRACTOR SHALL ENSURE SECTIONS OF FABRIC OVERLAP TO INHIBIT THE GROWTH OF VEGETATION.
 6. ROADS AND OTHER AGGREGATE SURFACES SHALL BE PROPERLY COMPACTED USING APPROPRIATE VIBRATING OR TAMPING EQUIPMENT.
 7. TRANSFORMER BOLLARDS SHALL BE INSTALLED 36" FROM THE FRONT, 32" FROM THE SIDES, AND 38" FROM THE BACK OF THE TRANSFORMER PAD. THE FRONT OF THE TRANSFORMER IS THE WIRE CABINET SIDE.

SHEET LEGEND

---	NEW FENCE
[Pattern]	EQUIPMENT HUB
[Pattern]	LAYDOWN AREA
---	PROPERTY LINE
---	EXISTING GRAVEL ROADWAY
---	MAJOR TOPO LINE
---	EXISTING OVERHEAD POWER
---	MEDIUM VOLTAGE CONDUCTOR BY OTHERS
x	GROUNDING CONNECTION

OPERATING DIAGRAM

NOTICE OF LIMITED RESPONSIBILITY
 THE RESPONSIBILITY OF THE UNDERSIGNED ENGINEER IS LIMITED TO THE DESIGN WORK SHOWN ON PROJECT AND DOCUMENTS BEARING HIS/HER SEAL, SIGNATURE OR INITIALS. HE/SHE DOES NOT HAVE AUTHORITY OVER THE PROJECT AS A WHOLE. THE UNDERSIGNED DISCLAIMS ANY RESPONSIBILITY FOR WORK DONE UNDER SUBSEQUENT REVISIONS AND ANY OTHER DOCUMENTS ASSOCIATED WITH THE PROJECT WHICH DO NOT BEAR HIS/HER SEAL, SIGNATURE OR INITIALS.

SCALE: 1" = 60'-0"
 UNIT NO.: ---
 DWG. SIZE: Y ARCH D (36X24)
 SUB CLASS: ---

CIVIL SITE PLAN

SITE: AMEREN MISSOURI LAMBERT COMMUNITY SOLAR CENTER
 DRAWING NO.: LC-DWG-PROP-000003
 REVISION NO.: 0

AMEREN MISSOURI




REV.	DATE	PROJECT NO.	DRFTR	CHKD	SUPV	ENGR	DESCRIPTION
A	03/04/19	1704-101	CJB	DIR	DAS	ML	CONSTRUCTION DRAWINGS
B	3/15/2019	1704-101	CJB	DAS	DAS	ML	FENCE UPDATES
C	5/8/2019	1704-101	CJB				MONITORING UPDATES
D	5/21/2019	1704-101	CJB				SECURITY ENCLOSURE

DRAWING RECORD

CERTIFICANTS:
 MARC LOPATA, PE
 CERT# 0911109-241
 DANIEL STROH, EIT
 CERT# 042013-130

CERTIFICANTS:
 MARC LOPATA, PE
 CERT# PWSI-120917-006937

PROFESSIONAL ENGINEER
 MARCEL LOPATA
 NUMBER: PE-200402330
 DATE: MAR 15 2019

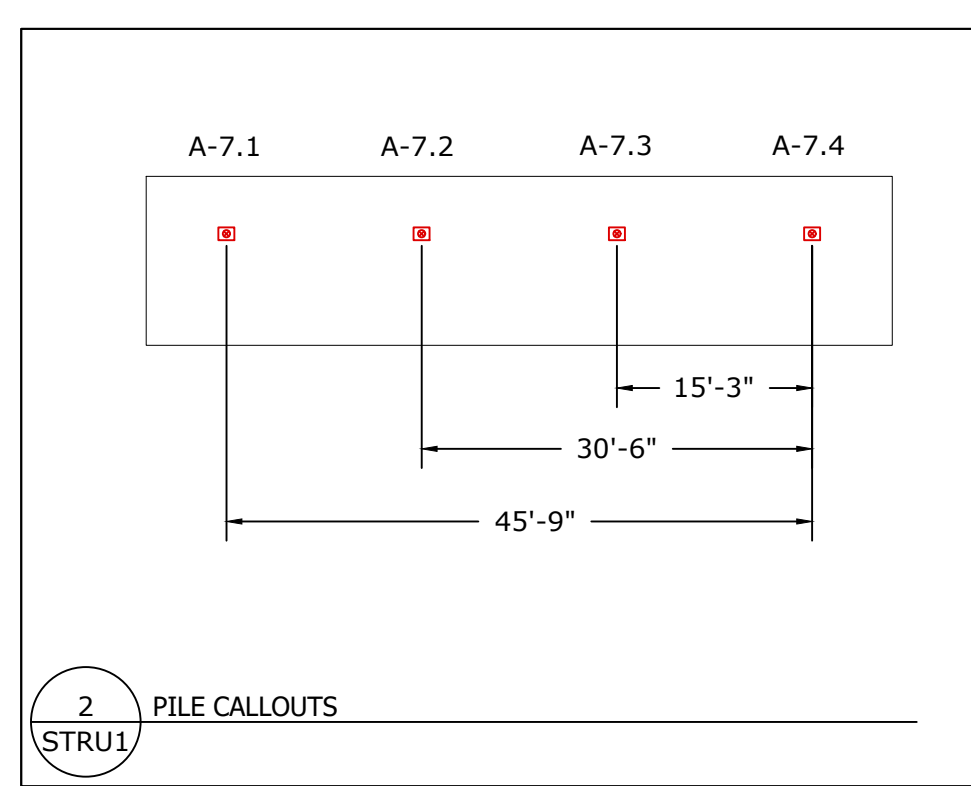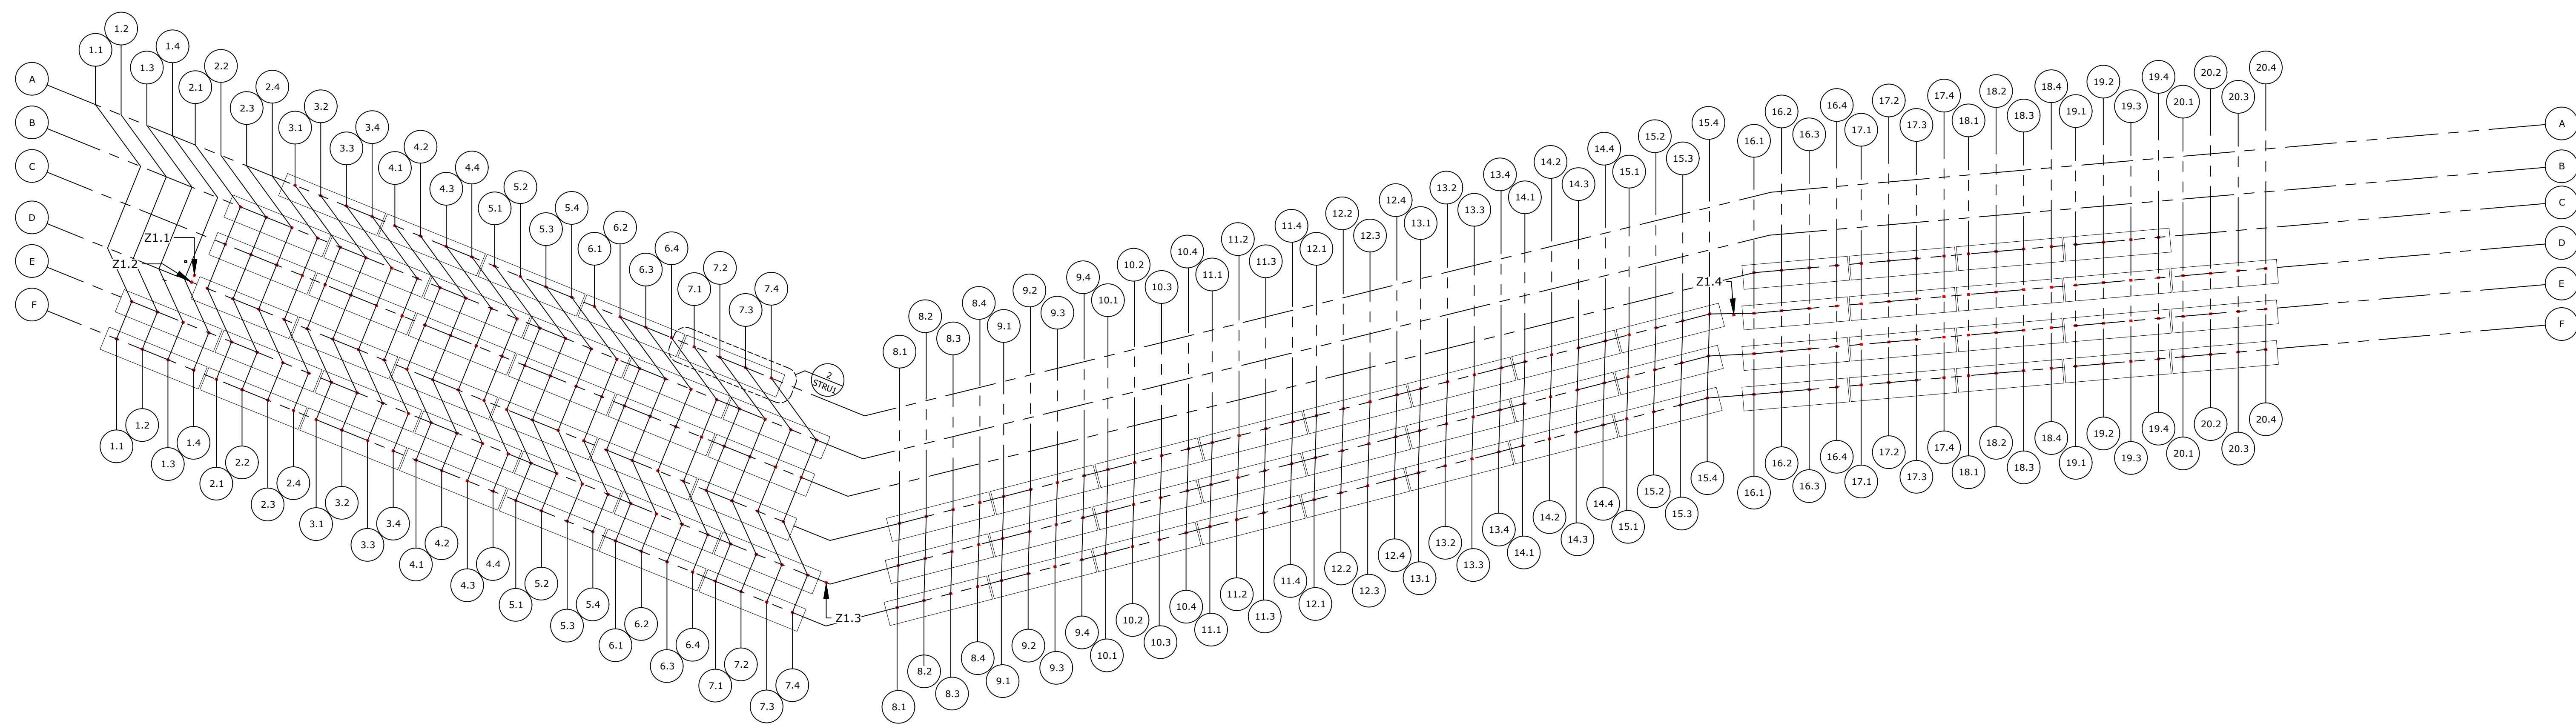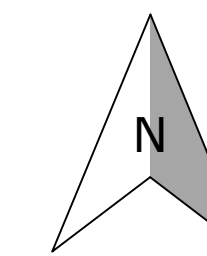


SHEET LEGEND	
	NEW FENCE
	FOUNDATION POINT TO BE LOCATED BY SURVEYOR

SHEET NOTES

1. RACKING CONTRACTOR IS RESPONSIBLE FOR FOLLOWING ALL NOTES AND SPECIFICATIONS ON RACKING MANUFACTURER'S DRAWINGS.

		CERTIFICANTS: MARC LOPATA, PE CERT # 091110-241 DANIEL STROH, EIT CERT # 042013-130				OPERATING DIAGRAM NOTICE OF LIMITED RESPONSIBILITY THE RESPONSIBILITY OF THE UNDERSIGNED ENGINEER IS LIMITED TO THE DESIGN WORK SHOWN ON PROJECT AND DOCUMENTS BEARING HIS/HER SEAL, SIGNATURE OR INITIALS. HE/SHE DOES NOT HAVE AUTHORITY OVER THE PROJECT AS A WHOLE. THE UNDERSIGNED DISCLAIMS ANY RESPONSIBILITY FOR WORK DONE UNDER SUBSEQUENT REVISIONS AND ANY OTHER DOCUMENTS ASSOCIATED WITH THE PROJECT WHICH DO NOT BEAR HIS/HER SEAL, SIGNATURE OR INITIALS.		MARK UP DRAWING NO. --- REV. ---	
		CERTIFICANTS: MARC LOPATA, PE CERT # PWSI-120917-006937		NUMBER PE-299402330		SCALE 1" = 45'-0" DWG. SIZE Y ARCH D (36X24) SUB CLASS ---		FOUNDATION PLAN SITE: AMEREN MISSOURI LAMBERT COMMUNITY SOLAR CENTER DRAWING NO. LC-DWG-STRU-000001 REVISION NO. 0	
DRAWING RECORD									
REV.	DATE	PROJECT NO.	DRFTR	CHKD	SUPV	ENGR	DESCRIPTION		
A	03/04/19	1704-101	CJB	DIR	DAS	ML	CONSTRUCTION DRAWINGS		
B	3/15/2019	1704-101	CJB	DAS	DAS	ML	FENCE UPDATES		
C	5/8/2019	1704-101	CJB				MONITORING UPDATES		
D	5/21/2019	1704-101	CJB				SECURITY ENCLOSURE		

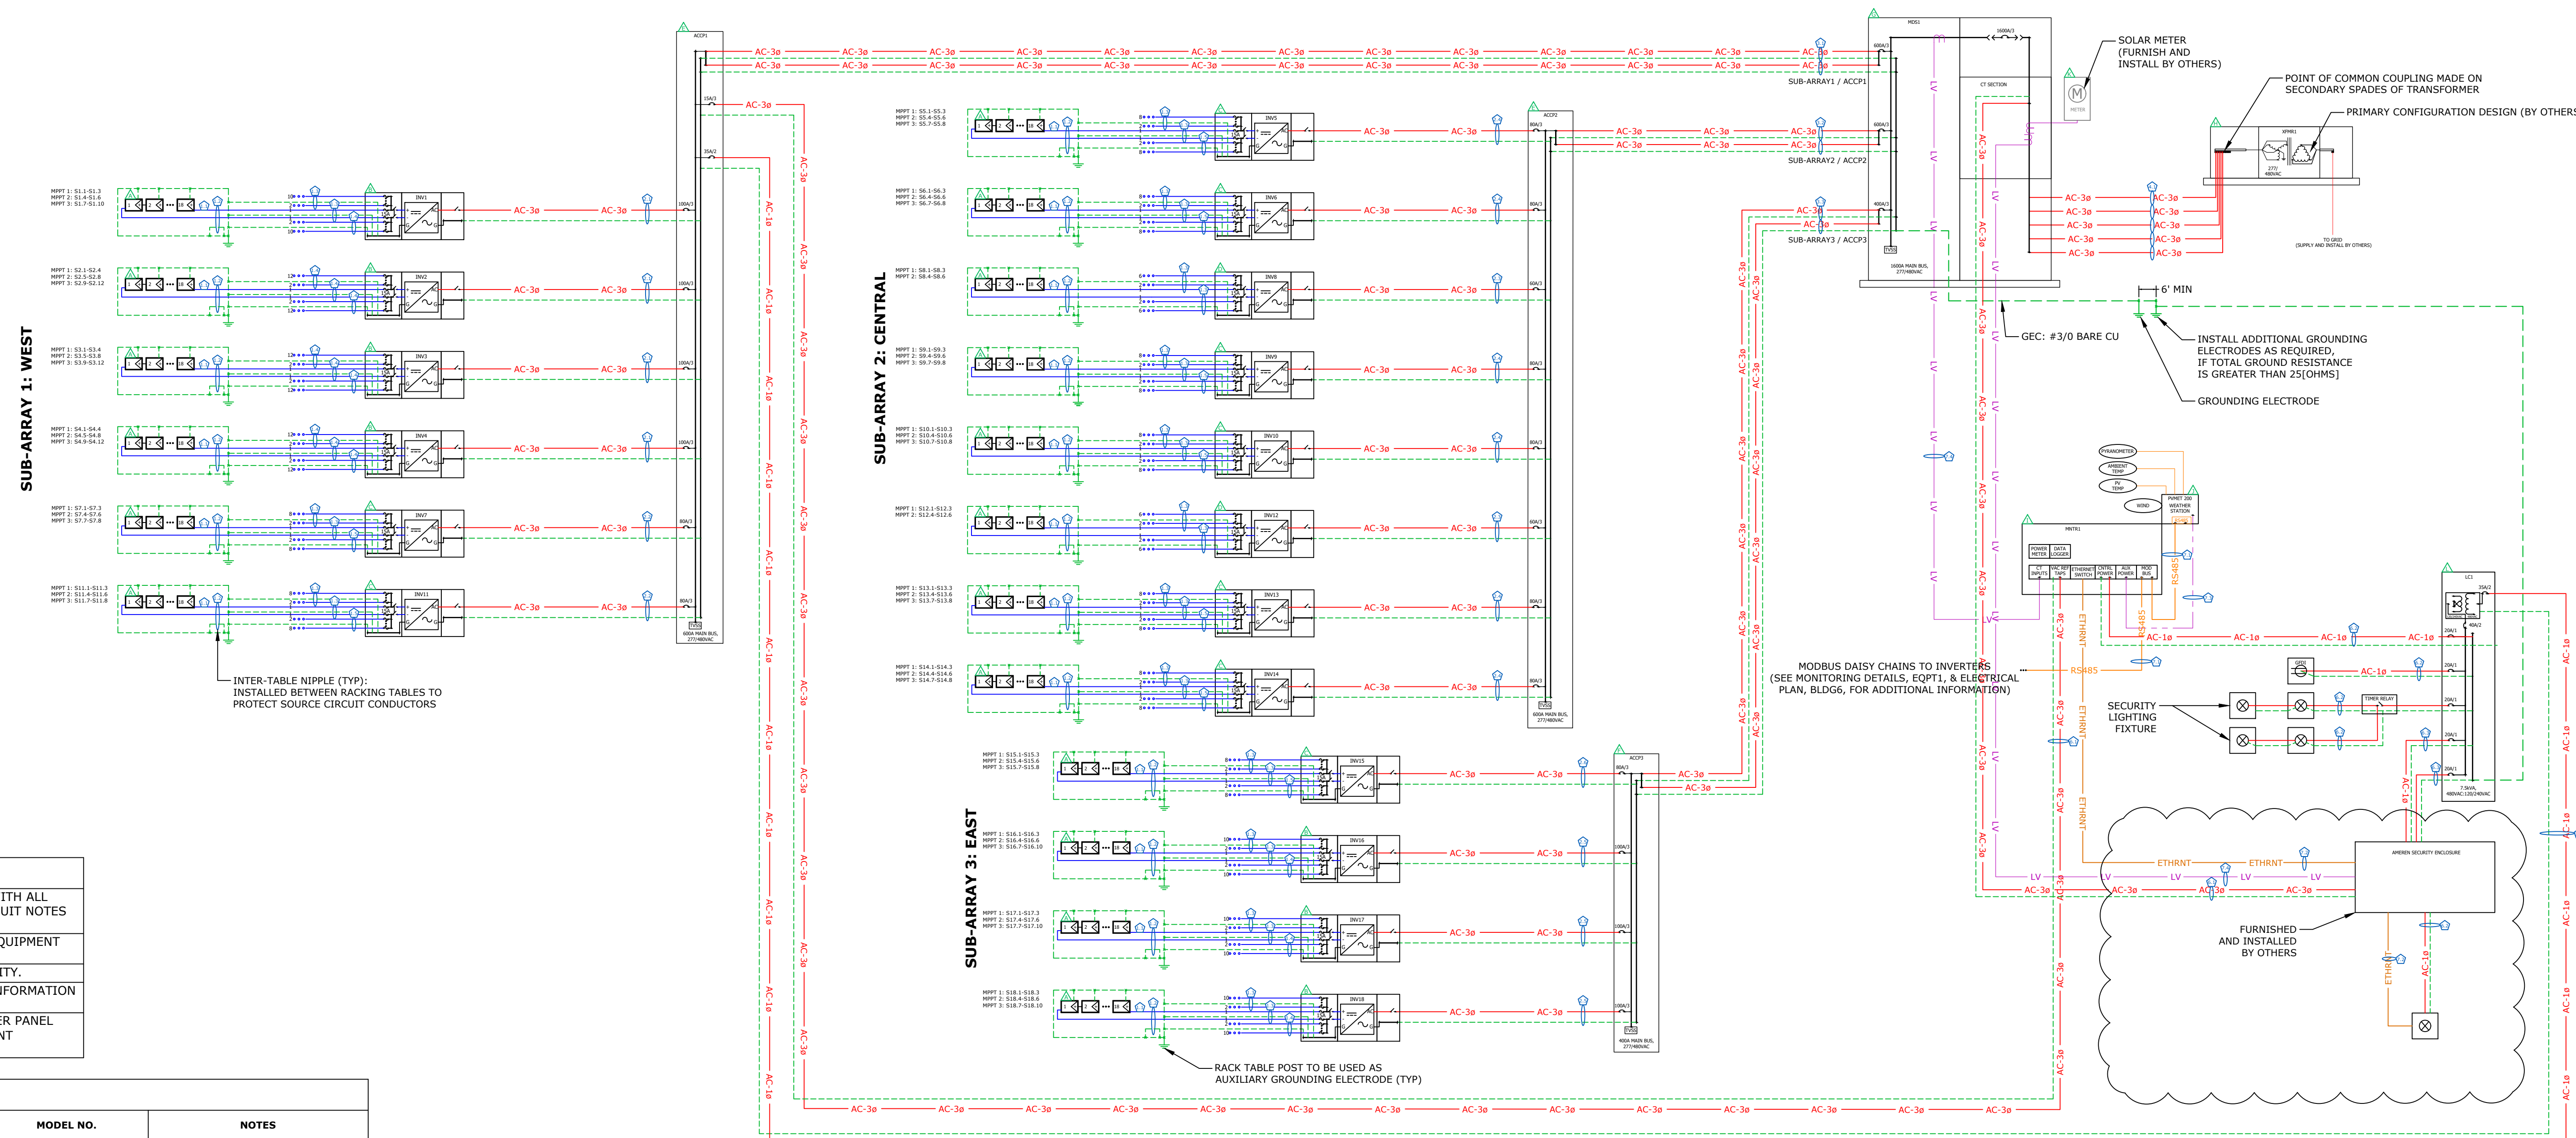

- SHEET NOTES**
- CONTRACTOR IS RESPONSIBLE FOR COMPLIANCE WITH ALL GENERAL NOTES, DC CIRCUIT NOTES, AND AC CIRCUIT NOTES IN DRAWING PACKAGE.
 - REFER TO GENERAL NOTES FOR ELECTRICAL AND EQUIPMENT DEFINITIONS.
 - BALANCED 3-PHASE, ONE PHASE SHOWN FOR CLARITY.
 - REFER TO DETAILS SHEET, ELEC5, FOR LABELING INFORMATION & LOCATIONS.
 - REFER TO DETAILS SHEET, ELEC6, FOR AC COMBINER PANEL AND MAIN DISTRIBUTION SWITCHBOARD EQUIPMENT SCHEDULES.

EQUIPMENT SCHEDULE

#	QTY	EQUIPMENT ID	EQUIPMENT TYPE	MODEL NO.	NOTES
A	2,880	S1.1:S18.10	PV MODULE	GCL-M6/72H 370W MODULE	-
B	7	INV1-INV4: INV16-INV18	INVERTER	SOLECTRIA PVI-60TL-480	-
C	9	INV5-7, 9-11, 16-18	INVERTER	SOLECTRIA PVI-50TL-480	-
D	2	INV8, INV12	INVERTER	SOLECTRIA PVI-36TL-480	-
E	2	ACCP1:ACCP2	AC COMBINER PANEL	GENERAL ELECTRIC, 600A 'AS' PANELBOARD, NEMA 4	TVSS 50KA/MODE
F	1	ACCP3	AC COMBINER PANEL	GENERAL ELECTRIC, 400A 'AS' PANELBOARD, NEMA 4	TVSS 50KA/MODE
G	1	MDS1	MAIN DISTRIBUTION SWITCHBOARD/MAIN DISCONNECT SWITCH	GENERAL ELECTRIC, 1600A 'SPECTRA' SWITCHBOARD, NEMA3R	FAULT CURRENT RATING: 35(KAIC); PRE-INSTALLED 125KA/MODE TRANSIENT VOLTAGE SURGE SUPPRESSION DEVICE; DRAWOUT STYLE MAIN BREAKER
H	1	XFMR1	STEP-UP TRANSFORMER	ABB 1000KVA	DESIGN, FURNISH, & INSTALL BY OTHERS INCLUDES EQUIPMENT PER MONITORING DETAILS SHEET
I	1	MNTR1	MONITORING BOX	ALSO ENERGY ALL-IN-ONE ENCLOSURE	REMOTE DYNAMIC CONTROL OF SYSTEM/INVERTERS, OPEN PLATFORM, COMMUNICATIONS, RTAC, AND PORT FORWARDING NOT INCLUDED.
J	1	MNTR2	WEATHER STATION	-	INCLUDES: WIND SPEED/DIRECTION, TILTED & HORIZONTAL IRRADIANCE, AND AMBIENT & MODULE CELL TEMPERATURES
K	1	MTR1	SOLAR METER	-	DESIGN, FURNISH, AND INSTALL BY OTHERS
L	1	LC1	TRANSFORMER/LOAD CENTER	GENERAL ELECTRIC, 7.5KVA, NEMA3R	480V II 120/240V (1) 35A/2 MAIN CIRCUIT BREAKER, AND (3) 20A/1-POLE CIRCUIT BREAKERS

SHEET LEGEND

	UNGROUND DC CURRENT CARRYING CONDUCTOR
	AC CURRENT CARRYING CONDUCTORS, BALANCED 3-PHASE
	AC CURRENT CARRYING CONDUCTOR(S)
	EQUIPMENT GROUNDING CONDUCTOR
	GROUNDING ELECTRODE CONDUCTOR
	LOW VOLTAGE CABLE(S)
	RS485 DATA CABLE
	APPROVED GROUNDING CONNECTION
	GROUNDING ELECTRODE

OPERATING DIAGRAM

NOTICE OF LIMITED RESPONSIBILITY
THE RESPONSIBILITY OF THE UNDERSIGNED ENGINEER IS LIMITED TO THE DESIGN WORK SHOWN ON PROJECT AND DOCUMENTS BEARING HIS/HER SEAL, SIGNATURE OR INITIALS. HE/SHE DOES NOT HAVE AUTHORITY OVER THE PROJECT AS A WHOLE. THE UNDERSIGNED DISCLAIMS ANY RESPONSIBILITY FOR WORK DONE UNDER SUBSEQUENT REVISIONS AND ANY OTHER DOCUMENTS ASSOCIATED WITH THE PROJECT WHICH DO NOT BEAR HIS/HER SEAL, SIGNATURE, OR INITIALS.

SCALE: NOT TO SCALE
UNIT NO.: Y ARCH D (36X24)
DWG. SIZE: Y ARCH D (36X24)
SUB CLASS: ---

SINGLE LINE DIAGRAM AND SPECIFICATIONS

SITE: AMEREN MISSOURI LAMBERT COMMUNITY SOLAR CENTER
DRAWING NO.: LC-DWG-ELEC-000001
REVISION NO.: 0

AMEREN MISSOURI

DRAWING RECORD

REV.	DATE	PROJECT NO.	DRAFTING	CHKD	SUPV	ENGR	DESCRIPTION
A	03/04/19	1704-101	CJB	DIR	DAS	ML	CONSTRUCTION DRAWINGS
B	3/15/2019	1704-101	CJB	DAS	DAS	ML	FENCE UPDATES
C	5/6/2019	1704-101	CJB	DAS	DAS	ML	MONITORING UPDATES
D	5/21/2019	1704-101	CJB				SECURITY ENCLOSURE

CERTIFICANTS:
MARC LOPATA, PE
CERT # 0911109-241
DANIEL STROH, EIT
CERT # 042013-130

CERTIFICANTS:
MARC LOPATA, PE
CERT #
PVSI-120917-006937

PROFESSIONAL ENGINEER
MARC LOPATA
MAR 15 2019
NUMBER PE-2004023303

NABCEP CERTIFIED
PV Installation Professional

NABCEP CREDENTIALLED
PVSI-120917-006937

PV SOURCE CIRCUIT WIRE & CONDUIT SCHEDULE

STRING IDS	FEEDS INVERTER ID	#	CURRENT CARRYING CONDUCTORS	GROUNDING CONDUCTOR	CONDUIT SIZE & TYPE [INCHES]	OC PD SIZE [AMP]	NUMBER OF SERIES MODULES	NUMBER OF PARALLEL RUNS PER CIRCUIT	1.25*MAX CIRCUIT CURRENT PER RUN [AMP]	DESIGN TEMP [°C]	TEMP DERATE FACTOR	CONDUIT FILL DERATE FACTOR	MAX ADJUSTED CIRCUIT CURRENT PER RUN [AMP]	CONDUCTOR AMPACITY PER RUN [AMP@°C]	MAX ESTIMATED ONE-WAY DISTANCE [FT]	VOLTAGE DROP [%]	ACTUAL CONDUIT FILL [%]	ALLOWABLE CONDUIT FILL [%]
S1.1:S18.10	INV1:INV18	1.1	(2) #10 C PV-2000V CU	(1) #6 G BARE STR CU	FREE AIR	15	18	1	14.77	35	0.96	1.00	12.30	(1) x 40 @ 90°C	315	1.34%	0.00	40.00
S1.1:S18.10	INV1:INV18	1.2	SEE DC CIRCUIT NOTE #8 FOR CONDUCTORS & INTER-TABLE NIPPLE DETAILS			15	18	1	14.77	35	-	-	-	(1) x 40 @ 90°C	2	0.01%	VARIES	60.00
(3) STRING INVERTER INPUT CONDUIT		1.3	(6) #10 C PV-2000V CU	(1) #6 G BARE STR CU	(1) 1-1/4" GRC/ LFMC	15	18	1	14.77	35	0.96	0.80	15.38	(1) x 40 @ 90°C	10	0.04%	23.78	40.00
(4) STRING INVERTER INPUT CONDUIT		1.4	(8) #10 C PV-2000V CU	(1) #6 G BARE STR CU	(1) 1-1/4" GRC/ LFMC	15	18	1	14.77	35	0.96	0.70	17.58	(1) x 40 @ 90°C	10	0.04%	31.10	40.00
(2) STRING INVERTER INPUT CONDUIT		1.5	(4) #10 C PV-2000V CU	(1) #6 G BARE STR CU	(1) 1-1/4" GRC/ LFMC	15	18	1	14.77	35	0.96	0.80	15.38	(1) x 40 @ 90°C	10	0.04%	16.46	40.00


PV INVERTER OUTPUT CIRCUIT WIRE & CONDUIT SCHEDULE

EQUIP ID	FEEDS EQUIP ID	#	CURRENT CARRYING CONDUCTORS	GROUNDING CONDUCTOR	CONDUIT SIZE & TYPE [INCHES]	OC PD SIZE [AMP]	NUMBER OF COMBINED INVERTERS PER CIRCUIT	NUMBER OF PARALLEL RUNS PER CIRCUIT	1.25*MAX CIRCUIT CURRENT PER RUN [AMP]	DESIGN TEMP [°C]	TEMP DERATE FACTOR	CONDUIT FILL DERATE FACTOR	MAX ADJUSTED CIRCUIT CURRENT PER RUN [AMP]	CONDUCTOR AMPACITY PER RUN [AMP@°C]	MAX ESTIMATED ONE-WAY DISTANCE [FT]	VOLTAGE DROP L-L [%]	ACTUAL CONDUIT FILL [%]	ALLOWABLE CONDUIT FILL [%]
PVI-60TL CKTS TO ACCP1		2.1	(3) #3 C THWN-2 CU, (1) #8 N THWN-2 CU	(1) #8 G THWN-2 CU	(1) 1-1/2" LFNC/ PVC SCHD 40/ PVC SCHD 80	100	1	1	99.25	35	0.96	1.0	82.71	(1) x 115 @ 90°C	120	0.873%	21.3%	40.0%
PVI-50TL CKTS TO ACCP1		2.2	(3) #4 C THWN-2 CU, (1) #8 N THWN-2 CU	(1) #8 G THWN-2 CU	(1) 1-1/2" LFNC/ PVC SCHD 40/ PVC SCHD 80	80	1	1	82.75	35	0.96	1.0	68.96	(1) x 95 @ 90°C	105	0.783%	18.7%	40.0%
PVI-36TL CKTS TO ACCP2		2.3	(3) #6 C THWN-2 CU, (1) #10 N THWN-2 CU	(1) #10 G THWN-2 CU	(1) 1-1/4" LFNC/ PVC SCHD 40/ PVC SCHD 80	60	1	1	54.38	35	0.96	1.0	45.31	(1) x 75 @ 90°C	91	0.697%	15.7%	40.0%
PVI-50TL CKTS TO ACCP2		2.4	(3) #3 C THWN-2 CU, (1) #8 N THWN-2 CU	(1) #8 G THWN-2 CU	(1) 1-1/2" LFNC/ PVC SCHD 40/ PVC SCHD 80	80	1	1	82.75	35	0.96	1.0	68.96	(1) x 115 @ 90°C	98	0.594%	21.3%	40.0%
PVI-60TL CKTS TO ACCP3		2.5	(3) #2/0 C THWN-2 CU, (1) #4 N THWN-2 CU	(1) #4 G THWN-2 CU	(1) 2-1/2" LFNC/ PVC SCHD 40/ PVC SCHD 80	100	1	1	99.25	35	0.96	1.0	82.71	(1) x 195 @ 90°C	59	0.182%	20.2%	40.0%
PVI-50TL CKTS TO ACCP3		2.6	(3) #1/0 C THWN-2 CU, (1) #2 N THWN-2 CU	(1) #2 G THWN-2 CU	(1) 2-1/2" LFNC/ PVC SCHD 40/ PVC SCHD 80	80	1	1	82.75	35	0.96	1.0	68.96	(1) x 170 @ 90°C	52	0.158%	19.1%	40.0%
ACCP1	MDS1	3.1	(3) #350 C THWN-2 CU, (1) #350 N THWN-2 CU	(1) #1 G THWN-2 CU	(1) 3-1/2" PVC SCHD 40/ PVC SCHD 80	600	7	2	294.25	35	0.96	1.0	306.51	(2) x 350 @ 90°C	18	0.07%	25.90%	40.0%
ACCP2	MDS1	3.2	(3) #500 C THWN-2 CU, (1) #3/0 N THWN-2 CU	(1) #3/0 G THWN-2 CU	(1) 4" PVC SCHD 40/ PVC SCHD 80	600	7	2	289.63	35	0.96	1.0	241.35	(2) x 430 @ 90°C	417	1.311%	23.6%	40.0%
ACCP3	MDS1	3.3	(3) #400 C THWN-2 CU, (1) #3/0 N THWN-2 CU	(1) #3/0 G THWN-2 CU	(1) 4" PVC SCHD 40/ PVC SCHD 80	400	4	2	190.25	35	0.96	1.0	158.54	(2) x 380 @ 90°C	928	2.226%	20.4%	40.0%
MDS1	XFMR1	4.1	(3) #400 C THWN-2 CU, (1) #250 N THWN-2 CU	-	(1) 4" PVC SCHD 40/ PVC SCHD 80	1600	18	5	309.65	35	0.96	1.0	258.04	(5) x 380 @ 90°C	24	0.094%	19.1%	40.0%
ACCP1	LC1	5.1	(2) #6 C THWN-2 CU, (1) #6 N THWN-2 CU	(1) #10 G THWN-2 CU	(1) 1" GRC	50	0	1	-	35	0.96	1.0	-	(1) x 75 @ 90°C	10	-	25.10%	40.0%
ACCP1	MNTR1	6.1	(3) #10 C THWN-2 CU, (1) #10 N THWN-2 CU	(1) #10 G THWN-2 CU	(1) 1" GRC	15	0	1	-	35	0.96	1.0	-	(1) x 40 @ 90°C	10	-	12.00%	40.0%
LC1	LOAD	6.2	(2) #10 C THWN-2 CU, (1) #10 N THWN-2 CU	(1) #10 G THWN-2 CU	(1) 1" PVC SCHD40/ PVC SCHD 80/ GRC	20	0	1	-	35	0.96	1.0	-	(1) x 40 @ 90°C	VARIES	-	12.28%	40.0%
LC1	LOAD	6.3	(2) #10 C THWN-2 CU, (1) #10 N THWN-2 CU	(1) #10 G THWN-2 CU	(1) 1-1/2" PVC SCHD40/ PVC SCHD 80/ GRC	20	0	1	-	35	0.96	1.0	-	(1) x 40 @ 90°C	VARIES	-	4.90%	40.0%

COMMUNICATIONS WIRE & CONDUIT SCHEDULE

EQUIP ID	FEEDS EQUIP ID	#	CURRENT CARRYING CONDUCTORS	GROUNDING CONDUCTOR	CONDUIT SIZE & TYPE [INCHES]
INV1:INV18	MNTR1	7.1	RS485- BELDEN 3106A		(1) 3/4" PVC SCHD40/ PVC SCHD 80/ GRC
MNTR1	MNTR1	7.2	ETHERNET- BELDEN 7919A		(1) 1" PVC SCHD40/ PVC SCHD 80/ GRC
MNTR1	MNTR2	7.3	(2) #12 THWN-2		(1) 3/4" GRC
MNTR1	MDS1	7.4	CT CONDUCTORS		(1) 3/4" PVC SHD40/ PVC SCHD80/ GRC


	CERTIFICANTS: MARC LOPATA, PE CERT # 091110-241 DANIEL STROH, EIT CERT # 042013-130		OPERATING DIAGRAM		---	
	NOTICE OF LIMITED RESPONSIBILITY THE RESPONSIBILITY OF THE UNDERSIGNED ENGINEER IS LIMITED TO THE DESIGN WORK SHOWN ON PROJECT AND DOCUMENTS BEARING HIS/HER SEAL, SIGNATURE OR INITIALS. HE/SHE DOES NOT HAVE AUTHORITY OVER THE PROJECT AS A WHOLE. THE UNDERSIGNED DISCLAIMS ANY RESPONSIBILITY FOR WORK DONE UNDER SUBSEQUENT REVISIONS AND ANY OTHER DOCUMENTS ASSOCIATED WITH THE PROJECT WHICH DO NOT BEAR HIS/HER SEAL, SIGNATURE OR INITIALS.		MARK UP DRAWING NO.	REV.	
	CERTIFICANTS: MARC LOPATA, PE CERT # PVSI-120917-006937		SCALE: NOT TO SCALE		WIRE AND CONDUIT SCHEDULE	
	UNIT NO. --- DWG. SIZE Y ARCH D (36X24) SUB CLASS ---	
DRAWING RECORD			SITE: AMEREN MISSOURI LAMBERT COMMUNITY SOLAR CENTER	
<table border="1"> <thead> <tr> <th>REV.</th> <th>DATE</th> <th>PROJECT NO.</th> <th>DRAFTING</th> <th>CHKD</th> <th>SUPV</th> <th>ENGR</th> <th>DESCRIPTION</th> </tr> </thead> <tbody> <tr> <td>A</td> <td>03/04/19</td> <td>1704-101</td> <td>CJB</td> <td>DIR</td> <td>DAS</td> <td>ML</td> <td>CONSTRUCTION DRAWINGS</td> </tr> <tr> <td>B</td> <td>3/15/2019</td> <td>1704-101</td> <td>CJB</td> <td>DAS</td> <td>DAS</td> <td>ML</td> <td>FENCE UPDATES</td> </tr> <tr> <td>C</td> <td>5/6/2019</td> <td>1704-101</td> <td>CJB</td> <td></td> <td></td> <td></td> <td>MONITORING UPDATES</td> </tr> <tr> <td>D</td> <td>5/21/2019</td> <td>1704-101</td> <td>CJB</td> <td></td> <td></td> <td></td> <td>SECURITY ENCLOSURE</td> </tr> </tbody> </table>			REV.	DATE	PROJECT NO.	DRAFTING	CHKD	SUPV	ENGR	DESCRIPTION	A	03/04/19	1704-101	CJB	DIR	DAS	ML	CONSTRUCTION DRAWINGS	B	3/15/2019	1704-101	CJB	DAS	DAS	ML	FENCE UPDATES	C	5/6/2019	1704-101	CJB				MONITORING UPDATES	D	5/21/2019	1704-101	CJB				SECURITY ENCLOSURE	DRAWING NO. LC-DWG-ELEC-000002 REVISION NO. 0		
REV.	DATE	PROJECT NO.	DRAFTING	CHKD	SUPV	ENGR	DESCRIPTION																																						
A	03/04/19	1704-101	CJB	DIR	DAS	ML	CONSTRUCTION DRAWINGS																																						
B	3/15/2019	1704-101	CJB	DAS	DAS	ML	FENCE UPDATES																																						
C	5/6/2019	1704-101	CJB				MONITORING UPDATES																																						
D	5/21/2019	1704-101	CJB				SECURITY ENCLOSURE																																						

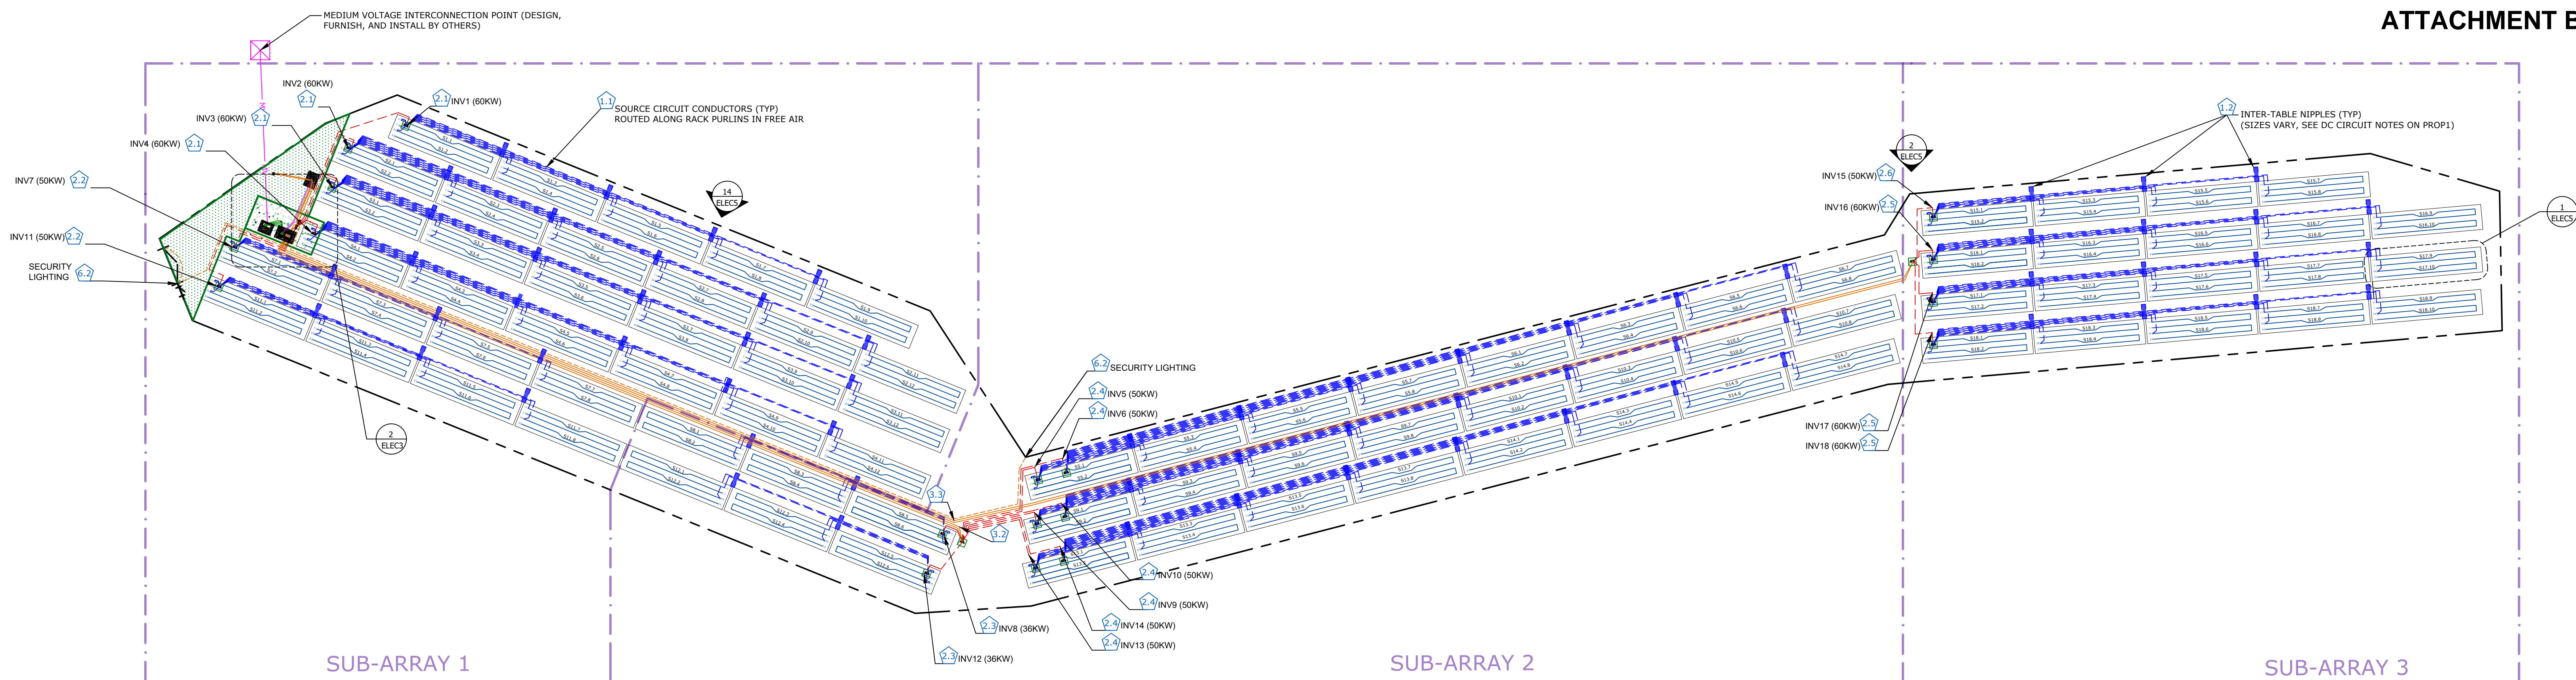

- SHEET NOTES**
- CONTRACTOR IS RESPONSIBLE FOR COMPLIANCE WITH ALL GENERAL NOTES, DC CIRCUIT NOTES, AND AC CIRCUIT NOTES IN DRAWING PACKAGE.
 - REFER TO GENERAL NOTES FOR ELECTRICAL AND EQUIPMENT DEFINITIONS.
 - TRANSFORMER PAD AND TRANSFORMER DESIGNED, FURNISHED, AND INSTALLED BY OTHERS.
 - REFER TO DETAILS SHEET FOR SPECIFIED CALLOUTS.
 - CONTRACTOR SHALL LABEL SOURCE CIRCUIT WIRES AS SPECIFIED ON SHEET. FOR MORE INFORMATION SEE PLACARD AND WIRE LABEL NOTES ON DETAILS AND DATA SHEETS.

SHEET LEGEND

	MODULE INTERCONNECTION STRING
	SOURCE CIRCUITS FROM ARRAYS TO INVERTERS
	INVERTER OUTPUT CIRCUITS FROM INVERTERS TO AC COMBINER PANELS
	COMBINED AC OUTPUT CIRCUITS FROM AC COMBINER PANELS TO MAIN DISTRIBUTION SWITCHBOARD
	RE-COMBINED AC OUTPUT CIRCUITS FROM MAIN DISTRIBUTION SWITCHBOARD TO POINT OF COMMON CONNECTION
	AC CONVENIENCE LOAD CONDUCTORS
	LOW VOLTAGE CONDUCTORS
	MEDIUM VOLTAGE CONDUCTORS (DESIGN, FURNISH, AND INSTALL BY OTHERS)
	SUB-ARRAY

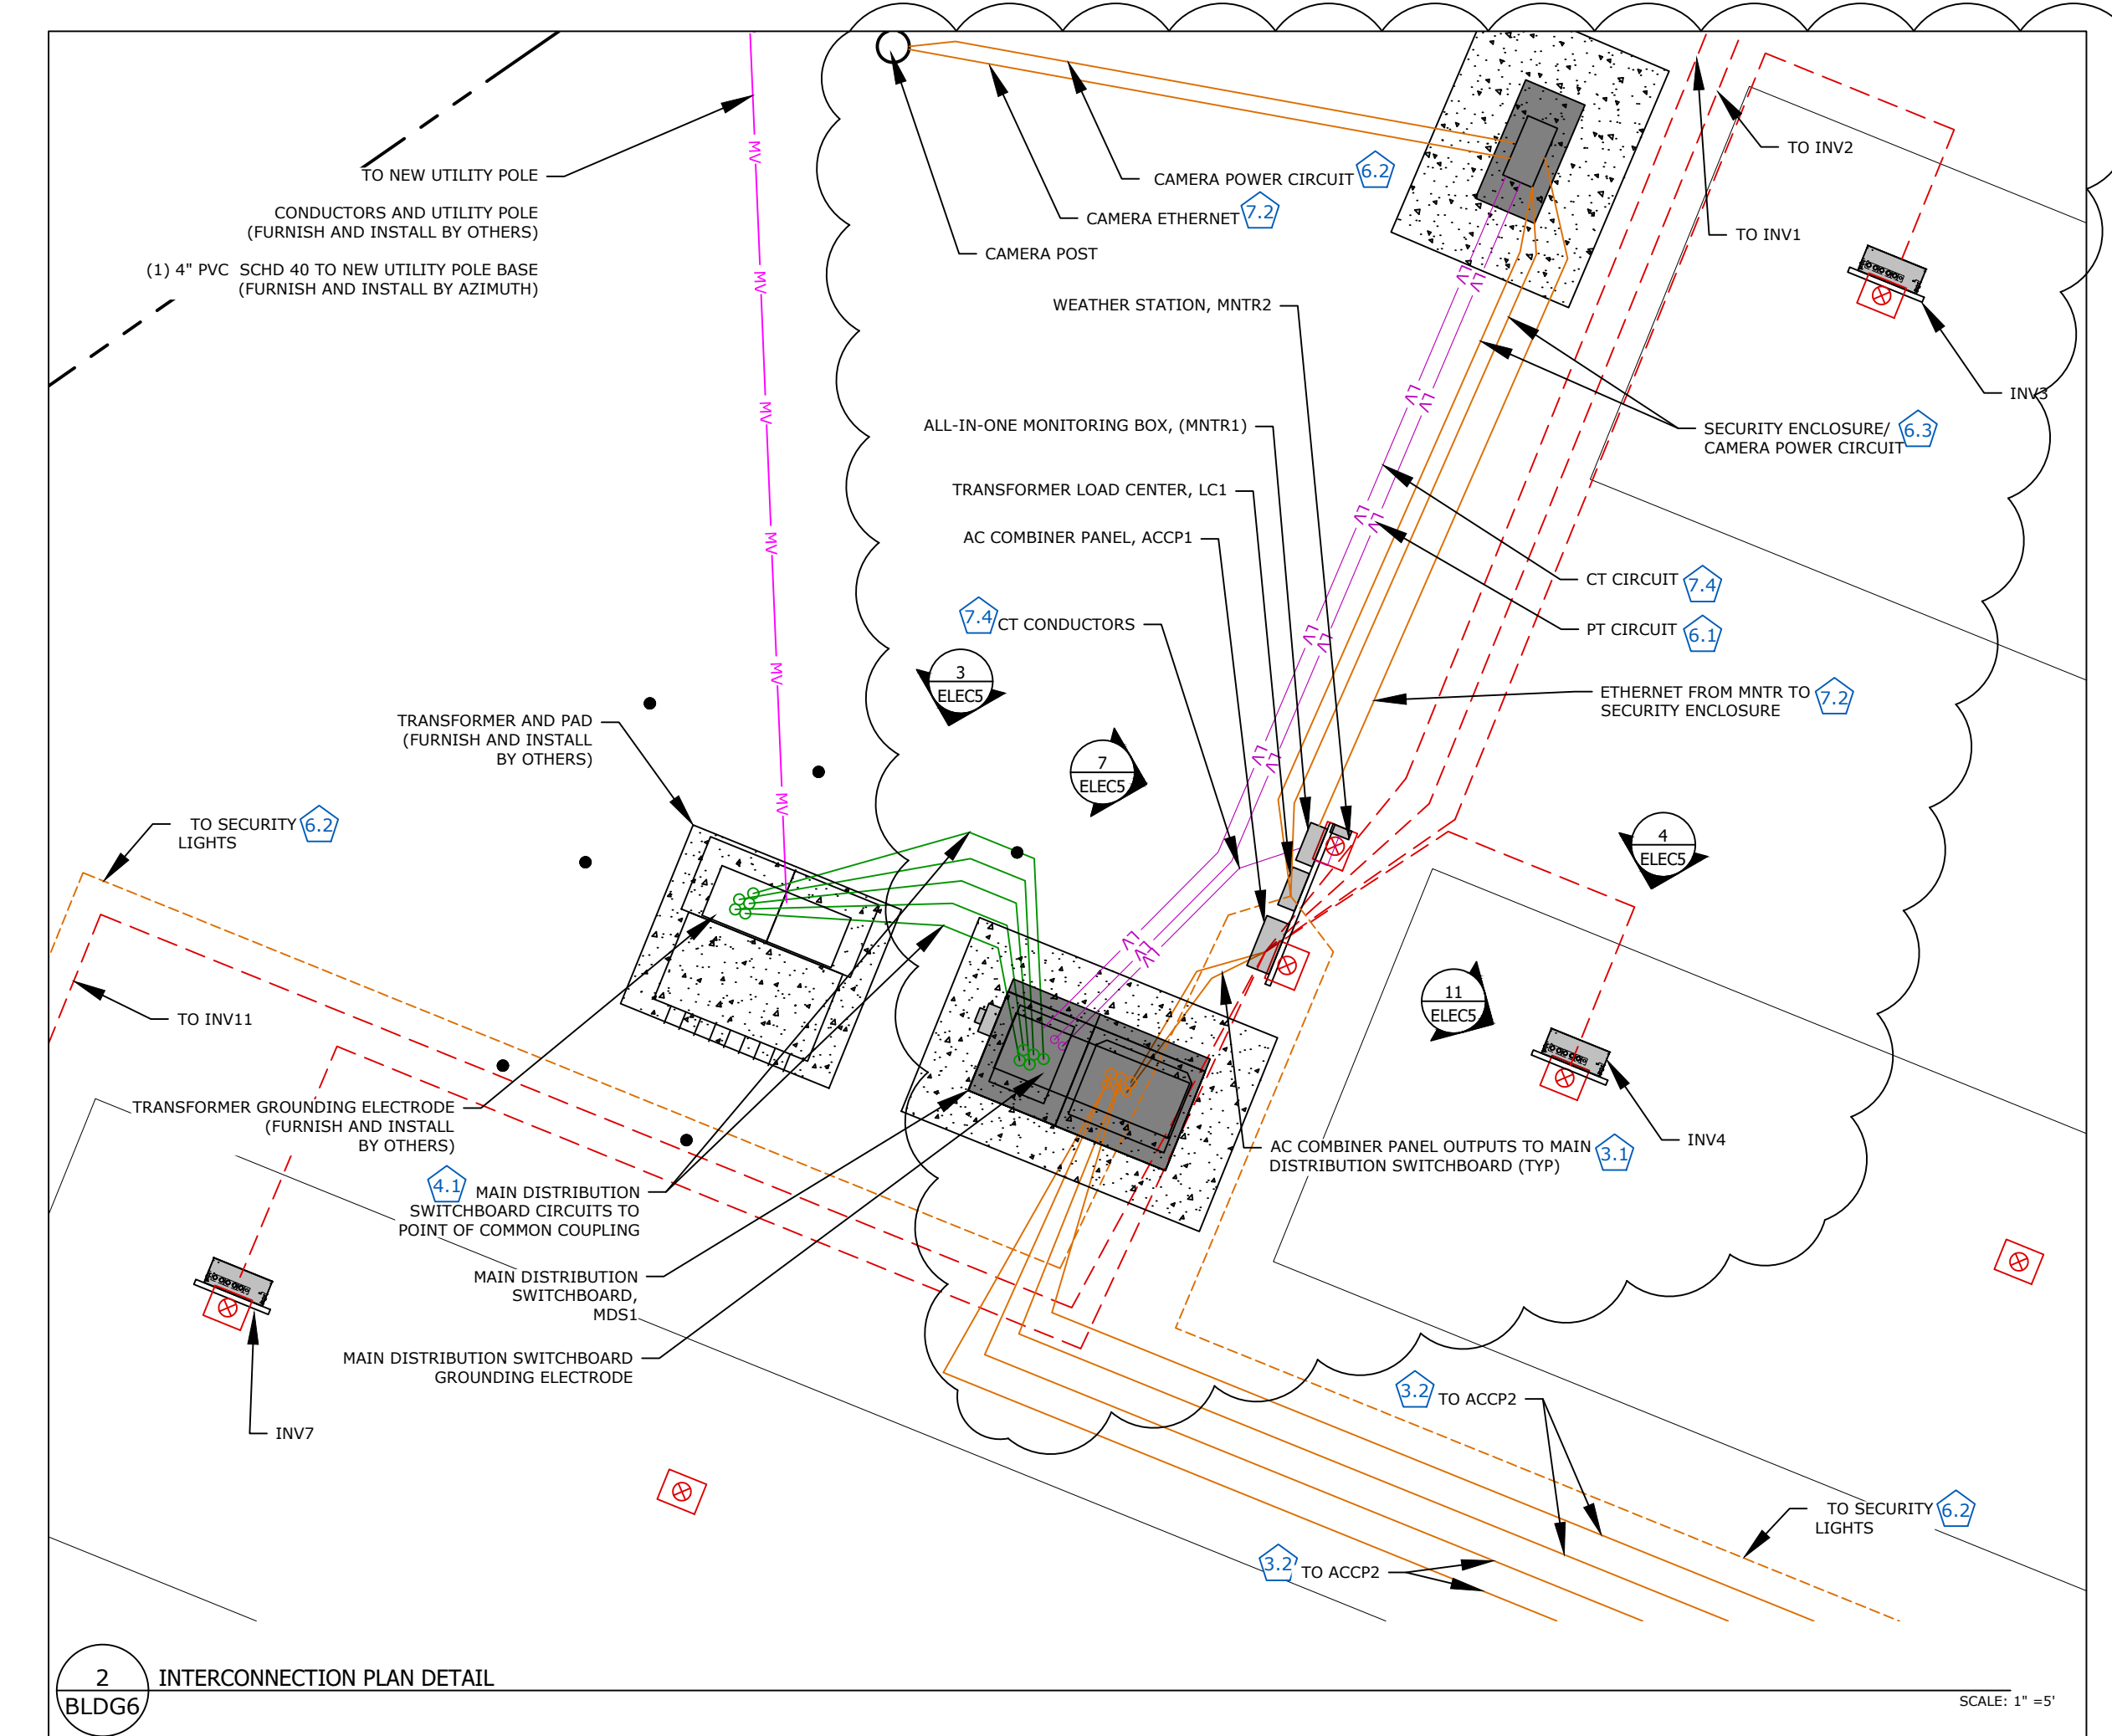

OPERATING DIAGRAM



NOTICE OF LIMITED RESPONSIBILITY
 THE RESPONSIBILITY OF THE UNDERSIGNED ENGINEER IS LIMITED TO THE DESIGN WORK SHOWN ON PROJECT AND DOCUMENTS BEARING HIS/HER SEAL, SIGNATURE OR INITIALS. HE/SHE DOES NOT HAVE AUTHORITY OVER THE PROJECT AS A WHOLE. THE UNDERSIGNED DISCLAIMS ANY RESPONSIBILITY FOR WORK DONE UNDER SUBSEQUENT REVISIONS AND ANY OTHER DOCUMENTS ASSOCIATED WITH THE PROJECT WHICH DO NOT BEAR HIS/HER SEAL, SIGNATURE OR INITIALS.

SCALE: 1" = 40'-0"
 UNIT NO. Y ARCH D (36X24)
 DWG. SIZE
 SUB CLASS

ELECTRICAL PLAN

SITE: AMEREN MISSOURI LAMBERT COMMUNITY SOLAR CENTER
 DRAWING NO. LC-DWG-ELEC-000003
 REVISION NO. 0


REV.	DATE	PROJECT NO.	DRAFTING	DRFTR	CHKD	SUPV	ENGR	DESCRIPTION
A	03/04/19	1704-101	CJB	DIR	DAS	ML		CONSTRUCTION DRAWINGS
B	3/15/2019	1704-101	CJB	DAS	DAS	ML		FENCE UPDATES
C	5/6/2019	1704-101	CJB					MONITORING UPDATES
D	5/21/2019	1704-101	CJB					SECURITY ENCLOSURE

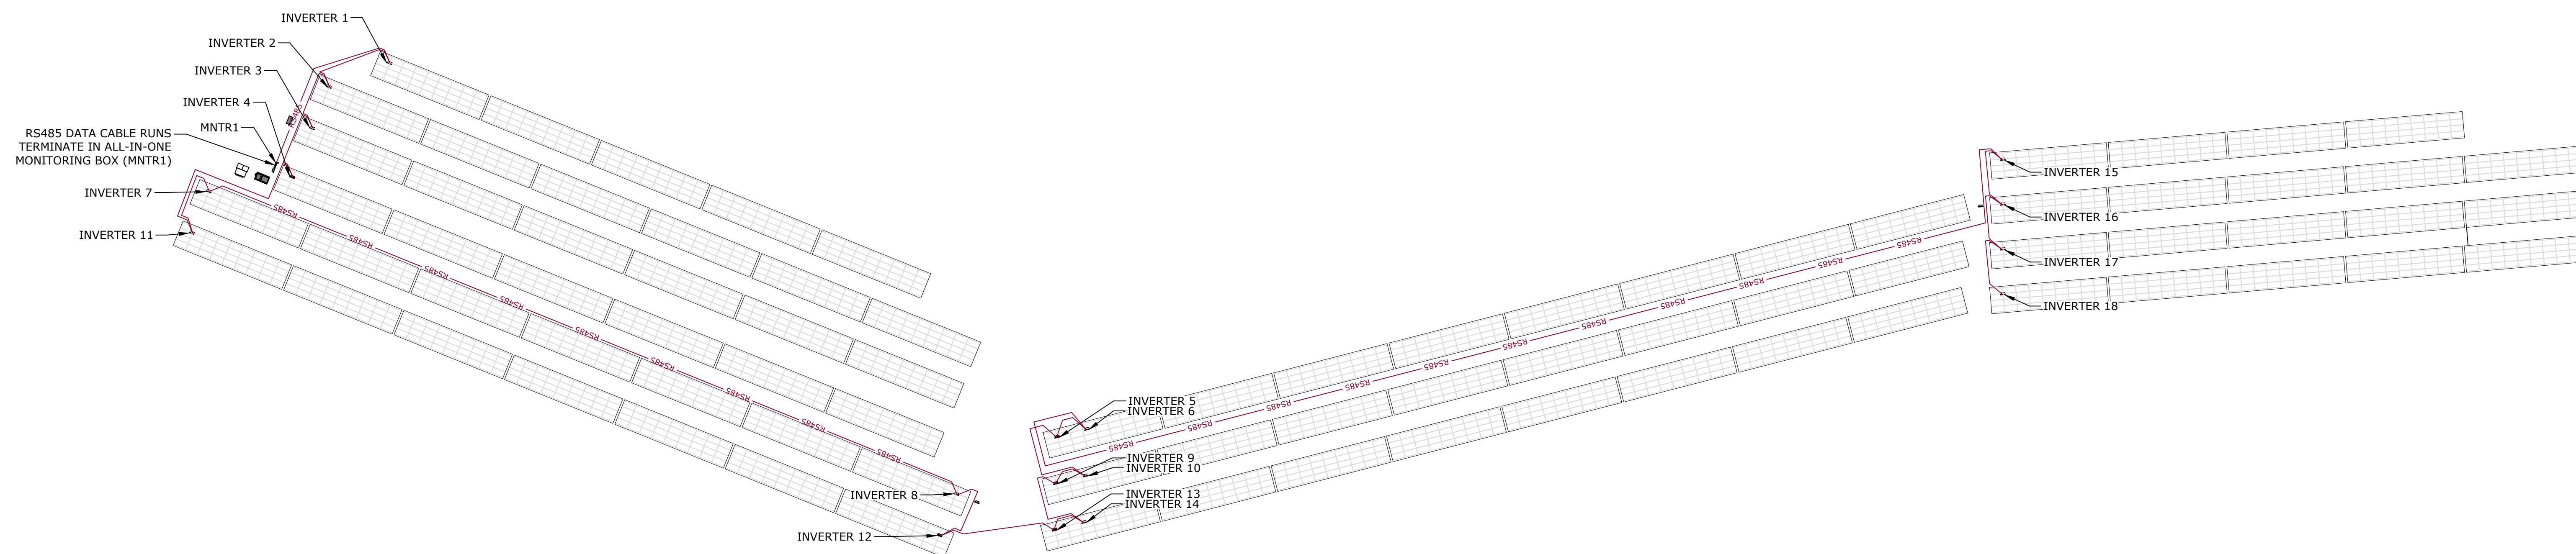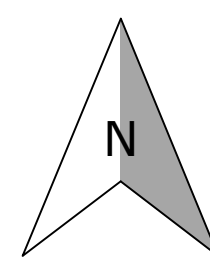

- MONITORING NOTES**
- DAISY-CHAIN RS485 CABLE TO EQUIPMENT AS SHOWN IN MODBUS ADDRESS MAP.
 - ALSO ENERGY DATA LOGGER CONFIGURED TO COMMUNICATE AT A BAUD RATE OF 9600. SOLECTRIA INVERTERS SET TO COMMUNICATE AT THE 9600 BAUD RATE.
 - MODBUS PARITY TO BE SET TO "NONE".
 - REFER TO MANUFACTURER INSTALLATION MATERIAL FOR FURTHER INSTALLATION SPECIFICATIONS.
 - WITHIN A TRENCH, CONDUITS CONTAINING DATA CONDUCTORS AND CONDUITS CONTAINING POWER CONDUCTORS SHALL BE SEPARATED BY A MINIMUM OF 18".
 - RS485 DATA CABLE RUNS SHALL USE 3/4" GALVANIZED RIGID CONDUIT ABOVE GRADE AT CENTRAL HUB, AND 3/4" CONDUIT AT INVERTERS AS SPECIFIED ON ELECS.

SHEET LEGEND
















	SHIELDED RS485 DATA CABLE IN CONDUIT AS SPECIFIED
--	---

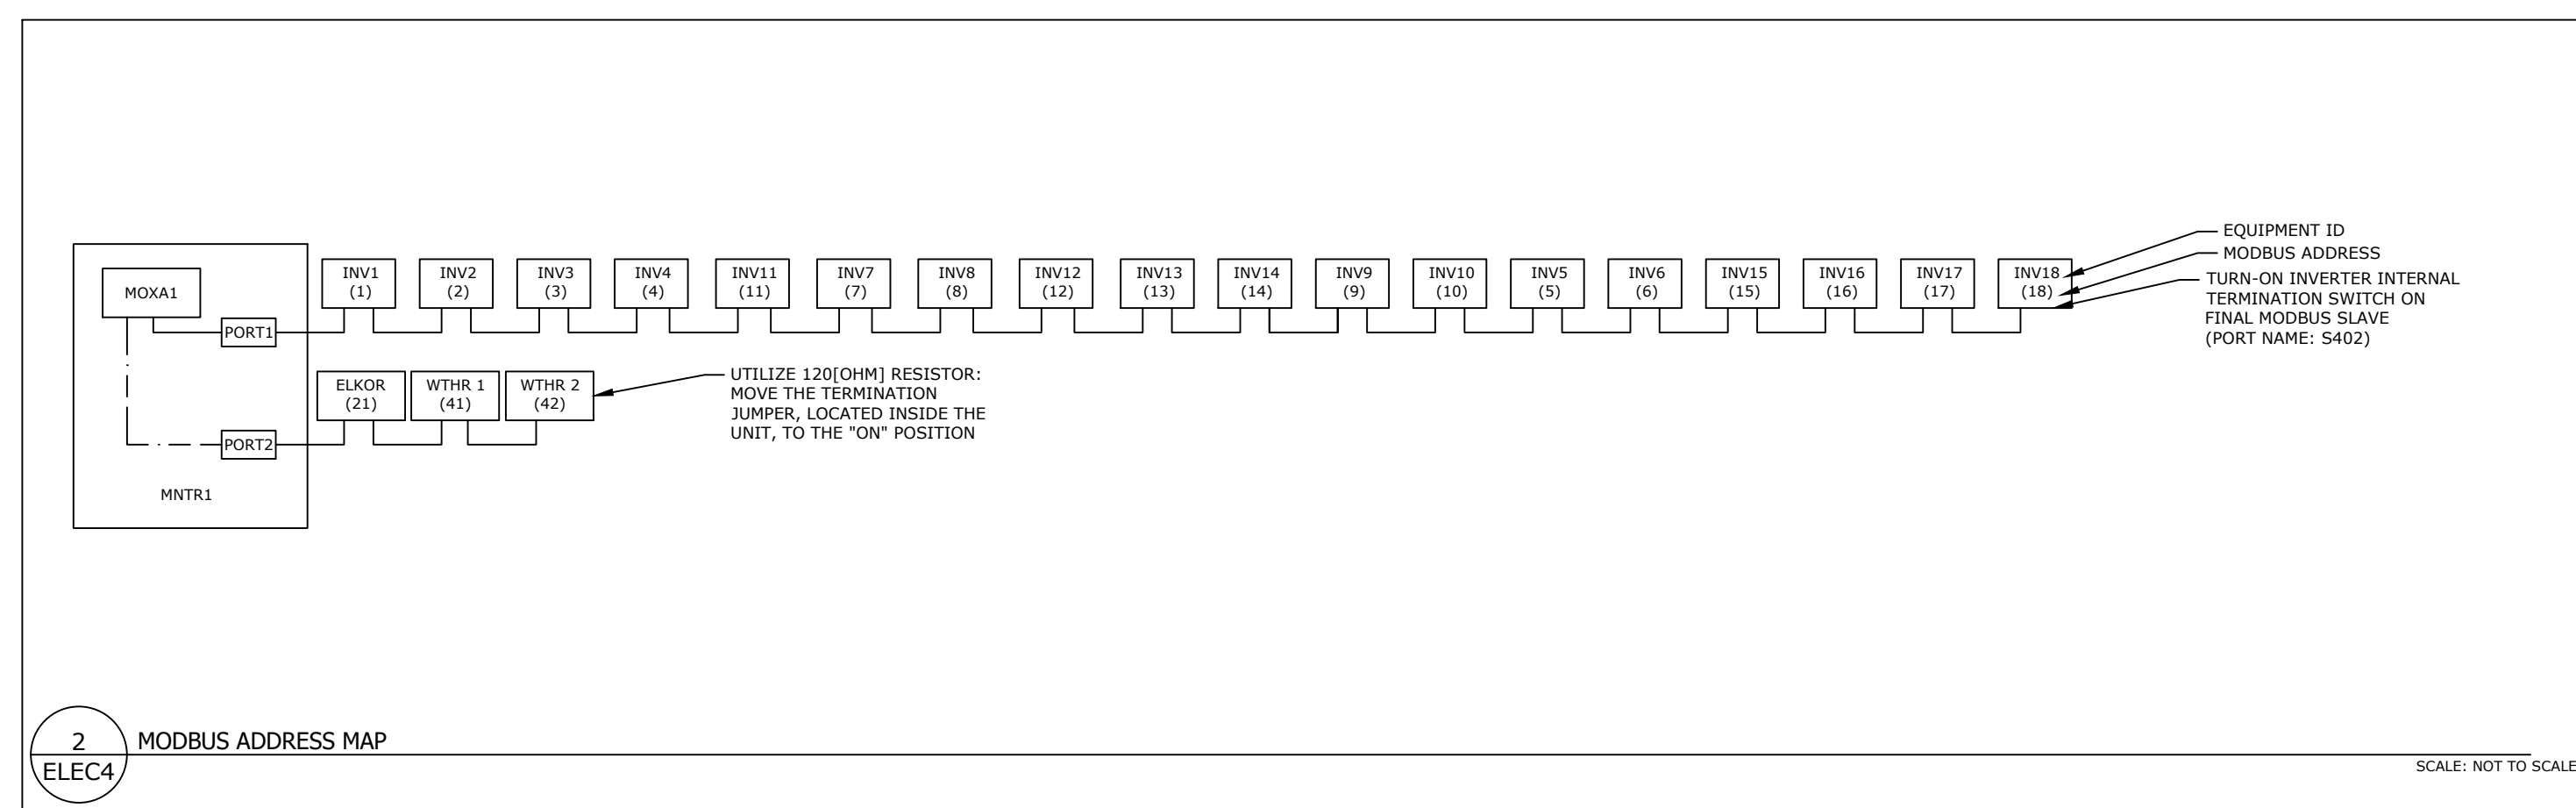

		CERTIFICANTS: MARC LOPATA, PE CERT # 091110-241 DANIEL STROH, EIT CERT # 042013-130				OPERATING DIAGRAM NOTICE OF LIMITED RESPONSIBILITY THE RESPONSIBILITY OF THE UNDERSIGNED ENGINEER IS LIMITED TO THE DESIGN WORK SHOWN ON PROJECT AND DOCUMENTS BEARING HIS/HER SEAL, SIGNATURE OR INITIALS. HE/SHE DOES NOT HAVE AUTHORITY OVER THE PROJECT AS A WHOLE. THE UNDERSIGNED DISCLAIMS ANY RESPONSIBILITY FOR WORK DONE UNDER SUBSEQUENT REVISIONS AND ANY OTHER DOCUMENTS ASSOCIATED WITH THE PROJECT WHICH DO NOT BEAR HIS/HER SEAL, SIGNATURE OR INITIALS.		MARK UP DRAWING NO. --- REV. ---	
		CERTIFICANTS: MARC LOPATA, PE CERT # PVS1-120917-006937		SCALE 1" = 40'-0" UNIT NO. --- DWG. SIZE Y ARCH D (36X24) SUB CLASS ---		MONITORING PLAN SITE: AMEREN MISSOURI LAMBERT COMMUNITY SOLAR CENTER DRAWING NO. LC-DWG-ELEC-000004 REVISION NO. 0	
<table border="1"> <thead> <tr> <th colspan="2">DRAWING RECORD</th> <th colspan="2">DRAFTING</th> <th colspan="2">ENGR</th> <th colspan="2">DESCRIPTION</th> </tr> <tr> <th>REV.</th> <th>DATE</th> <th>PROJECT NO.</th> <th>DRFTR</th> <th>CHKD</th> <th>SUPV</th> <th>ENGR</th> <th>DESCRIPTION</th> </tr> </thead> <tbody> <tr> <td>A</td> <td>03/04/19</td> <td>1704-101</td> <td>CJB</td> <td>DIR</td> <td>DAS</td> <td>ML</td> <td>CONSTRUCTION DRAWINGS</td> </tr> <tr> <td>B</td> <td>3/15/2019</td> <td>1704-101</td> <td>CJB</td> <td>DAS</td> <td>DAS</td> <td>ML</td> <td>FENCE UPDATES</td> </tr> <tr> <td>C</td> <td>5/6/2019</td> <td>1704-101</td> <td>CJB</td> <td></td> <td></td> <td></td> <td>MONITORING UPDATES</td> </tr> <tr> <td>D</td> <td>5/21/2019</td> <td>1704-101</td> <td>CJB</td> <td></td> <td></td> <td></td> <td>SECURITY ENCLOSURE</td> </tr> </tbody> </table>										DRAWING RECORD		DRAFTING		ENGR		DESCRIPTION		REV.	DATE	PROJECT NO.	DRFTR	CHKD	SUPV	ENGR	DESCRIPTION	A	03/04/19	1704-101	CJB	DIR	DAS	ML	CONSTRUCTION DRAWINGS	B	3/15/2019	1704-101	CJB	DAS	DAS	ML	FENCE UPDATES	C	5/6/2019	1704-101	CJB				MONITORING UPDATES	D	5/21/2019	1704-101	CJB				SECURITY ENCLOSURE
DRAWING RECORD		DRAFTING		ENGR		DESCRIPTION	
REV.	DATE	PROJECT NO.	DRFTR	CHKD	SUPV	ENGR	DESCRIPTION	
A	03/04/19	1704-101	CJB	DIR	DAS	ML	CONSTRUCTION DRAWINGS	
B	3/15/2019	1704-101	CJB	DAS	DAS	ML	FENCE UPDATES	
C	5/6/2019	1704-101	CJB				MONITORING UPDATES	
D	5/21/2019	1704-101	CJB				SECURITY ENCLOSURE	

ATTACHMENT B

INVERTER (TYPICAL)		AC COMBINER PANEL (TYPICAL)	
<p>WARNING ELECTRICAL SHOCK HAZARD DO NOT TOUCH TERMINALS TERMINALS ON BOTH LINE AND LOAD SIDES MAY BE ENERGIZED IN THE OPEN POSITION</p> <p>WARNING ELECTRICAL SHOCK HAZARD DO NOT TOUCH TERMINALS THE PHOTOVOLTAIC SYSTEM ARE ENERGIZED AND LOAD SIDES MAY BE ENERGIZED IN THE OPEN POSITION</p>	<p>WARNING TURN OFF PHOTOVOLTAIC AC DISCONNECT PRIOR TO WORKING INSIDE PANEL</p> <p>WARNING ELECTRICAL SHOCK HAZARD DO NOT TOUCH TERMINALS TERMINALS ON BOTH LINE AND LOAD SIDES MAY BE ENERGIZED IN THE OPEN POSITION</p>	<p>WARNING ELECTRICAL SHOCK HAZARD DO NOT TOUCH TERMINALS TERMINALS ON BOTH LINE AND LOAD SIDES MAY BE ENERGIZED IN THE OPEN POSITION</p> <p>WARNING ELECTRICAL SHOCK HAZARD DO NOT TOUCH TERMINALS TERMINALS ON BOTH LINE AND LOAD SIDES MAY BE ENERGIZED IN THE OPEN POSITION</p>	<p>WARNING ELECTRICAL SHOCK HAZARD DO NOT TOUCH TERMINALS TERMINALS ON BOTH LINE AND LOAD SIDES MAY BE ENERGIZED IN THE OPEN POSITION</p>
<p>INVERTER 1, 16, 17, 18</p> <p>PHOTOVOLTAIC DC DISCONNECT RATED MAX POWER POINT CURRENT: 79 AMPS RATED MAX POWER POINT VOLTAGE: 733 VDC MAXIMUM CIRCUIT CURRENT: 100 AMPS MAXIMUM SYSTEM VOLTAGE: 600 VDC</p>	<p>INVERTER 2, 3, 4</p> <p>PHOTOVOLTAIC DC DISCONNECT RATED MAX POWER POINT CURRENT: 111 AMPS RATED MAX POWER POINT VOLTAGE: 733 VDC MAXIMUM CIRCUIT CURRENT: 133 AMPS MAXIMUM SYSTEM VOLTAGE: 600 VDC</p>	<p>INVERTER 5, 6, 7, 8, 10, 11, 13, 14, 15</p> <p>PHOTOVOLTAIC DC DISCONNECT RATED MAX POWER POINT CURRENT: 81 AMPS RATED MAX POWER POINT VOLTAGE: 733 VDC MAXIMUM CIRCUIT CURRENT: 97 AMPS MAXIMUM SYSTEM VOLTAGE: 600 VDC</p>	<p>INVERTER 9, 12</p> <p>PHOTOVOLTAIC DC DISCONNECT RATED MAX POWER POINT CURRENT: 81 AMPS RATED MAX POWER POINT VOLTAGE: 733 VDC MAXIMUM CIRCUIT CURRENT: 97 AMPS MAXIMUM SYSTEM VOLTAGE: 600 VDC</p>
<p>INVERTER #</p> <p>PHOTOVOLTAIC AC DISCONNECT RATED MAX POWER POINT CURRENT: 488 AMPS RATED MAX POWER POINT VOLTAGE: 488 VAC NOMINAL OPERATING AC VOLTAGE: 480 VAC</p>	<p>AC COMBINER PANEL</p> <p>PHOTOVOLTAIC AC DISCONNECT RATED MAX POWER POINT CURRENT: 488 AMPS RATED MAX POWER POINT VOLTAGE: 488 VAC NOMINAL OPERATING AC VOLTAGE: 480 VAC</p>	<p>ACCP1</p> <p>PHOTOVOLTAIC AC DISCONNECT RATED MAX 



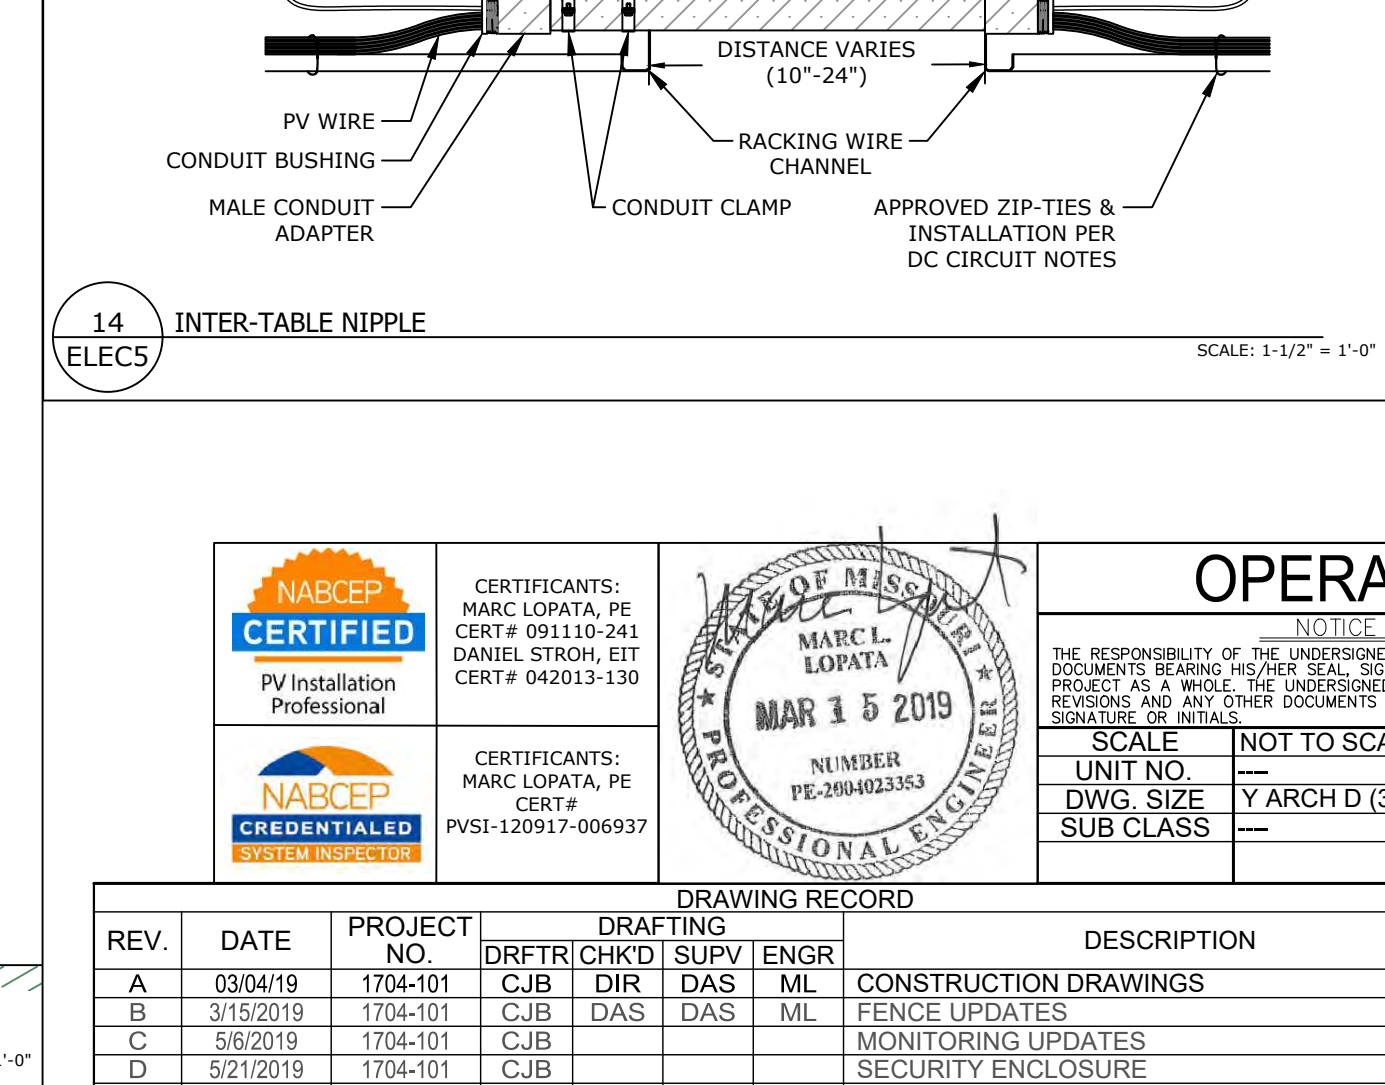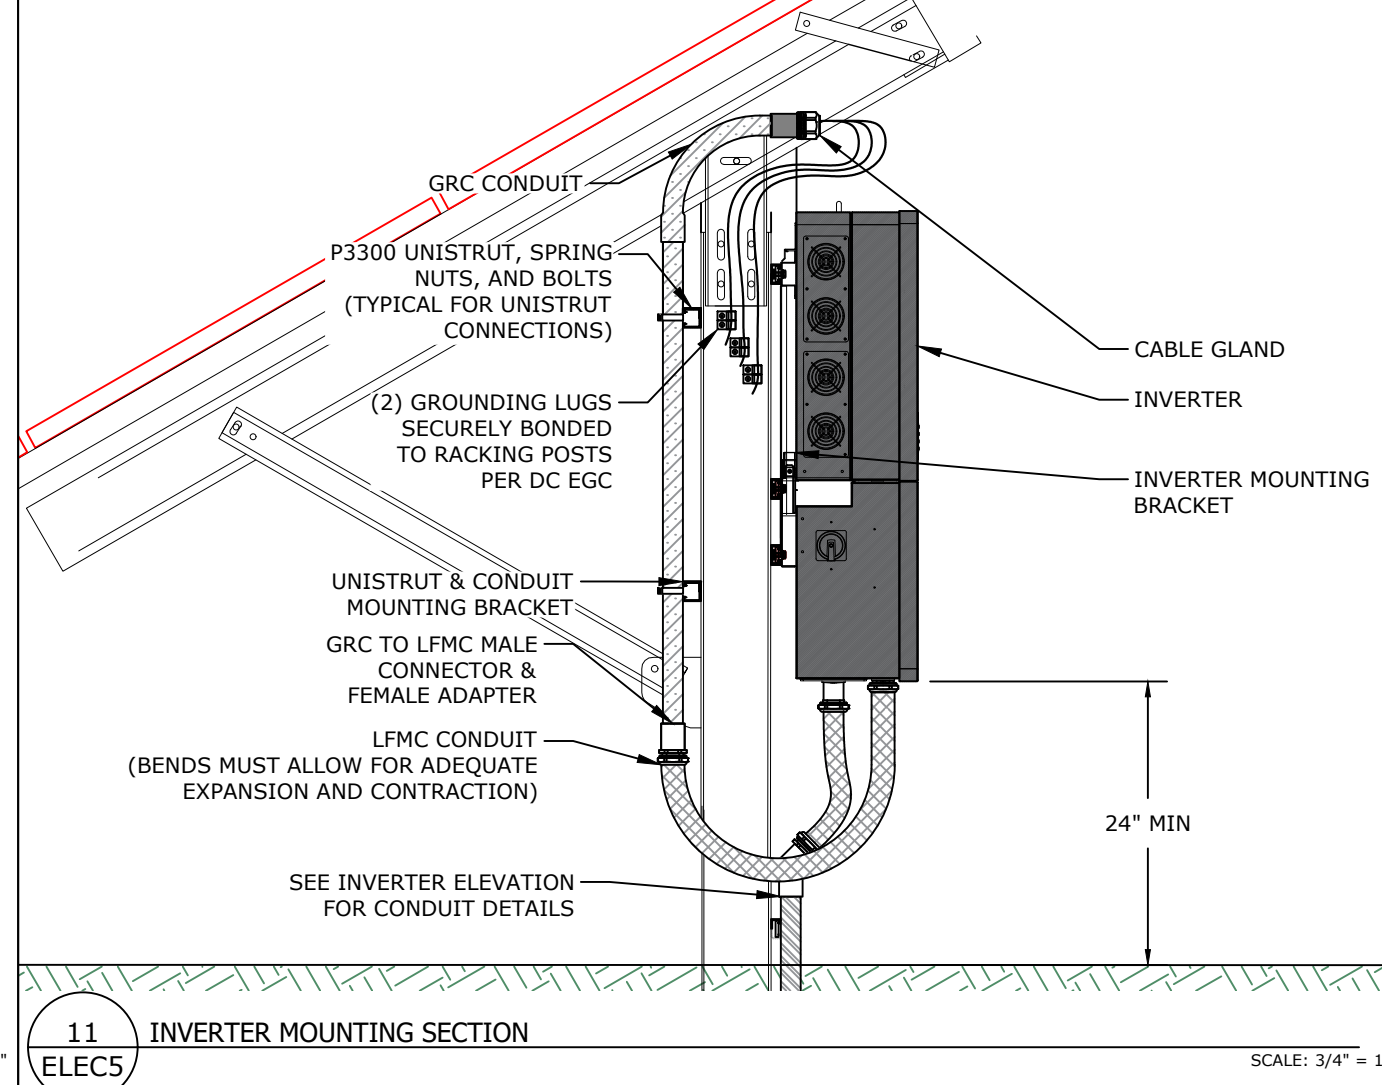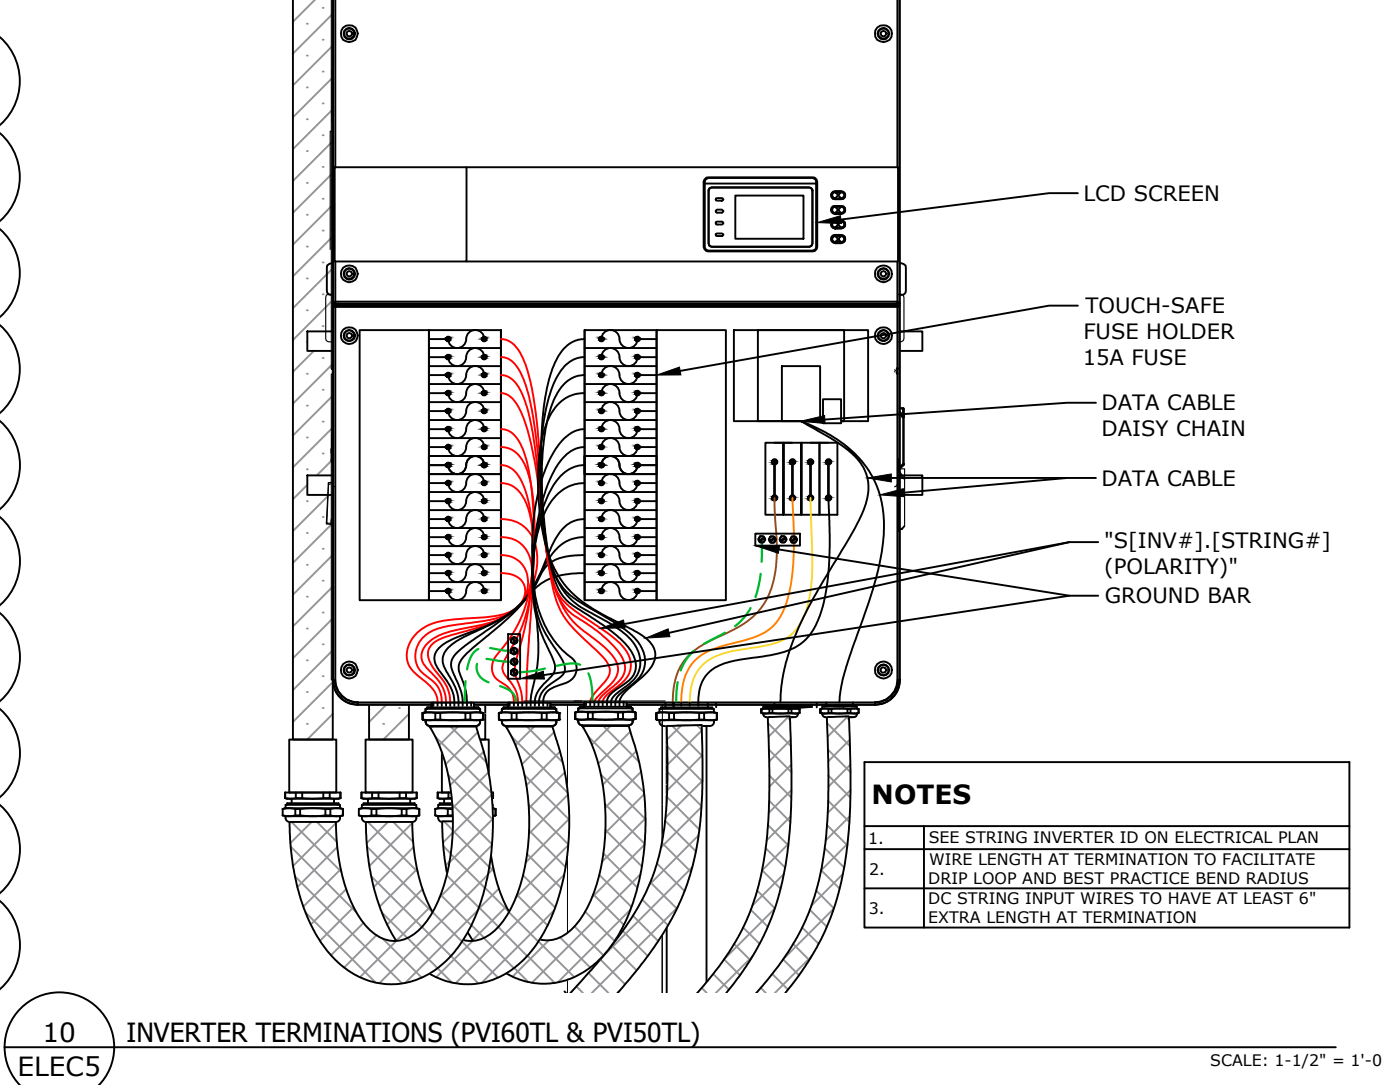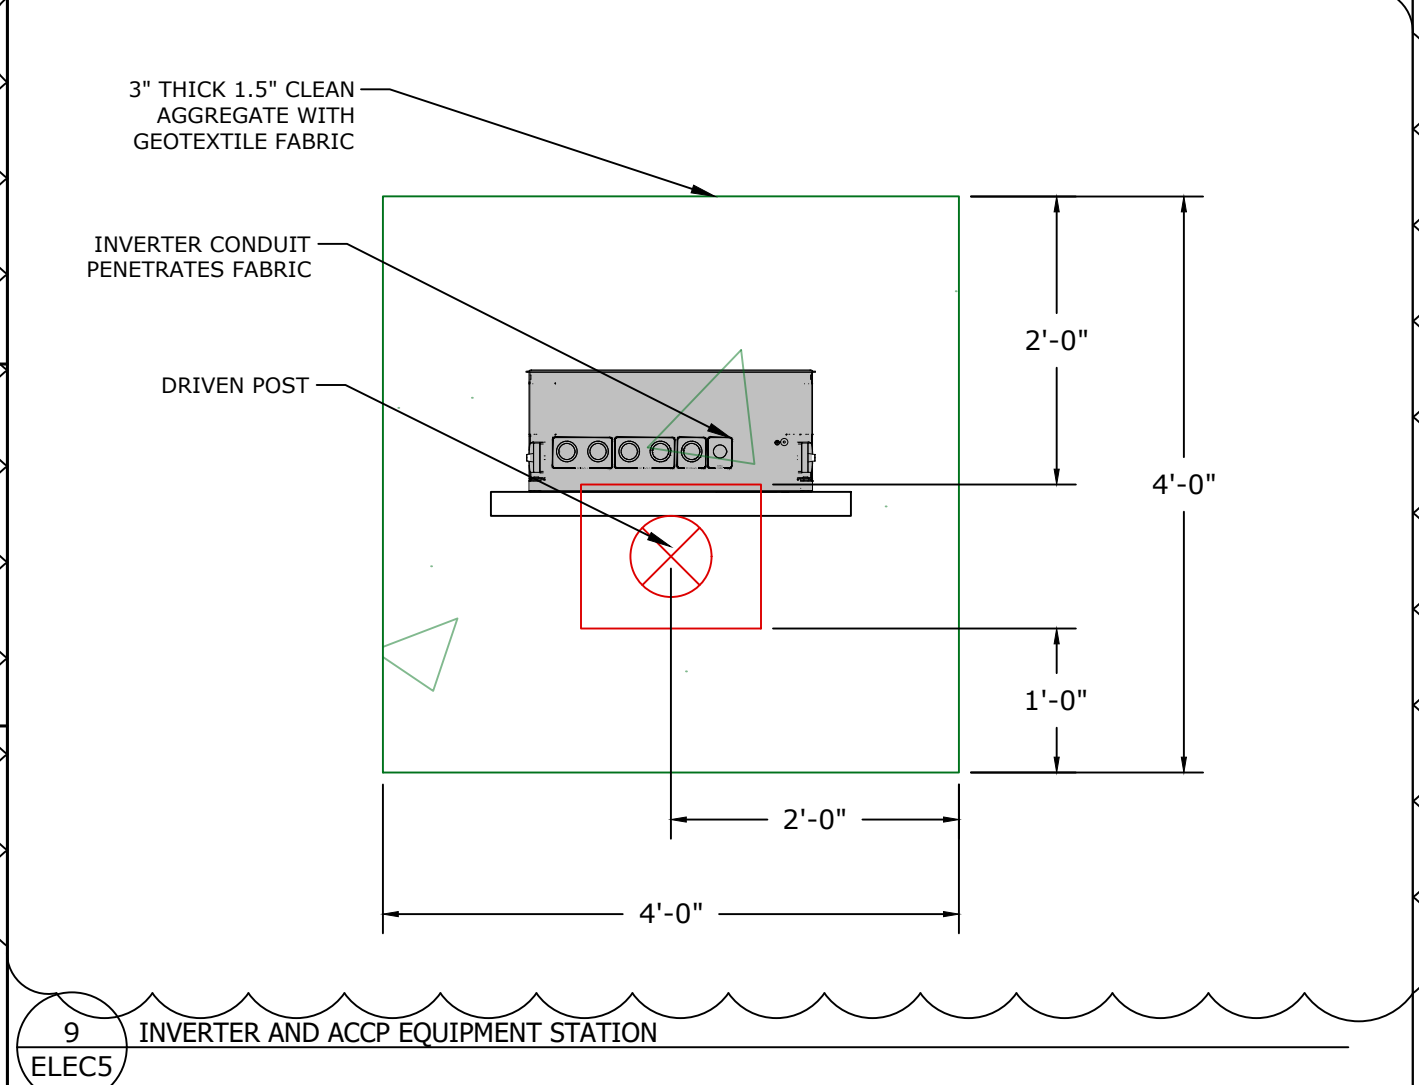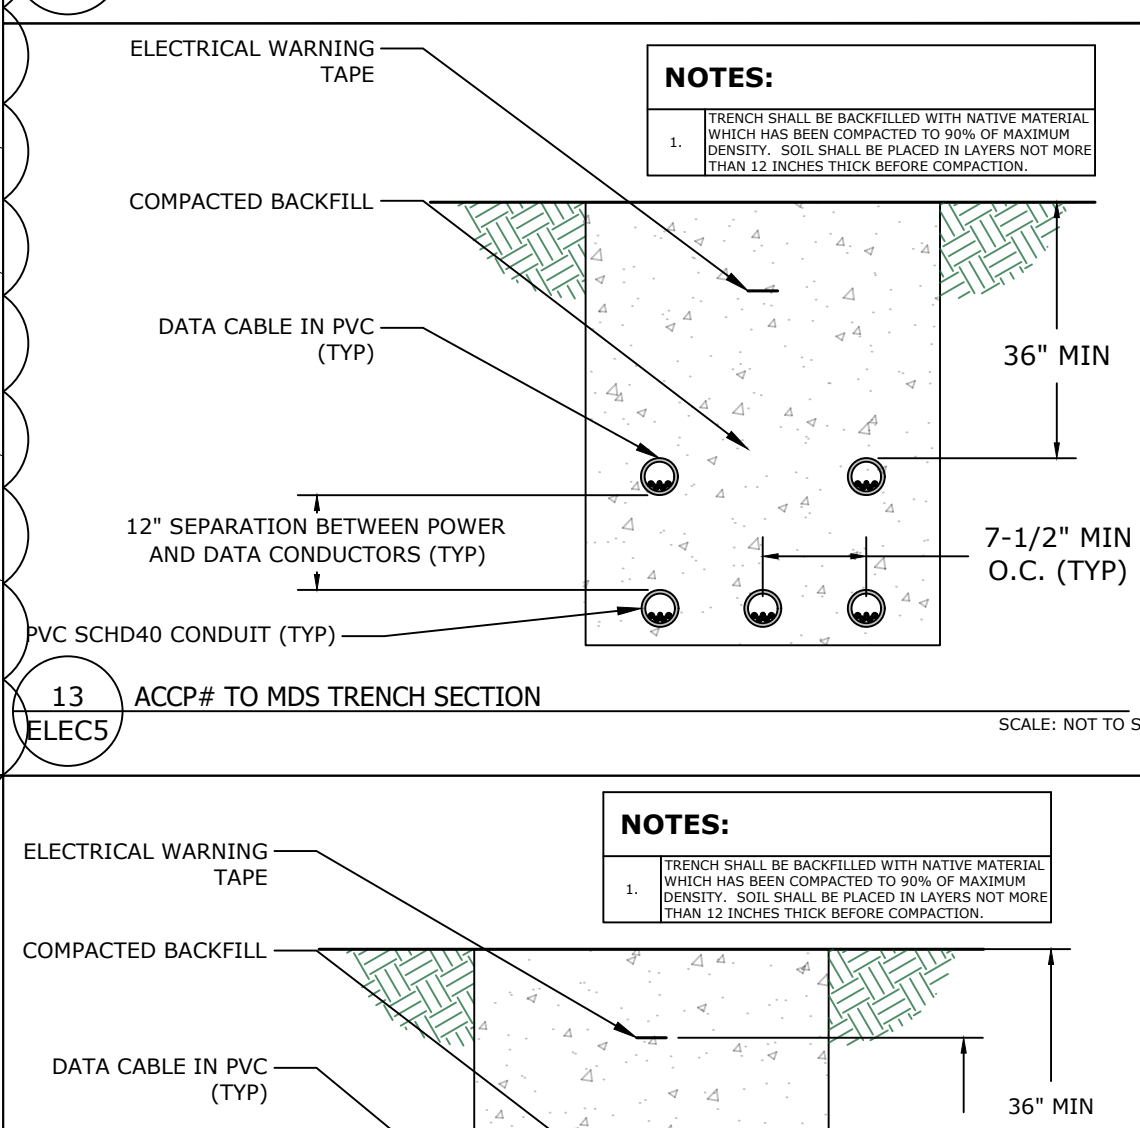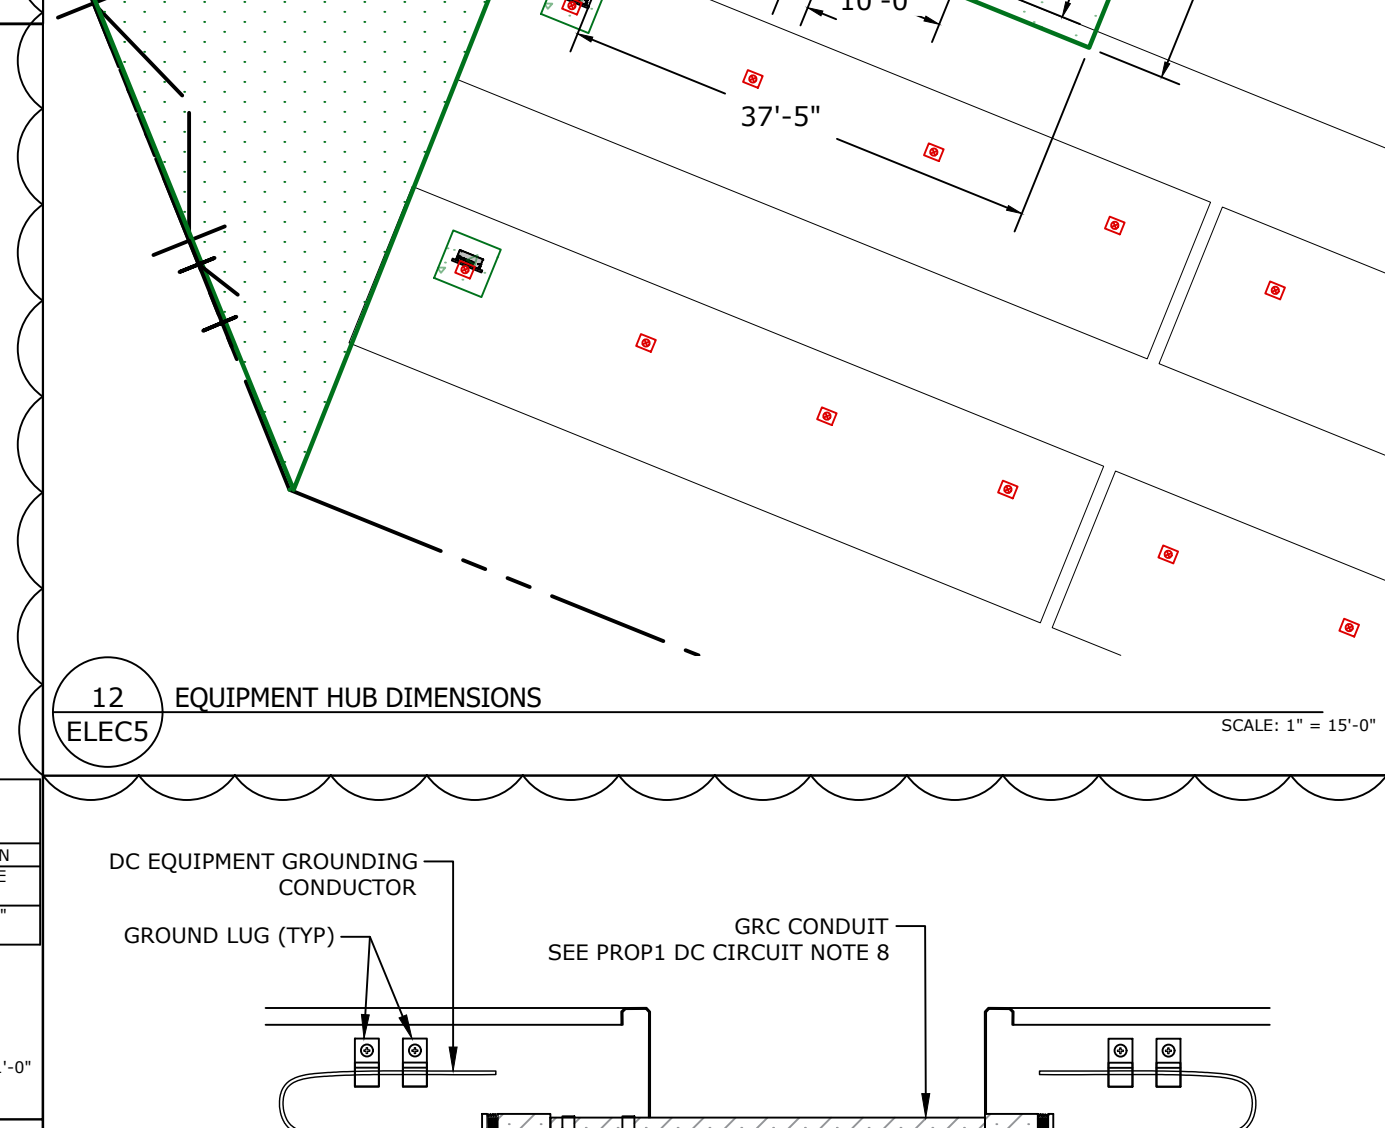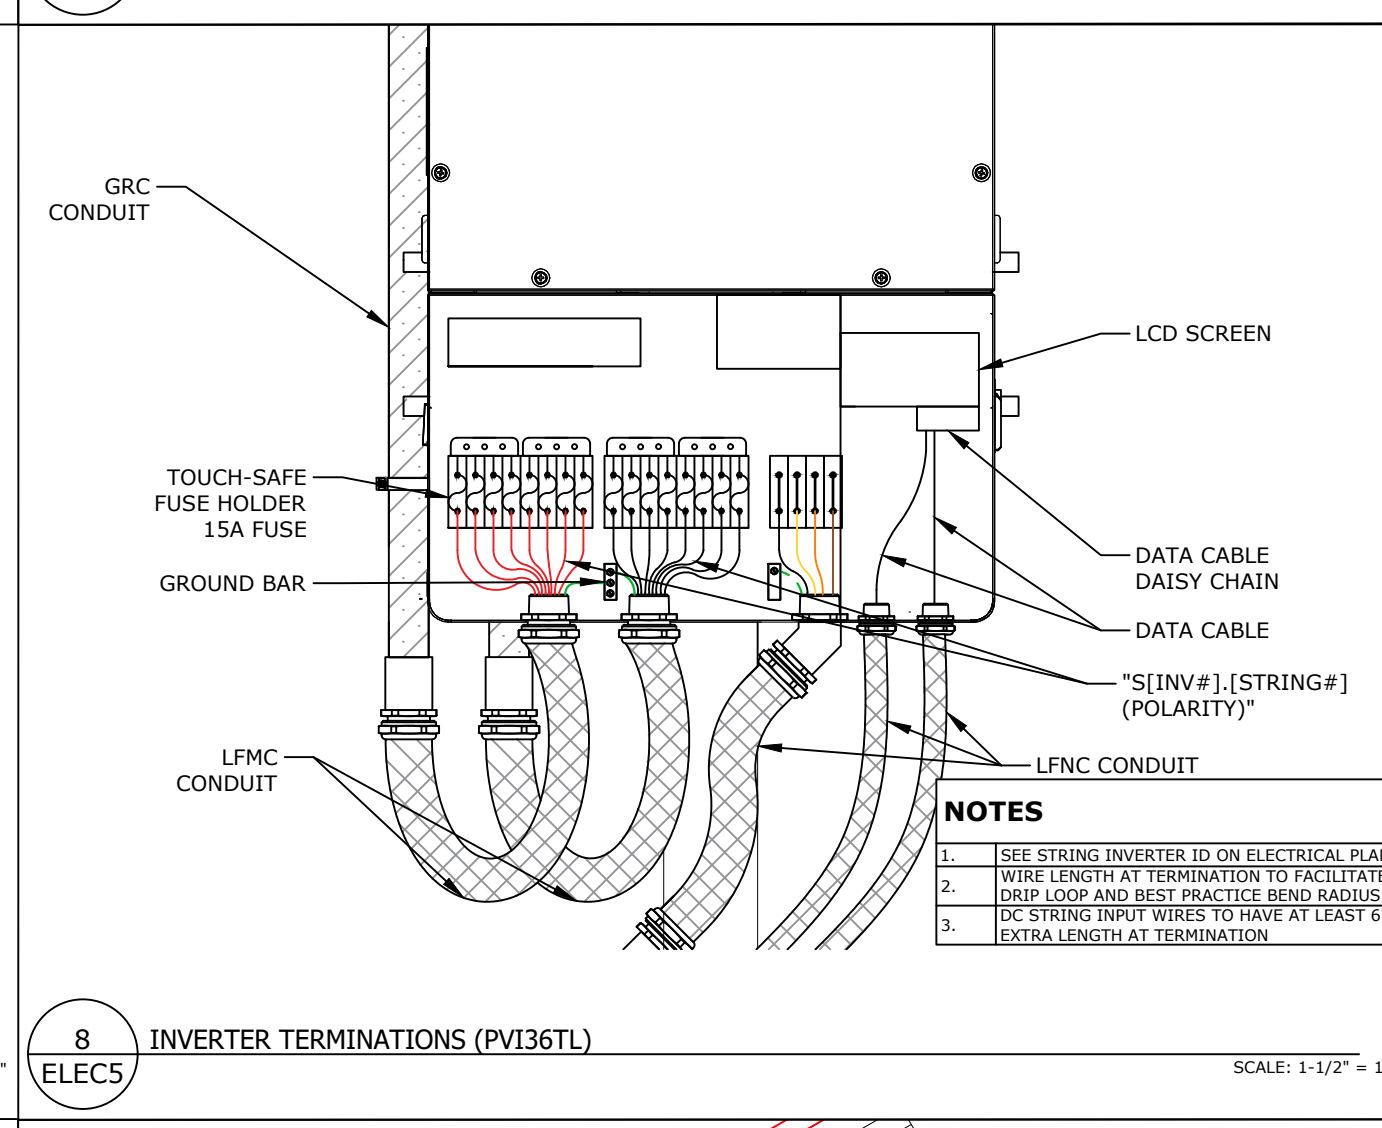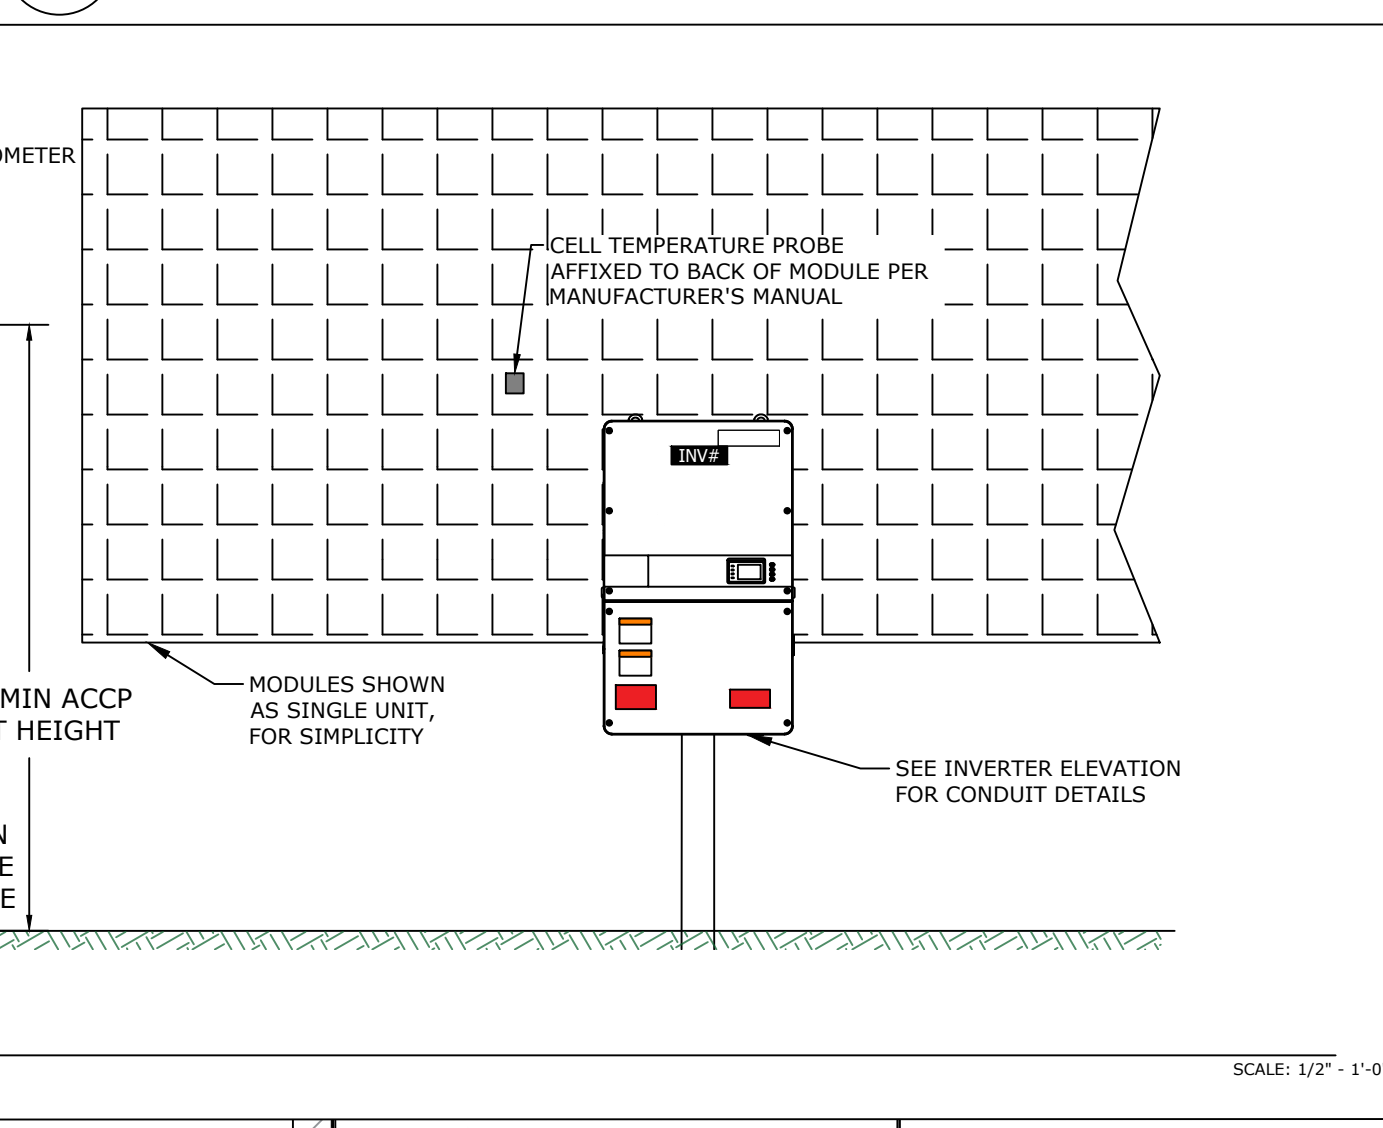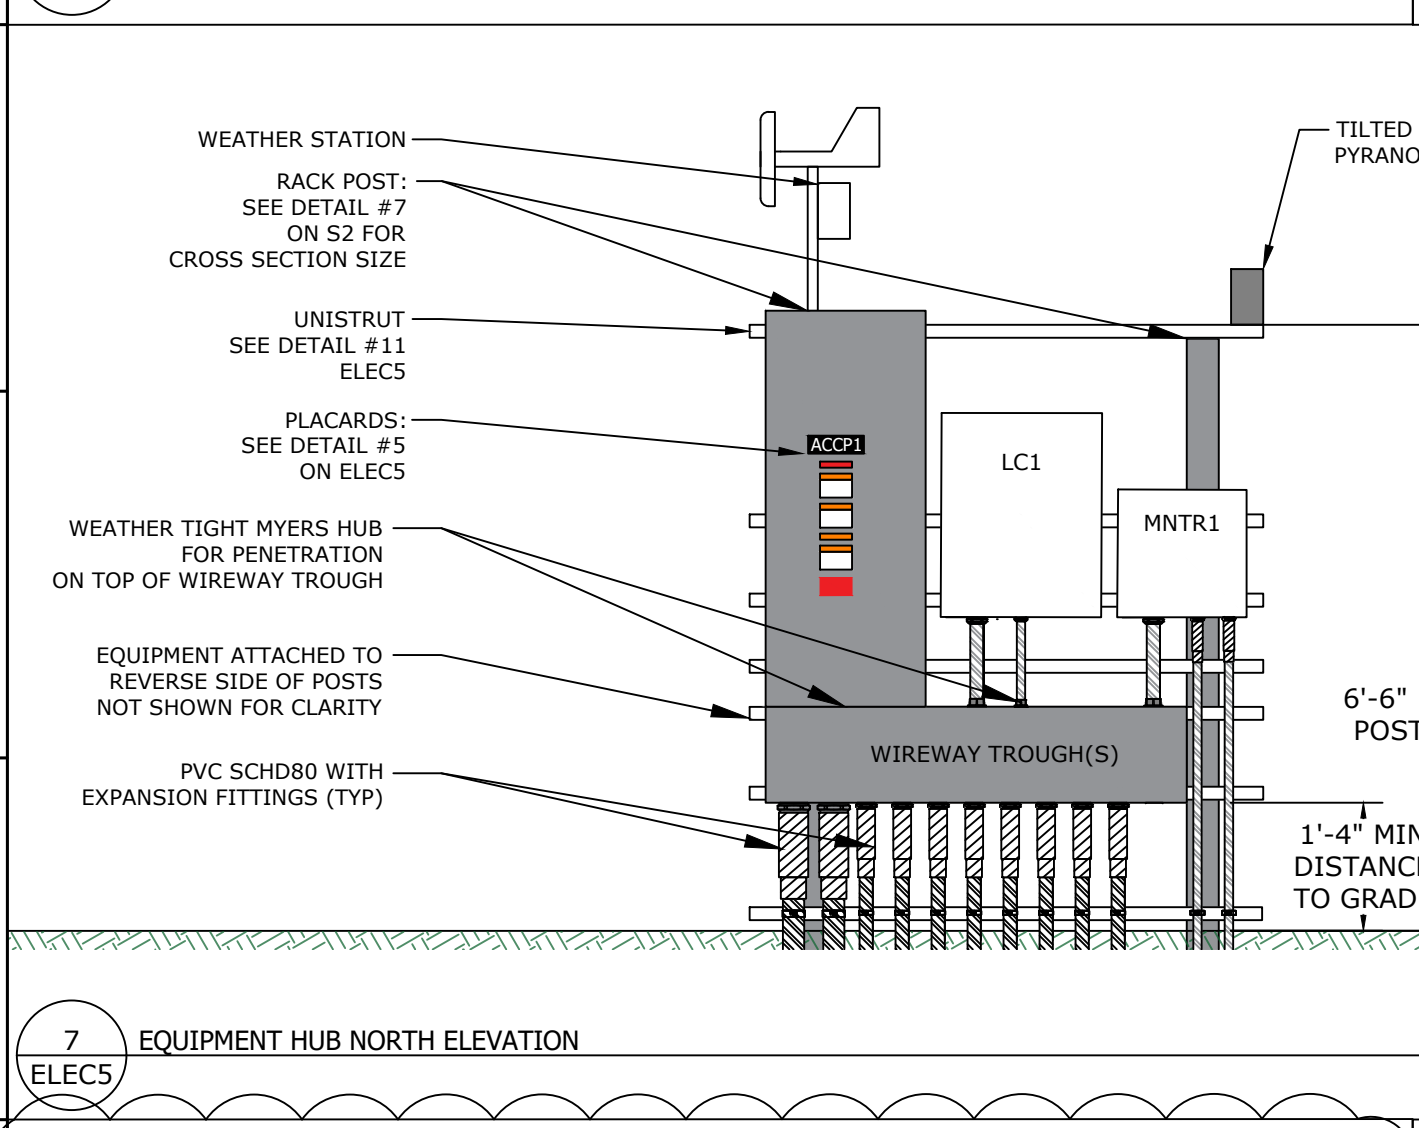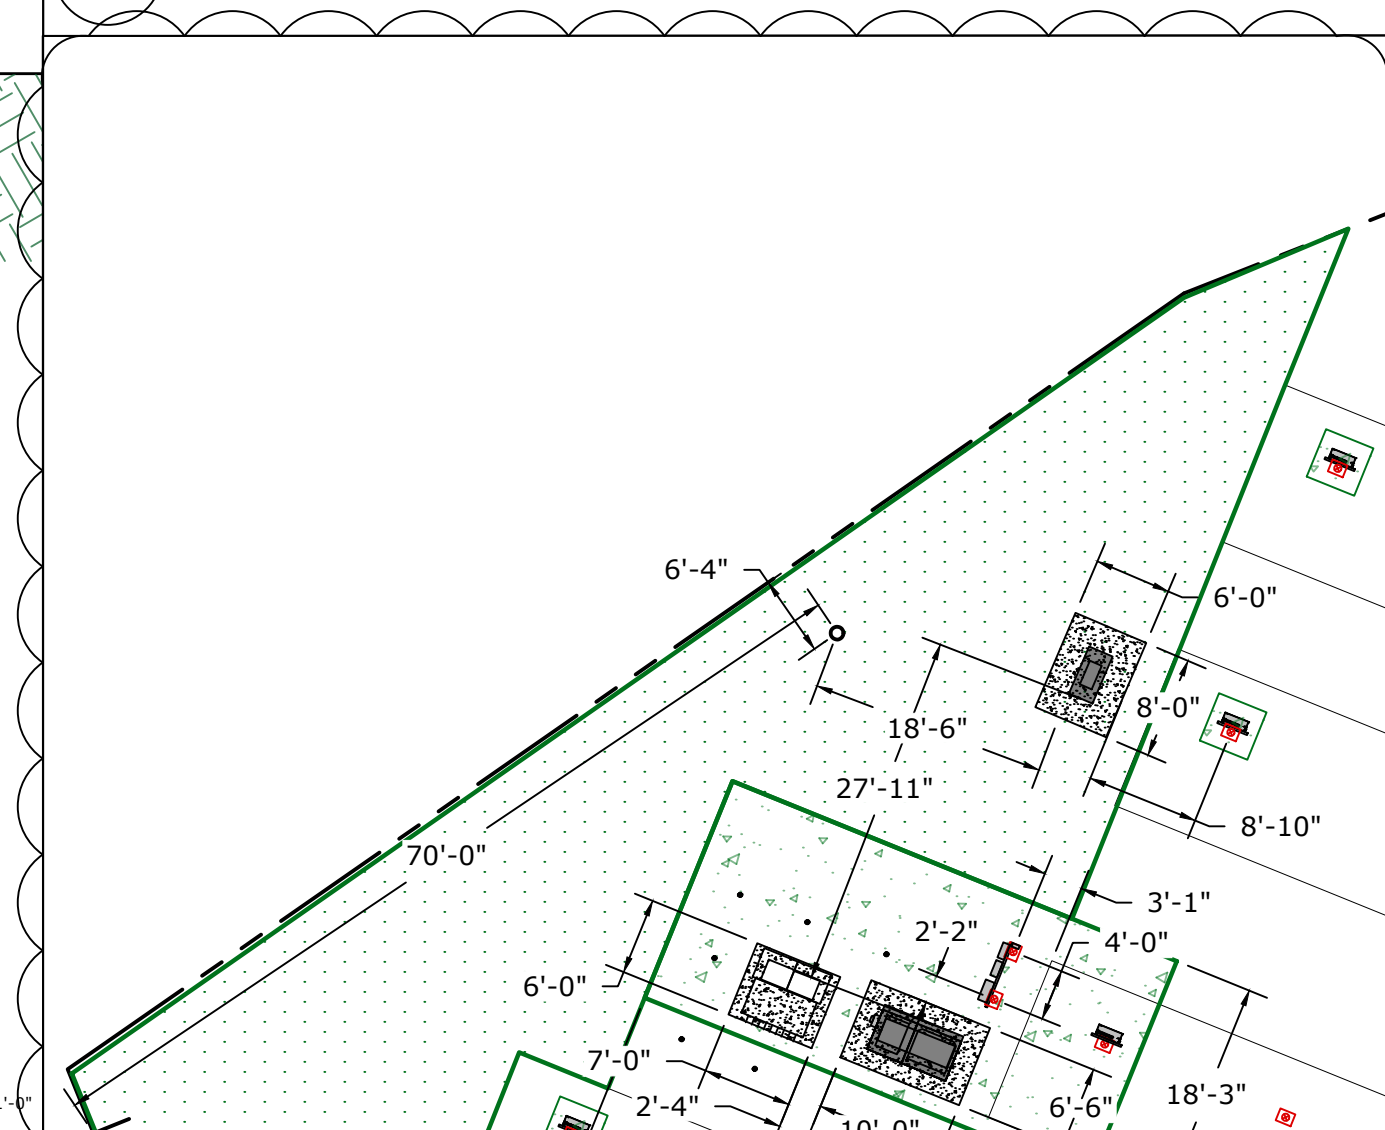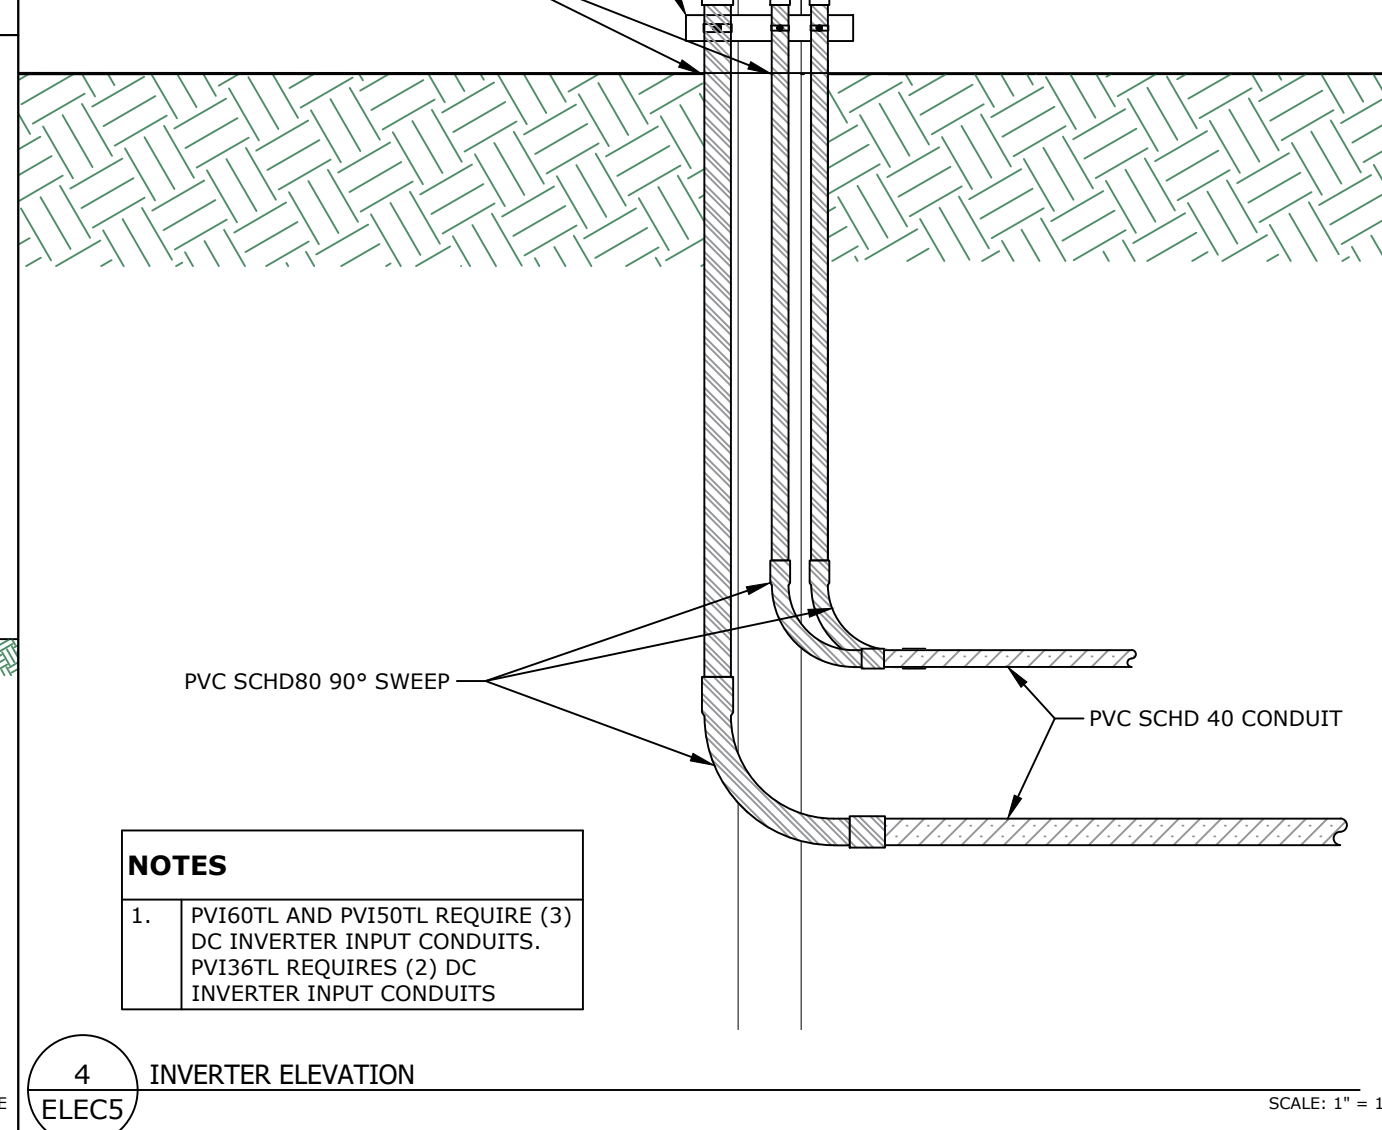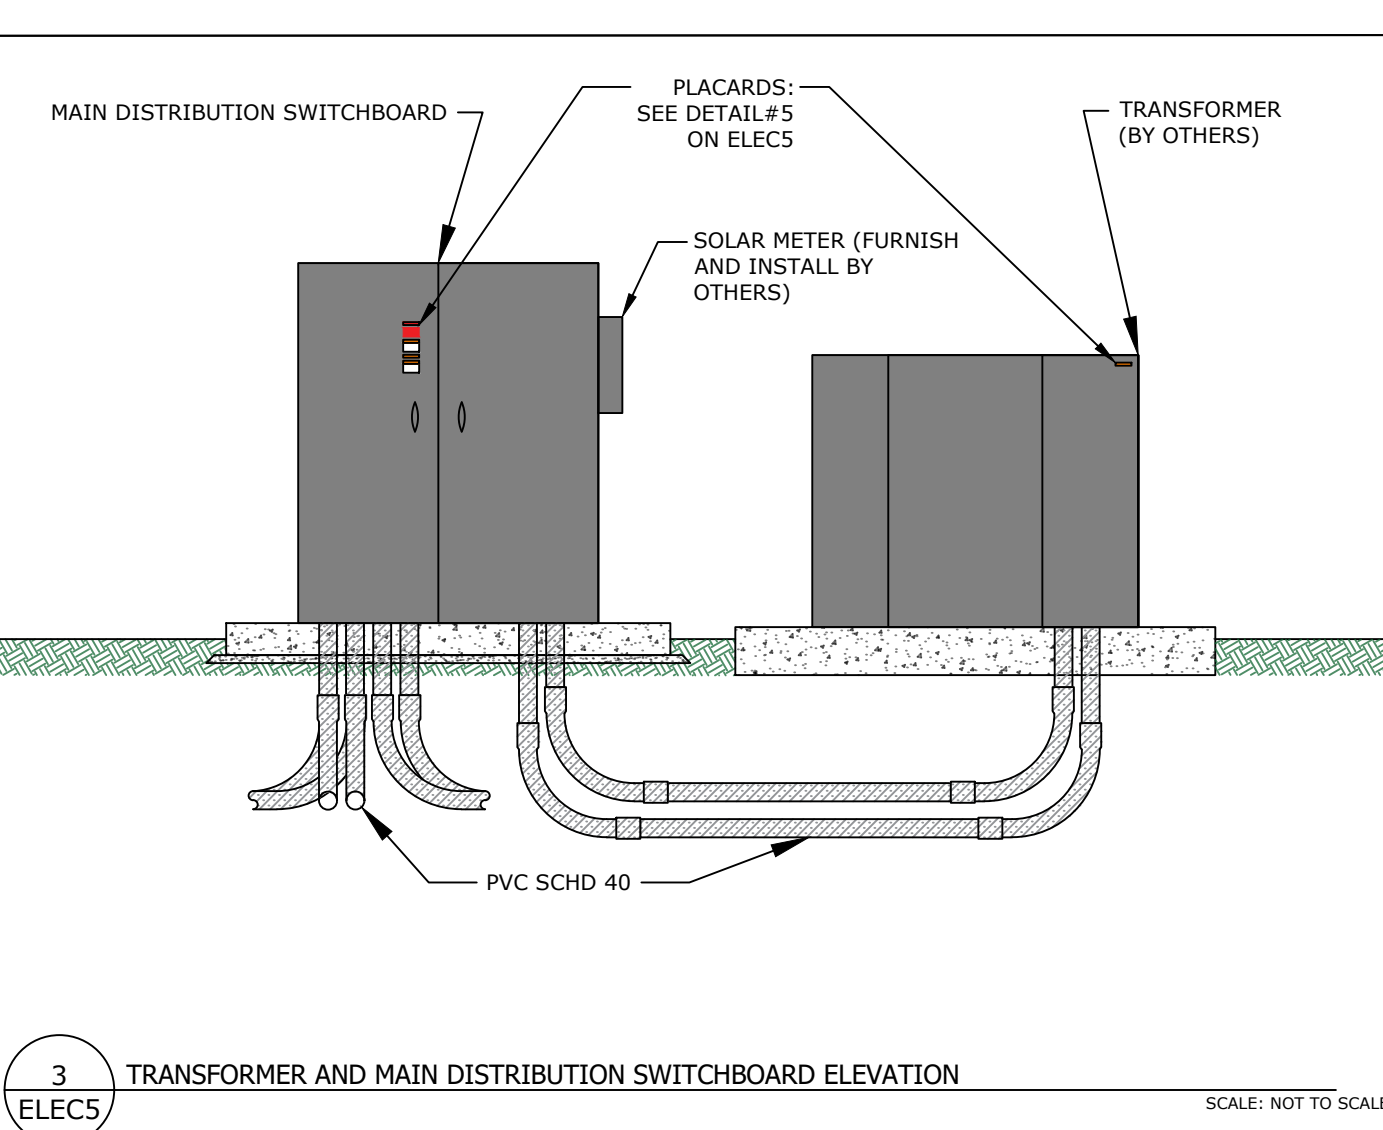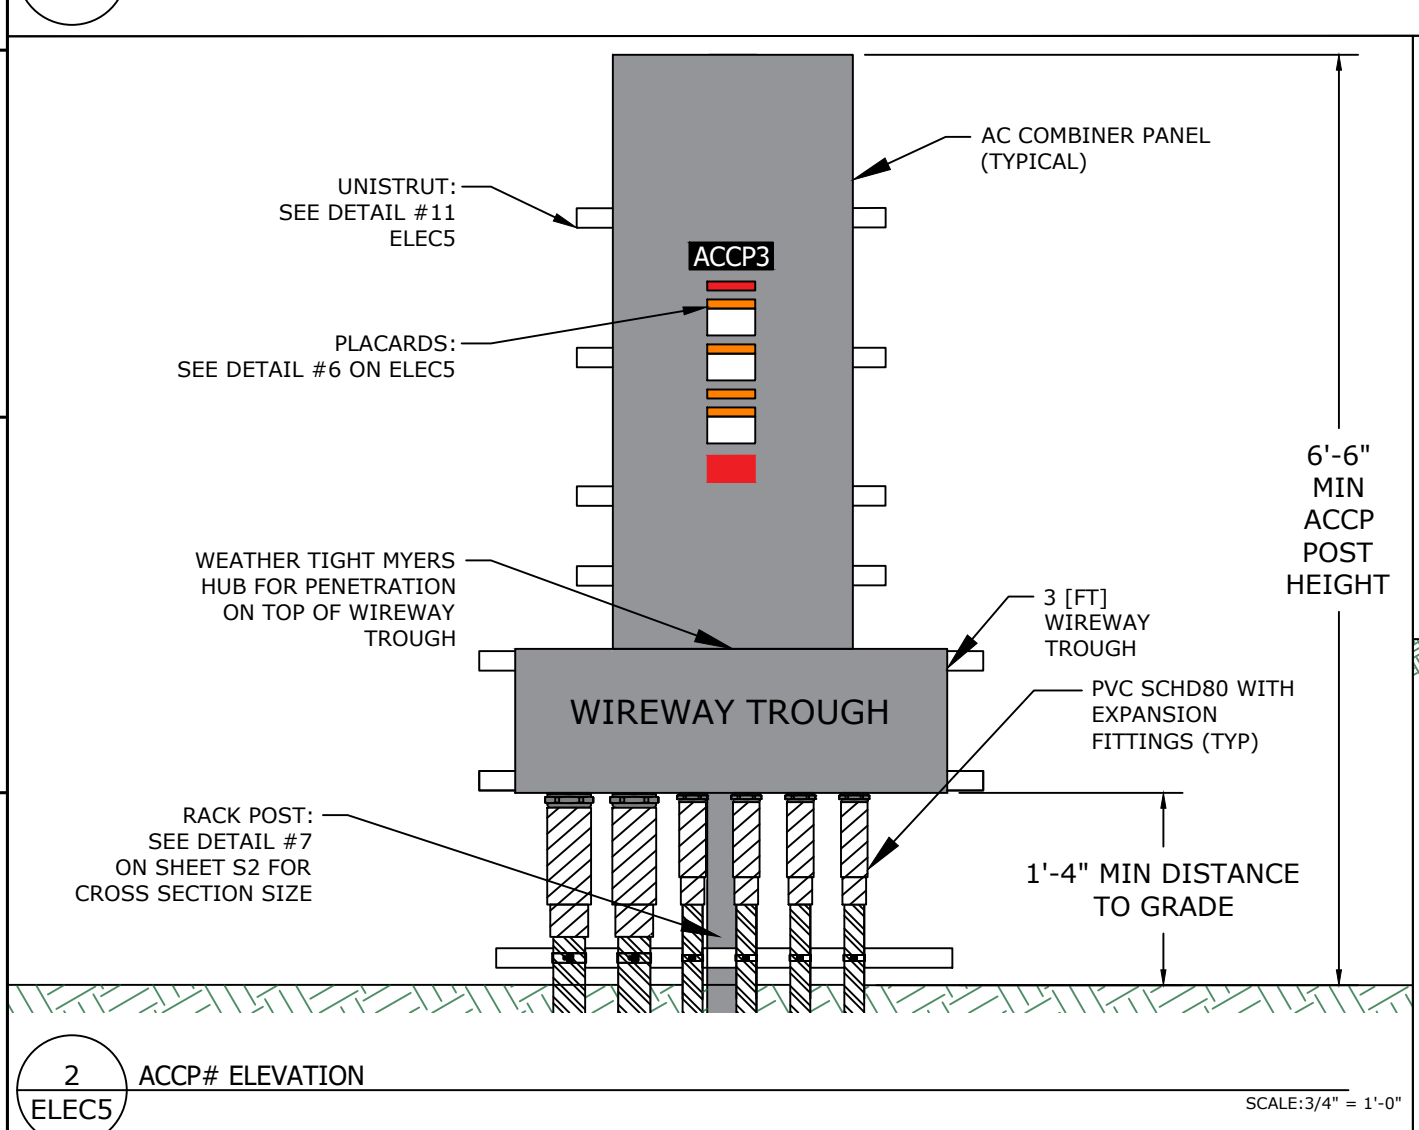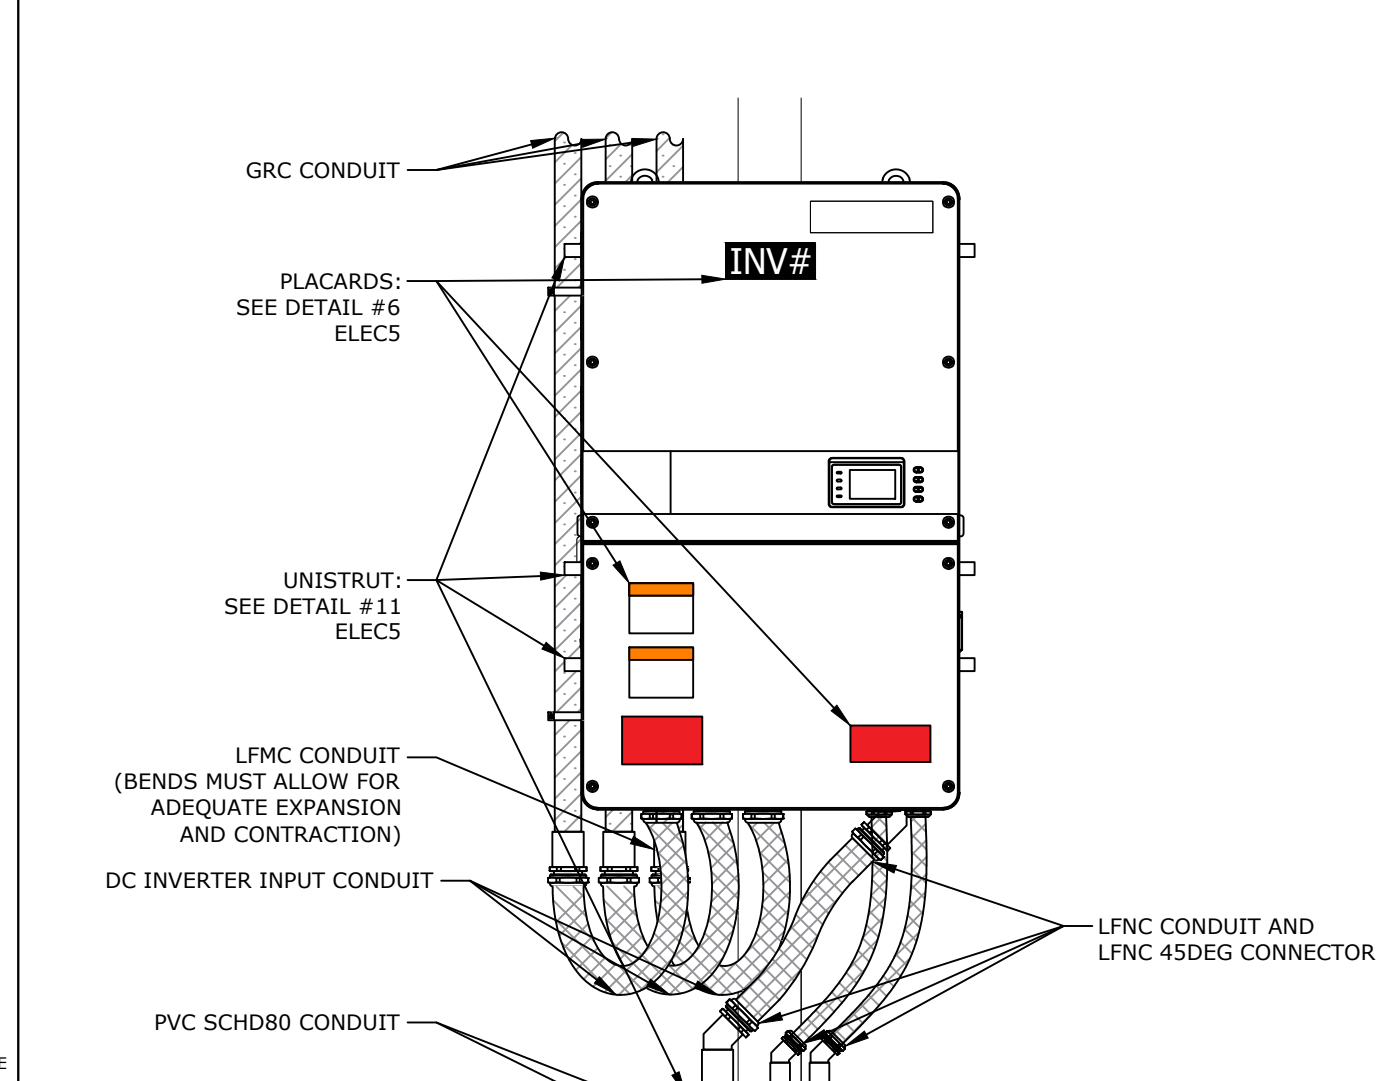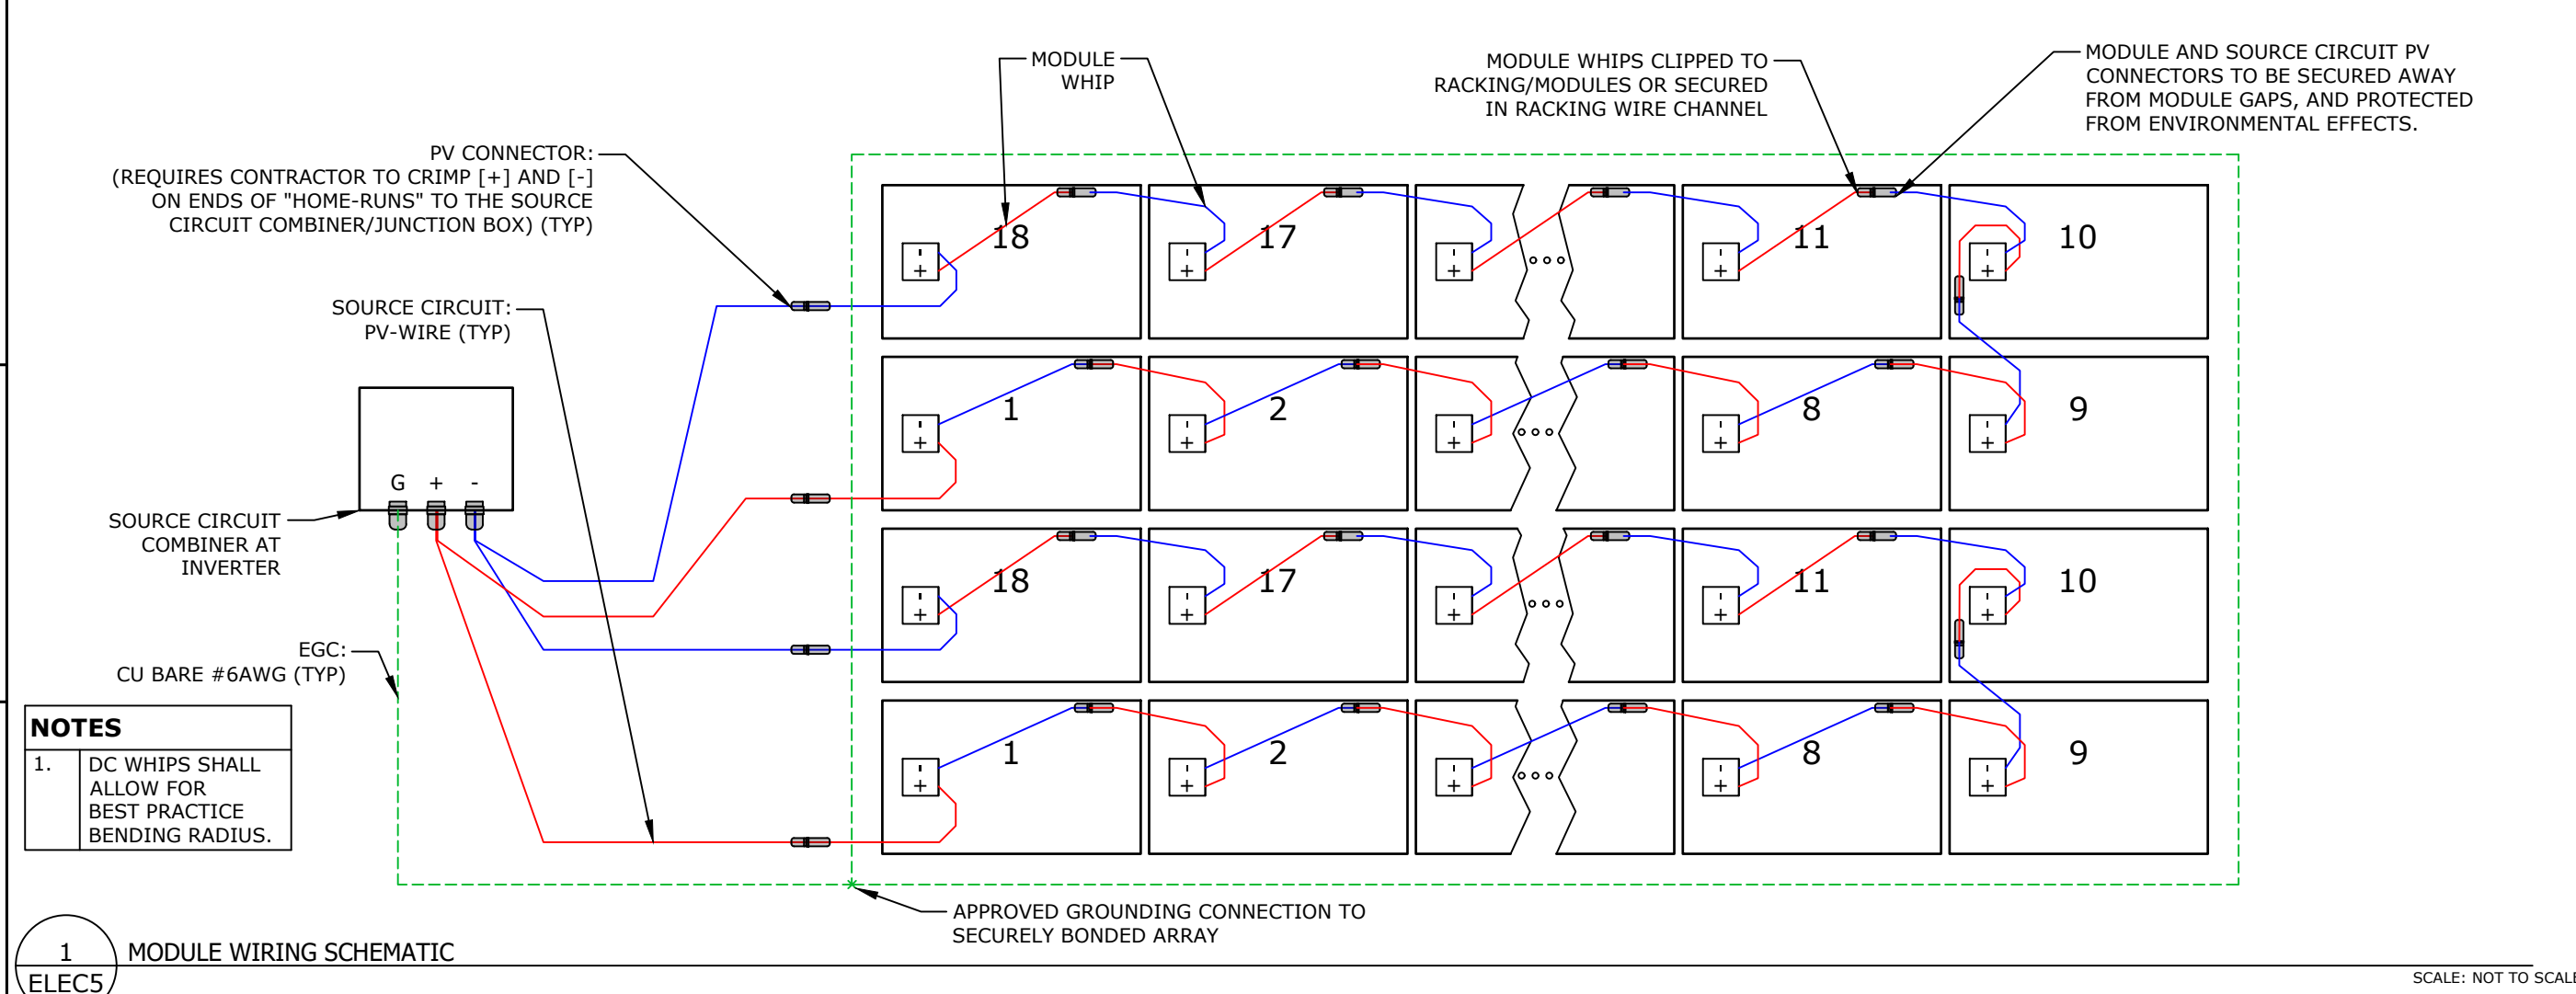

<p>CERTIFICANTS: MARC LOPATA, PE CERT # 0911109-241 DANIEL STROH, EIT CERT# 042013-130</p>	<p>MARC LOPATA, PE MAR 15 2019 NUMBER PE-2004023303</p>	<h3>OPERATING DIAGRAM</h3> <p>NOTICE OF LIMITED RESPONSIBILITY</p> <p>THE RESPONSIBILITY OF THE UNDERSIGNED ENGINEER IS LIMITED TO THE DESIGN WORK SHOWN ON PROJECT AND DOCUMENTS BEING PART OF THE CONTRACT. SIGNATURE OR INITIALS HEREON DOES NOT HAVE AUTHORITY OVER THE PROJECT AS A WHOLE. THE UNDERSIGNED DISCLAIMS ANY RESPONSIBILITY FOR WORK DONE UNDER SUBSEQUENT REVISIONS AND ANY OTHER DOCUMENTS ASSOCIATED WITH THE PROJECT WHICH DO NOT BEAR HIS/HER SEAL.</p> <p>UNIT: NOT TO SCALE SCALE: Y ARCH D (36X24) DWG. SIZE: --- SUB CLASS: ---</p>	<p>MARK UP DRAWING NO. ---</p> <p>REV. ---</p>																														
<p>REV. DATE PROJECT NO. DRAFTING NO. DR/FR/CHKD SUPY ENGR DESCRIPTION</p> <table border="1"> <tr> <td>A</td> <td>03/04/19</td> <td>1704-101</td> <td>CJB</td> <td>DIR</td> <td>DAS</td> <td>ML</td> <td>CONSTRUCTION DRAWINGS</td> </tr> <tr> <td>B</td> <td>3/15/2019</td> <td>1704-101</td> <td>CJB</td> <td>DAS</td> <td>DAS</td> <td>ML</td> <td>FENCE UPDATES</td> </tr> <tr> <td>C</td> <td>5/8/2019</td> <td>1704-101</td> <td>CJB</td> <td></td> <td></td> <td></td> <td>MONITORING UPDATES</td> </tr> <tr> <td>D</td> <td>5/21/2019</td> <td>1704-101</td> <td>CJB</td> <td></td> <td></td> <td></td> <td>SECURITY ENCLOSURE</td> </tr> </table>	A	03/04/19	1704-101	CJB	DIR	DAS	ML	CONSTRUCTION DRAWINGS	B	3/15/2019	1704-101	CJB	DAS	DAS	ML	FENCE UPDATES	C	5/8/2019	1704-101	CJB				MONITORING UPDATES	D	5/21/2019	1704-101	CJB				SECURITY ENCLOSURE	<p>SITE: AMEREN MISSOURI LAMBERT COMMUNITY SOLAR CENTER</p> <p>DRAWING NO. LC-DWG-ELEC-000005</p> <p>REVISION NO. 0</p>
A	03/04/19	1704-101	CJB	DIR	DAS	ML	CONSTRUCTION DRAWINGS																										
B	3/15/2019	1704-101	CJB	DAS	DAS	ML	FENCE UPDATES																										
C	5/8/2019	1704-101	CJB				MONITORING UPDATES																										
D	5/21/2019	1704-101	CJB				SECURITY ENCLOSURE																										

ACCP1 PANELBOARD SCHEDULE

EQUIP ID	BRKR SPCE	CKT BRKR	CKT BRKR	BRKR SPCE	EQUIP ID
600 AMP MAIN BUS					
VOLT SENSE	1	15A/3	35A/2	2	LC1
	3			4	
	5			6	
INV1	7	100A/3	100A/3	8	INV2
	9			10	
	11			12	
INV3	13	100A/3	100A/3	14	INV4
	15			16	
	17			18	
INV7	19	80A/3	80A/3	20	INV11
	21			22	
	23			24	
MAIN	A	600A MAIN LUGS			
	B				
	C				

1 ACCP1 PANELBOARD SCHEDULE

ACCP2 PANELBOARD SCHEDULE

EQUIP ID	BRKR SPCE	CKT BRKR	CKT BRKR	BRKR SPCE	EQUIP ID
600 AMP MAIN BUS					
INV5	1	80A/3	80A/3	2	INV6
	3			4	
	5			6	
INV8	7	60A/3	80A/3	8	INV9
	9			10	
	11			12	
INV10	13	80A/3	60A/3	14	INV12
	15			16	
	17			18	
INV13	19	80A/3	80A/3	20	INV14
	21			22	
	23			24	
MAIN	A	600A MAIN LUGS			
	B				
	C				

2 ACCP2 PANELBOARD SCHEDULE

ACCP3 PANELBOARD SCHEDULE



EQUIP ID	BRKR SPCE	CKT BRKR	CKT BRKR	BRKR SPCE	EQUIP ID
400 AMP MAIN BUS					
INV15	1	80A/3	100A/3	2	INV16
	3			4	
	5			6	
INV17	7	100A/3	100A/3	8	INV18
	9			10	
	11			12	
MAIN	A	400A MAIN LUGS			
	B				
	C				

3 ACCP3 PANELBOARD SCHEDULE

MDS1 SWITCHBOARD SCHEDULE



EQUIP ID	BRKR SPCE	CKT BRKR/FUSE
1600 AMP MAIN BUS		
ACCP1	1	600A/3
	2	
	3	
ACCP2	4	600A/3
	5	
	6	
ACCP3	7	400A/3
	8	
	9	
MAIN PV SYSTEM AC DISCONNECT	A	1600A/3
	B	
	C	

4 MDS1 PANELBOARD SCHEDULE

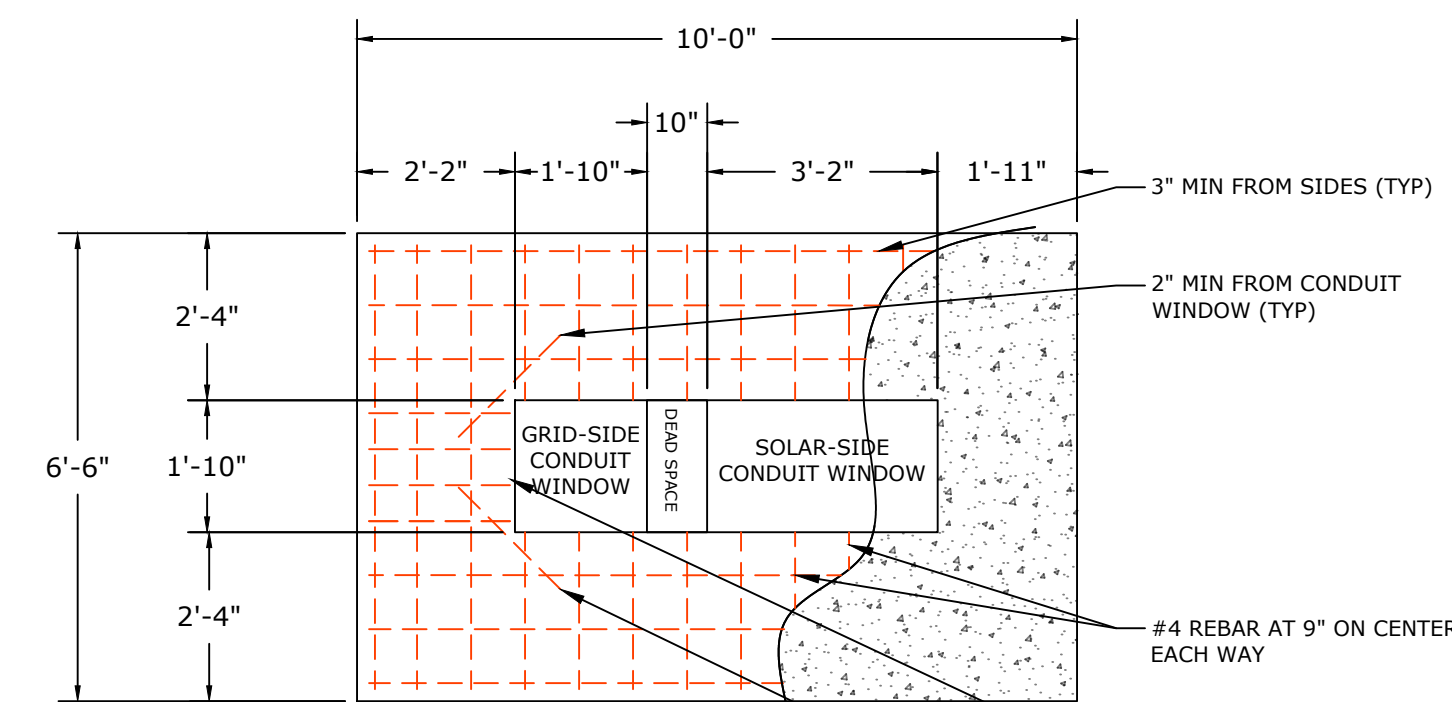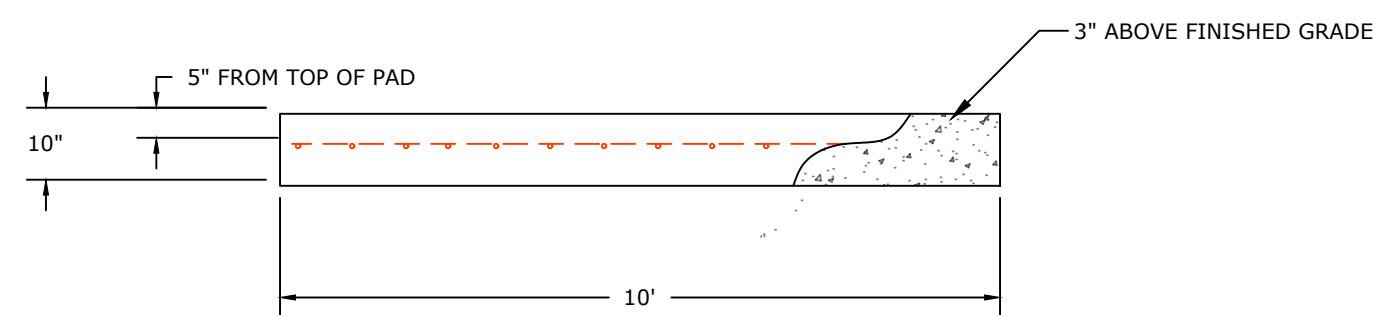

- NOTES:**
- ALL CONCRETE WORK SHALL CONFORM WITH THE REQUIREMENTS OF ACI-301 AND ACI-318.
 - EQUIPMENT PAD SHOULD BE INSTALLED AS PRACTICAL.
 - REINFORCING STEEL SHALL BE REBAR, GRADE 40 MINIMUM.
 - STEEL REBAR SHOULD BE INSTALLED TO THE INSIDE OF THE PAD HEIGHT, AND SHALL BE NO LESS THAN 4 INCHES FROM TOP OF PAD.
 - STEEL REBAR SHALL BE NO LESS THAN 3 INCHES FROM CONDUIT WINDOW. CONDUIT WINDOWS SHALL BE GROUDED WITH A NON-SWIM GROUND.
 - STEEL REBAR SHALL BE NO LESS THAN 2 INCHES FROM SIDES OF PAD.
 - STEEL REBAR SHALL BE NO LESS THAN 2 INCHES FROM SIDES OF PILE.
 - RIGHT BROW FINISH TOP OF PAD. FINISH ALL EXPOSED EDGES WITH A FINISHING TOOL. VERTICAL EDGES SHALL HAVE A 3/4 INCH CHAMFER. SLOPE EXPOSED HORIZONTAL SURFACES SUFFICIENT FOR DRAINAGE.
 - CONCRETE SHALL BE DESIGNED TO ATTAIN A STRENGTH OF 3,000 PSI AT 28 DAYS. SLURR FOR CONCRETE SHALL NOT EXCEED 3 INCHES.
 - MOIST-CURE CONCRETE AT LEAST 7 DAYS AFTER POURING. DO NOT INSTALL EQUIPMENT ON PAD UNTIL AT LEAST 14 DAYS AFTER POURING CONCRETE.
 - PAD SHALL BE PLACED ON FIRM, COMPACTED NATIVE MATERIAL WHICH HAS BEEN COMPACTED TO 90% OF MAXIMUM DENSITY. SOIL SHALL BE PLACED IN LAYERS NOT MORE THAN 12 INCHES THICK BEFORE CONSTRUCTION. AREA UNDER PAD SHALL BE SEPARATED TO THE REQUIRED GRADE, OR TO A DEPTH REQUIRED TO REACH FIRM, UNDISTURBED MATERIAL, WHICHEVER IS GREATER. MATERIAL CAN BE CONSIDERED FIRM IF IT CANNOT BE PENETRATED BY THUMB EXCEPT WITH MODERATE EFFORT.
 - CONDUITS FROM ALL COMPONENTS PANELBOARDS SHALL BE CENTERED IN THE SOLAR-SIDE CONDUIT WINDOW.
 - CONDUITS FROM TRANSFORMER SHALL BE CENTERED IN THE GRID-SIDE CONDUIT WINDOW.
 - BELLED ENDS OF CONDUIT SHOULD EXTEND APPROXIMATELY 3 INCHES ABOVE PAD SURFACE.
 - THIS SHALL BE REQUIRED ALONG THE HEIGHT OF THE DRILLED SHAFTS.

5 EQUIPMENT PAD DETAILS

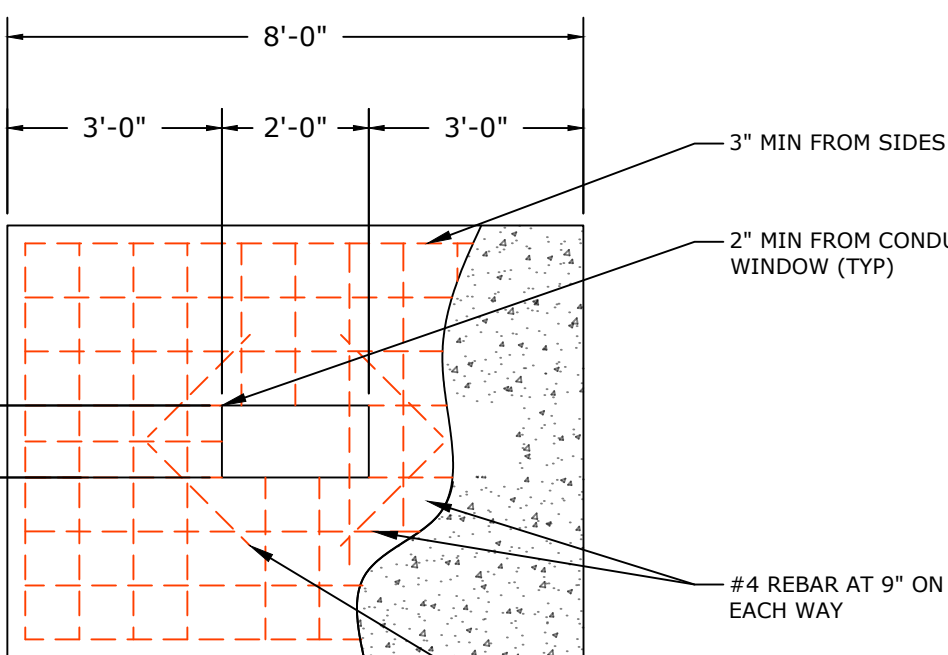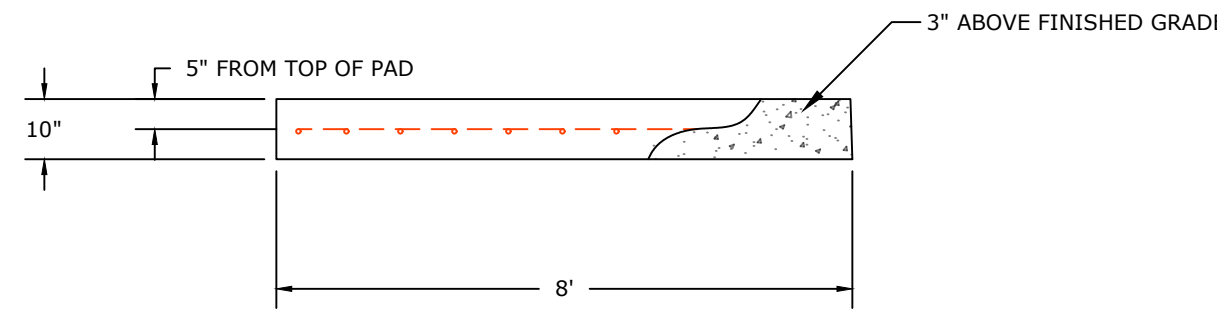

- NOTES:**
- ALL CONCRETE WORK SHALL CONFORM WITH THE REQUIREMENTS OF ACI-301 AND ACI-318.
 - EQUIPMENT PAD SHOULD BE INSTALLED AS PRACTICAL.
 - REINFORCING STEEL SHALL BE REBAR, GRADE 40 MINIMUM.
 - STEEL REBAR SHOULD BE INSTALLED TO THE INSIDE OF THE PAD HEIGHT, AND SHALL BE NO LESS THAN 4 INCHES FROM TOP OF PAD.
 - STEEL REBAR SHALL BE NO LESS THAN 3 INCHES FROM CONDUIT WINDOW. CONDUIT WINDOWS SHALL BE GROUDED WITH A NON-SWIM GROUND.
 - STEEL REBAR SHALL BE NO LESS THAN 2 INCHES FROM SIDES OF PAD.
 - STEEL REBAR SHALL BE NO LESS THAN 2 INCHES FROM SIDES OF PILE.
 - RIGHT BROW FINISH TOP OF PAD. FINISH ALL EXPOSED EDGES WITH A FINISHING TOOL. VERTICAL EDGES SHALL HAVE A 3/4 INCH CHAMFER. SLOPE EXPOSED HORIZONTAL SURFACES SUFFICIENT FOR DRAINAGE.
 - CONCRETE SHALL BE DESIGNED TO ATTAIN A STRENGTH OF 3,000 PSI AT 28 DAYS. SLURR FOR CONCRETE SHALL NOT EXCEED 3 INCHES.
 - MOIST-CURE CONCRETE AT LEAST 7 DAYS AFTER POURING. DO NOT INSTALL EQUIPMENT ON PAD UNTIL AT LEAST 14 DAYS AFTER POURING CONCRETE.
 - PAD SHALL BE PLACED ON FIRM, COMPACTED NATIVE MATERIAL WHICH HAS BEEN COMPACTED TO 90% OF MAXIMUM DENSITY. SOIL SHALL BE PLACED IN LAYERS NOT MORE THAN 12 INCHES THICK BEFORE CONSTRUCTION. AREA UNDER PAD SHALL BE SEPARATED TO THE REQUIRED GRADE, OR TO A DEPTH REQUIRED TO REACH FIRM, UNDISTURBED MATERIAL, WHICHEVER IS GREATER. MATERIAL CAN BE CONSIDERED FIRM IF IT CANNOT BE PENETRATED BY THUMB EXCEPT WITH MODERATE EFFORT.
 - BELLED ENDS OF CONDUIT SHOULD EXTEND APPROXIMATELY 3 INCHES ABOVE PAD SURFACE. THIS SHALL BE REQUIRED ALONG THE HEIGHT OF THE DRILLED SHAFTS.

6 SECURITY ENCLOSURE PAD DETAILS

OPERATING DIAGRAM

NOTICE OF LIMITED RESPONSIBILITY
 THE RESPONSIBILITY OF THE UNDERSIGNED ENGINEER IS LIMITED TO THE DESIGN WORK SHOWN ON PROJECT AND DOCUMENTS BEARING HIS OR HER SEAL, SIGNATURE OR INITIALS. HE/SHE DOES NOT HAVE AUTHORITY OVER THE PROJECT AS A WHOLE. THE UNDERSIGNED DISCLAIMS ANY RESPONSIBILITY FOR WORK DONE UNDER SUBSEQUENT REVISIONS AND ANY OTHER DOCUMENTS ASSOCIATED WITH THE PROJECT WHICH DO NOT BEAR HIS/HER SEAL, SIGNATURE OR INITIALS.

SCALE	NOT TO SCALE
UNIT NO.	---
DWG. SIZE	Y ARCH D (36X24)
SUB CLASS	---


PANELBOARD SCHEDULE
 SITE: AMEREN MISSOURI LAMBERT COMMUNITY SOLAR CENTER
 DRAWING NO. LC-DWG-ELEC-000006




CERTIFICANTS:
 MARC LOPATA, PE
 CERT # 091110-241
 DANIEL STROH, EIT
 CERT # 042013-130

CERTIFICANTS:
 MARC LOPATA, PE
 CERT # PVSI-120917-006937


DRAWING RECORD

REV.	DATE	PROJECT NO.	DRAFTING	CHKD	SUPV	ENGR	DESCRIPTION
A	03/04/19	1704-101	CJB	DIR	DAS	ML	CONSTRUCTION DRAWINGS
B	3/15/2019	1704-101	CJB	DAS	DAS	ML	FENCE UPDATES
C	5/8/2019	1704-101	CJB				MONITORING UPDATES
D	5/21/2019	1704-101	CJB				SECURITY ENCLOSURE

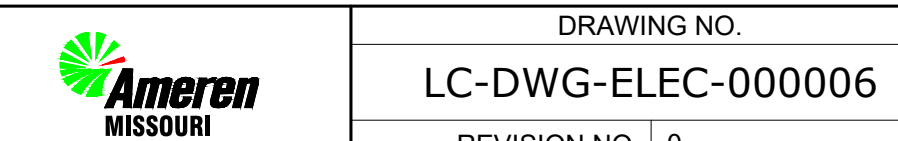


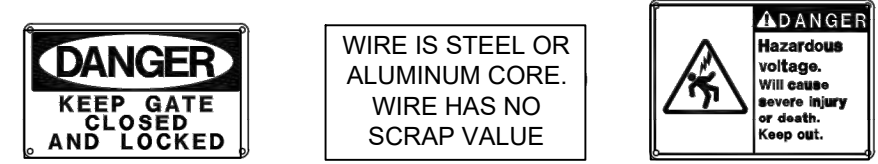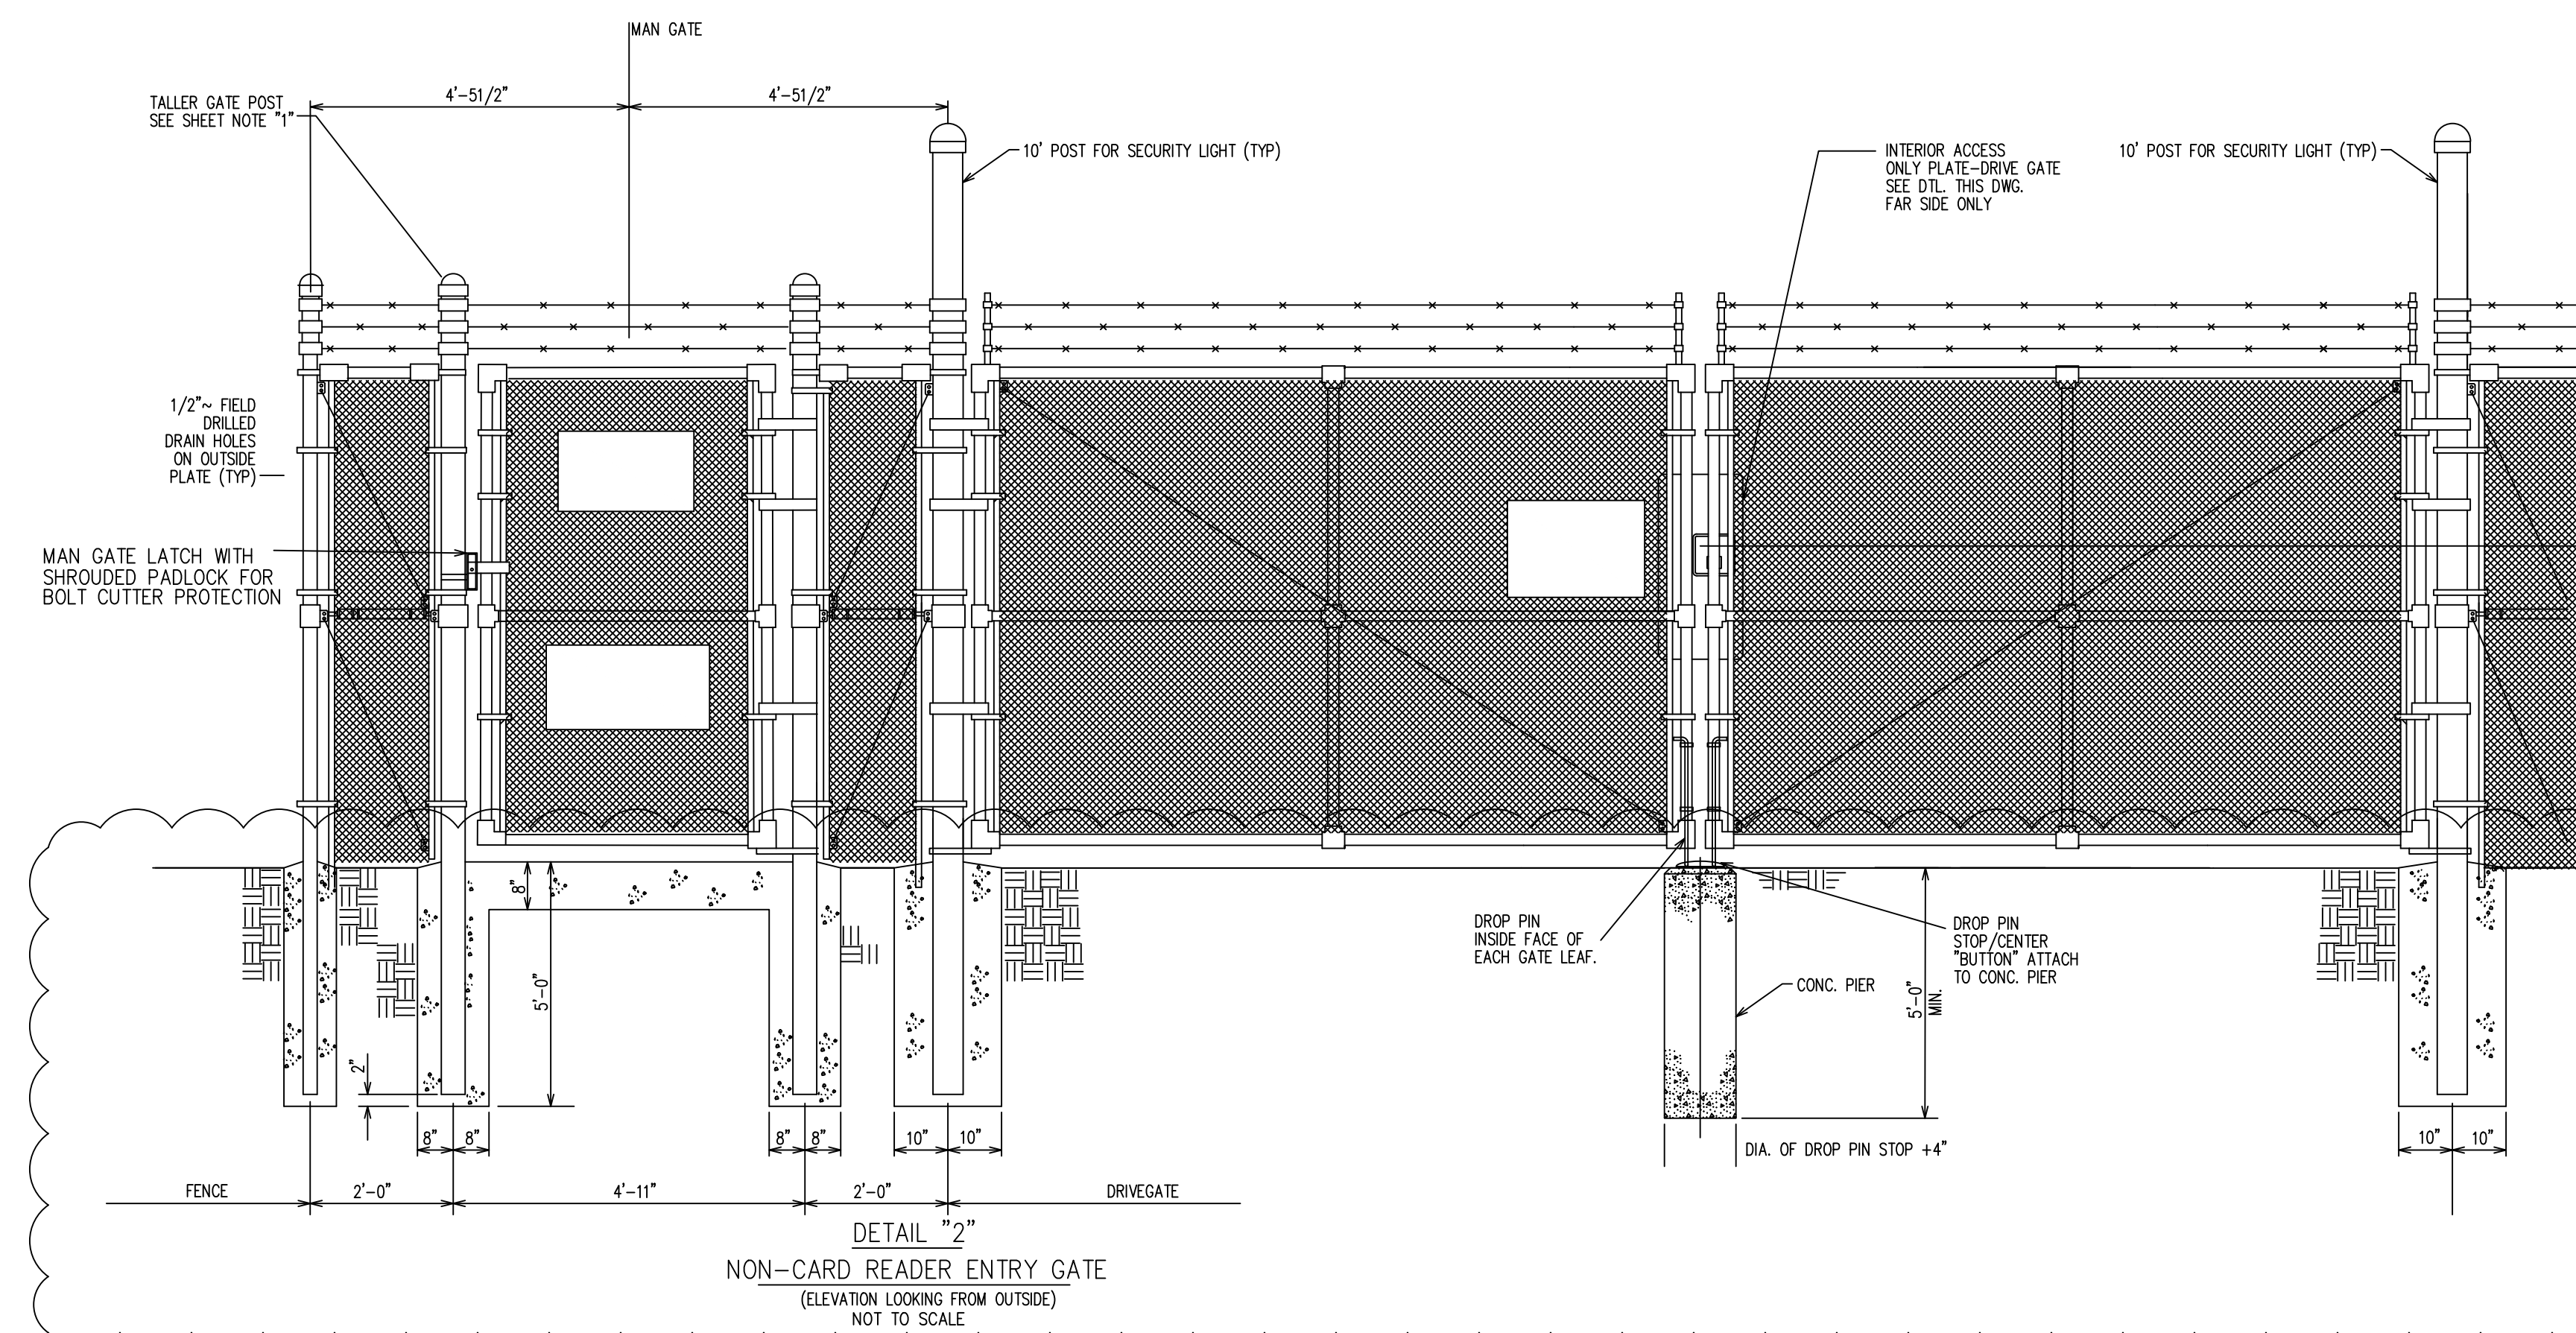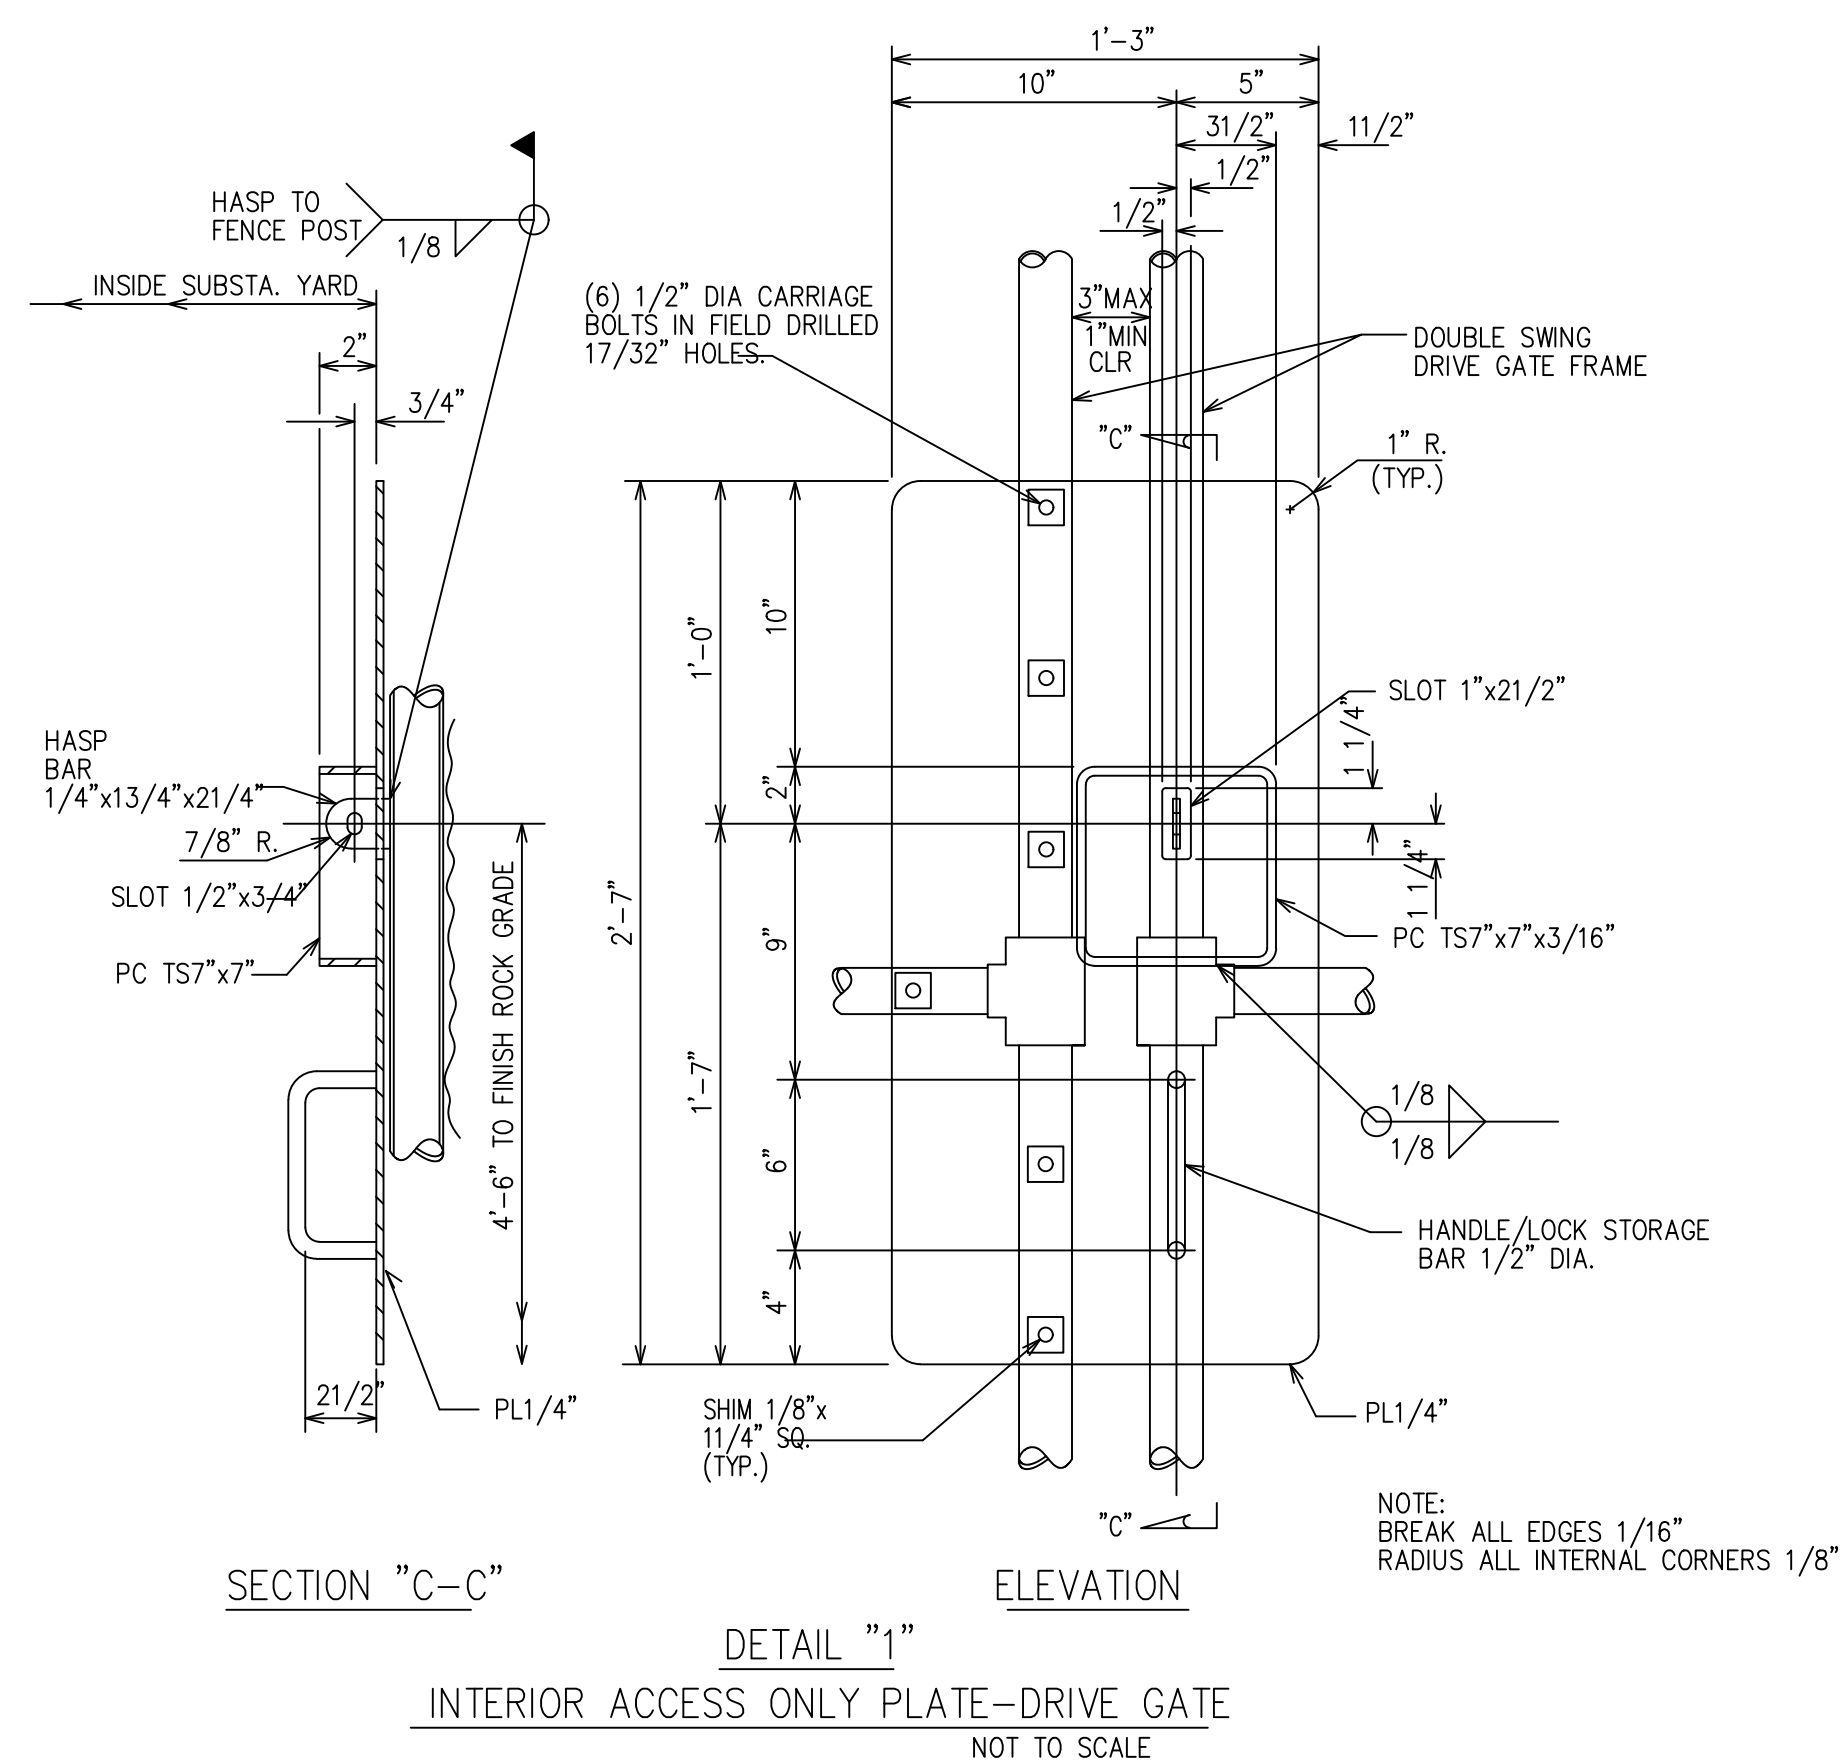



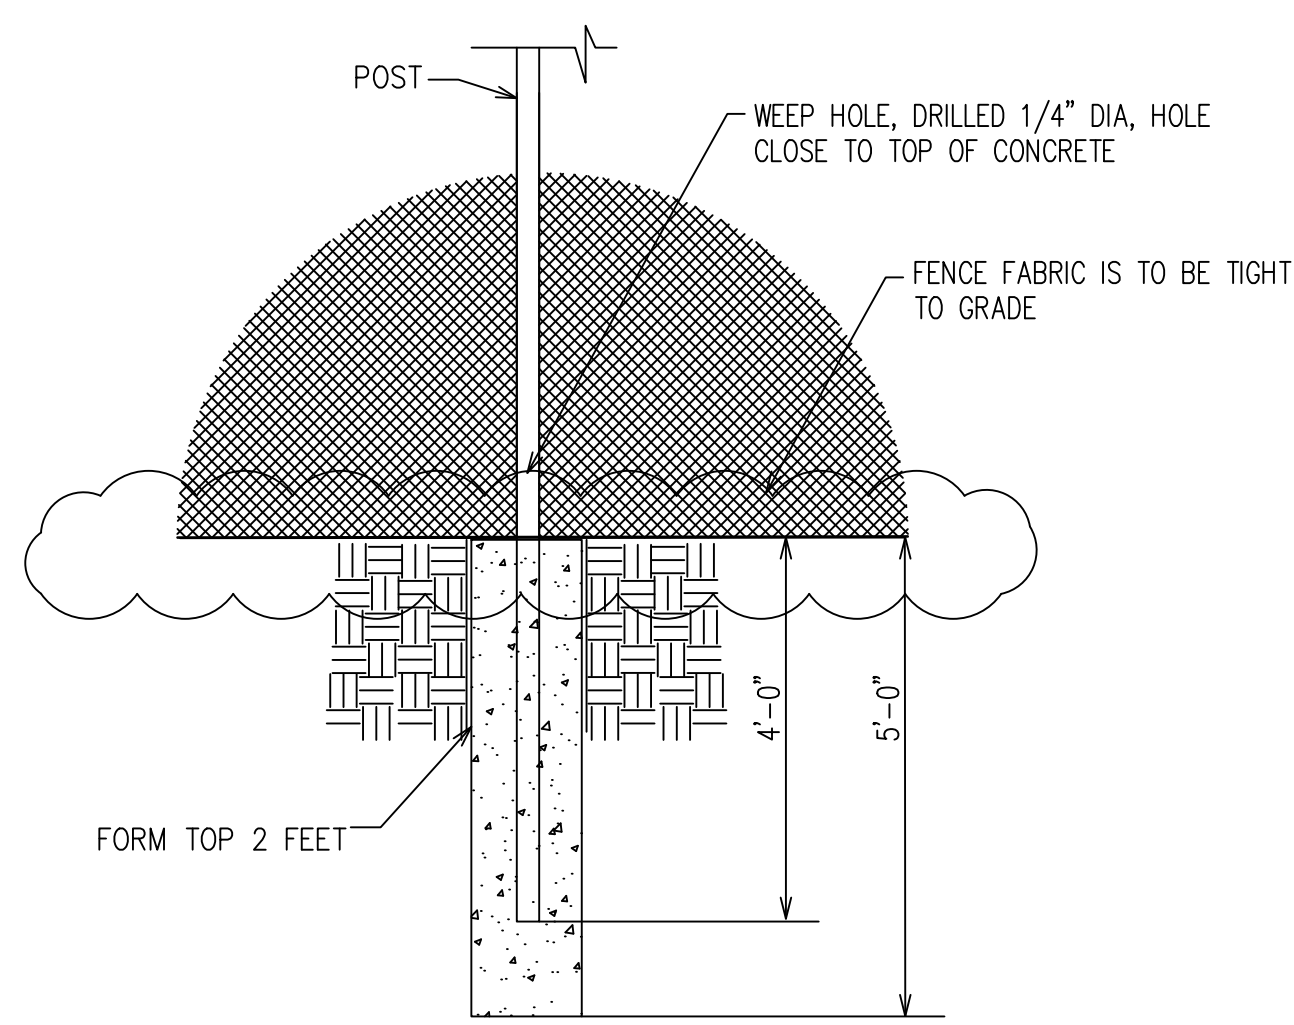


TYPICAL FOUNDATION DETAIL

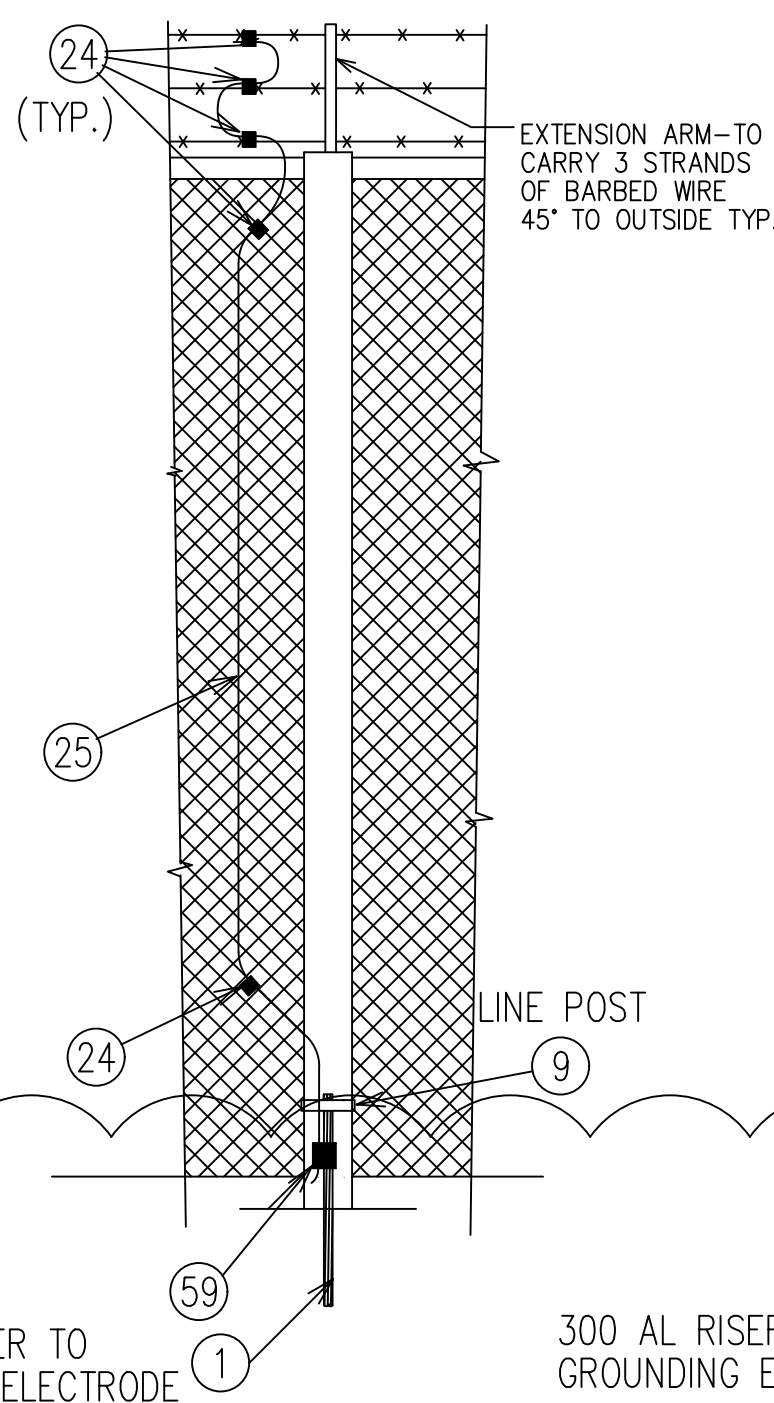

DETAIL "4"
FENCE POST GROUNDING

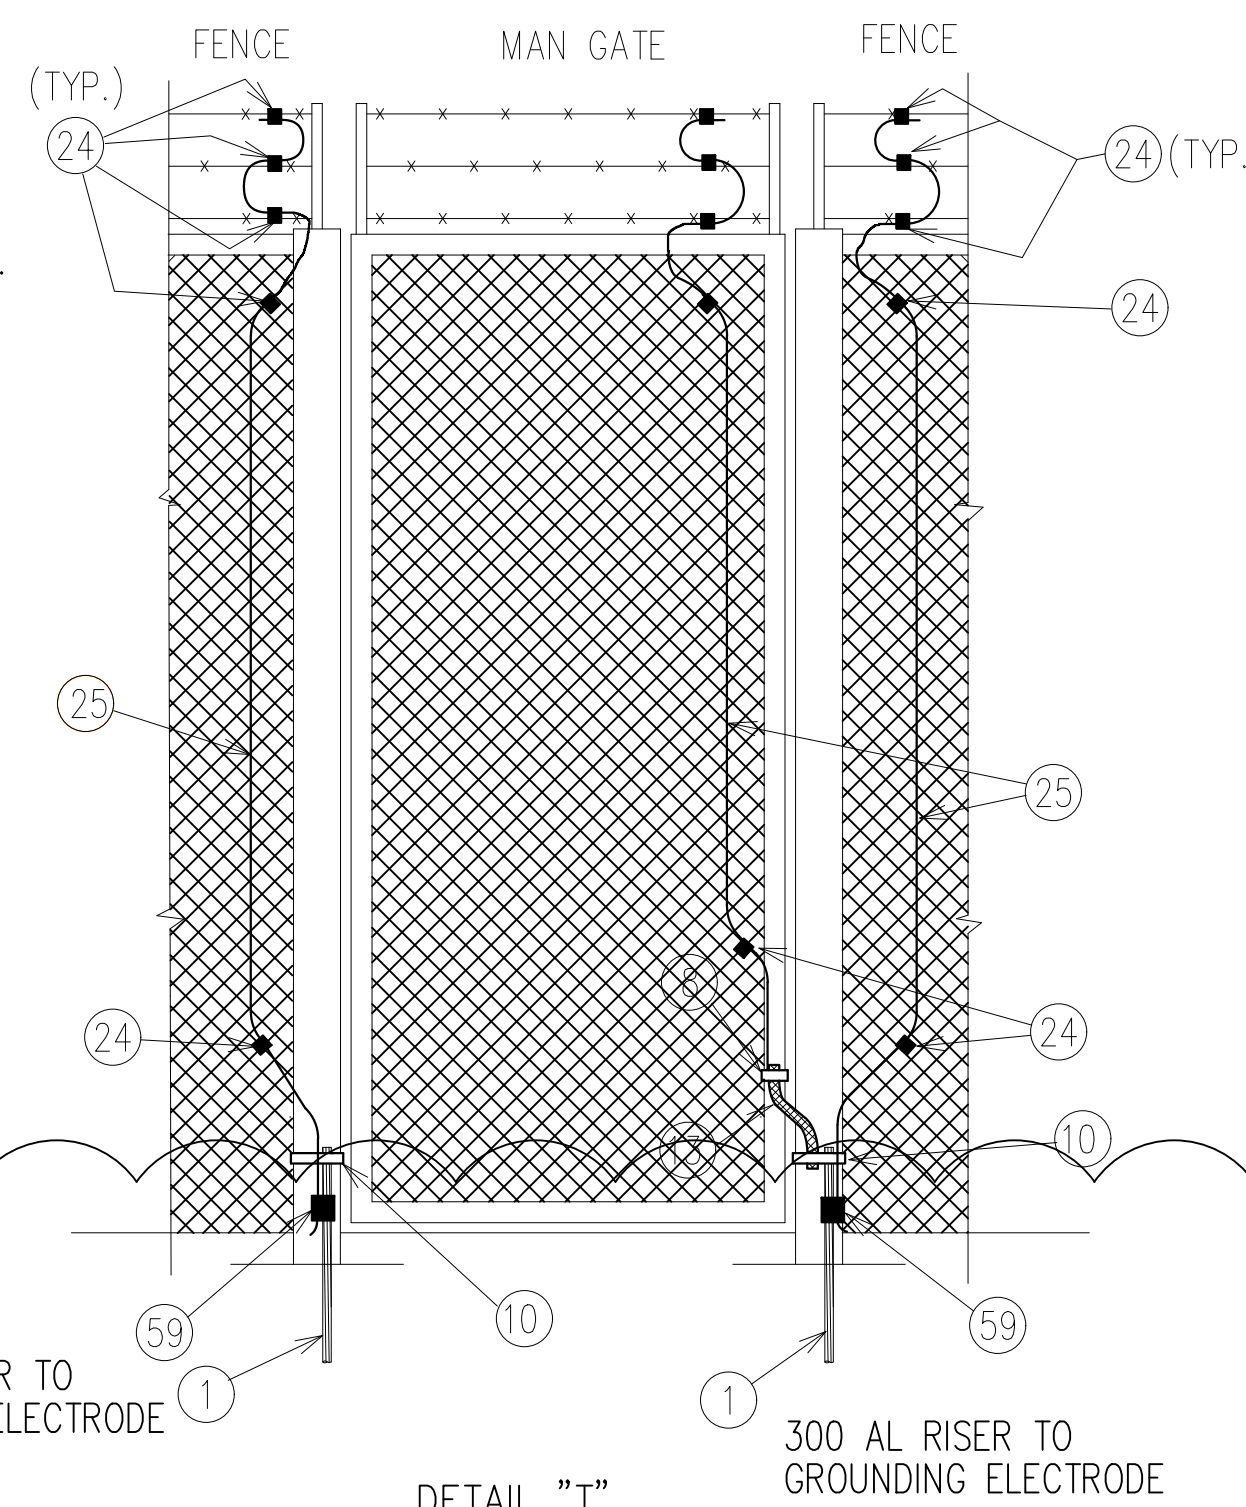

DETAIL "T"
MAN GATE GROUNDING

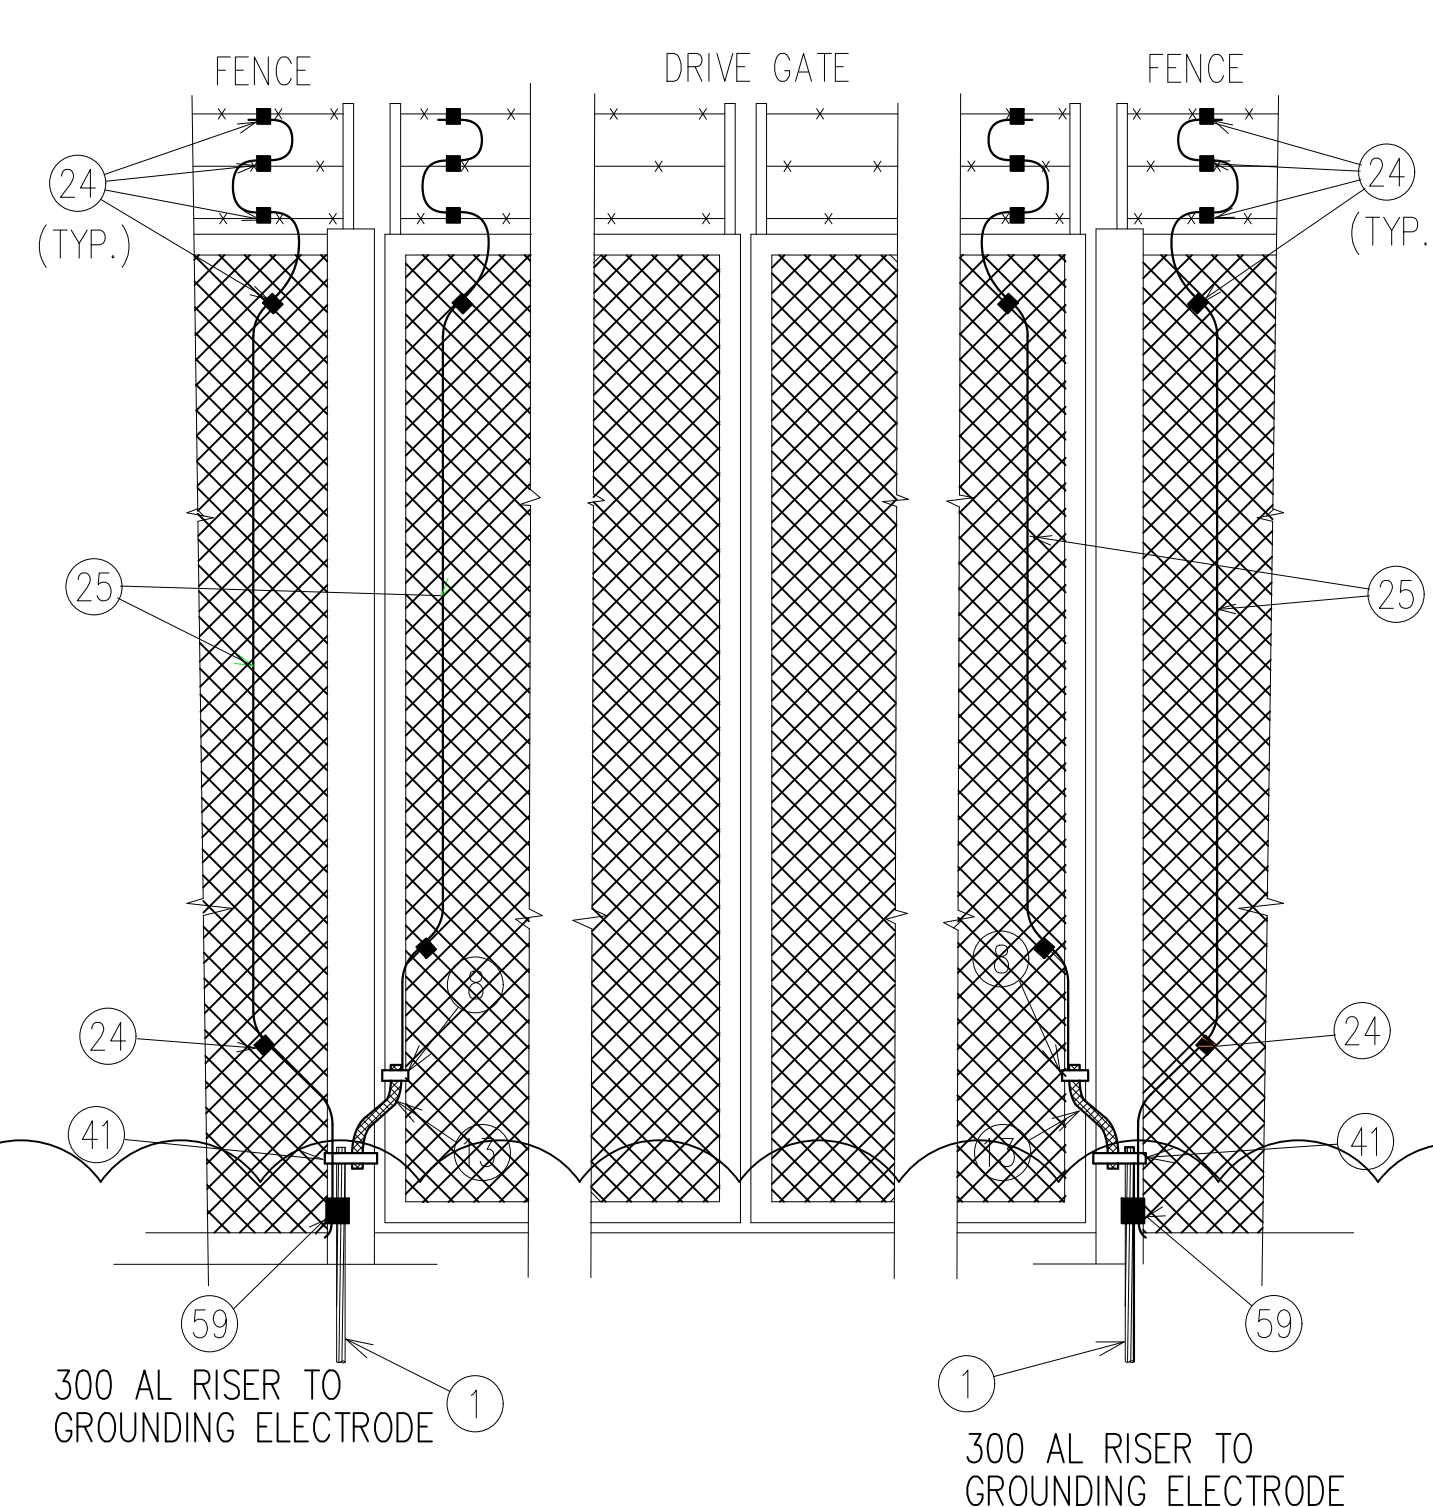

DETAIL "U"
DRIVE GATE GROUNDING

- ### SHEET NOTES
1. FENCE GROUNDING SHALL BE COMPLETED WITHIN 50' OF THE POINT WHERE THE MEDIUM VOLTAGE CONDUCTORS OR DUCT BANKS CROSS UNDER THE PERIMETER FENCE, AND SHALL BE BONDED TO 5/8" X 8' GROUNDING ELECTRODE DRIVEN WITHIN SIX(6) FEET OF FENCE LINE. ADDITIONAL FENCE GROUNDING IS NOT REQUIRED.
 2. BONDING OF THE GATES TO THE FENCE POST SHALL BE COMPLETED IN ACCORDANCE WITH THE FENCE DETAILS DRAWING.
 3. WHERE CONCRETE FOUNDATIONS ARE REQUIRED, THEY SHALL BE IN ACCORDANCE WITH THE "TYPICAL FOUNDATION DETAIL" IN THE FENCE DETAILS DRAWING.
 4. THE SECURITY FENCE SHALL BE INSTALLED AT LEAST 9' OUTSIDE THE RACKING FOOTPRINT.
 5. ONE INCH MESH FENCING SHALL BE PROVIDED. FENCING SHALL BE SEVEN (7) FEET TALL WITH CONCRETE FOOTING AT GATES, FENCE CORNERS, LIGHT POSTS, AND AS REQUIRED ON SLOPED TERRAIN TO ENSURE SECURE AND STABLE INSTALLATION. ALL FENCING SHALL BE GALVANIZED MATERIAL.
 6. (4) SECURITY LIGHT POSTS SHALL HAVE 10" REVEAL HEIGHTS FOR MOUNTING SECURITY LIGHTS. SEE SITE PLAN FOR LOCATIONS.
 7. ELECTRICAL SUB-CONTRACTOR RESPONSIBLE FOR CONDUIT AND CABLE/ DATA PULLS TO ELECTRONIC GATES AND UTILITY POLES FROM "EQUIPMENT HUB", AS REQUIRED BY AMEREN MISSOURI.

ITEM NO.	DESCRIPTION
1	300 AL WIRE, BARE, 19 STRAND, SOFT DRAWN (1000')
8	11/4" BRAID TO 2" O.D. PIPE, GROUND CLAMP
9	U-BOLT GROUND CLAMP, 300 TO 2" NOM. PIPE (23/8" O.D.)
10	U-BOLT GROUND CLAMP, 300 TO 31/2" NOM. PIPE (4" O.D.)
13	BRAID, COPPER, FLEXIBLE, TINNED, 1/4"x 11/4", 200A
24	WIRE CONNECTOR, 3/0 TO FENCE MESH, 2 BOLT
25	3/0 AL WIRE, BARE, 7 STRAND, SOFT DRAWN
41	U-BOLT GROUND CLAMP, 300 TO 6" NOM. PIPE (65/8" O.D.)
59	PARALLEL GROOVE CLAMP, #4-300 MAIN, #4-4/0 TAP

CERTIFICATES:
MARC LOPATA, PE
 CERT # 091119-243
 DANIEL STROH, EIT
 CERT # 042013-130

CERTIFICATES:
MARC LOPATA, PE
 CERT # PWSI-120917-006937

PROFESSIONAL ENGINEER
 NUMBER 0000000000
 MAR 15 2019
 PWSI-120917-006937

OPERATING DIAGRAM

NOTICE OF LIMITED RESPONSIBILITY

THE RESPONSIBILITY OF THE UNDERSIGNED ENGINEER IS LIMITED TO THE DESIGN WORK SHOWN ON PROJECT AND DOCUMENTS BEARING HIS OR HER SEAL, SIGNATURE OR INITIALS. HE OR SHE DOES NOT HAVE AUTHORITY OVER THE PROJECT AS A WHOLE. THE UNDERSIGNED DISCLAIMS ANY RESPONSIBILITY FOR WORK DONE UNDER SUBSEQUENT REVISIONS AND ANY OTHER DOCUMENTS ASSOCIATED WITH THE PROJECT WHICH DO NOT BEAR HIS/HER SEAL OR SIGNATURE OR INITIALS.

UNIT NO. ---
 DWG. SIZE Y ARCH D (36X24)
 SUB CLASS ---

REV.	DATE	PROJECT NO.	DRAFTING	CHKD	SUPV	ENGR	DESCRIPTION
A	03/04/19	1704-101	CJB	DIR	DAS	ML	CONSTRUCTION DRAWINGS
B	3/15/2019	1704-101	CJB	DAS	DAS	ML	FENCE UPDATES
C	5/8/2019	1704-101	CJB				MONITORING UPDATES
D	5/21/2019	1704-101	CJB				SECURITY ENCLOSURE

FENCE DETAILS

SCALE NOT TO SCALE

SITE: AMEREN MISSOURI LAMBERT COMMUNITY SOLAR CENTER

DRAWING NO. LC-DWG-PROP-000004

REVISION NO. 0

Ameren MISSOURI

GCL-M6/72H

GCL-Saturn Series Monocrystalline Module 365-400W

Electrical Specification (STC*)

Table with 11 columns: Parameter, Unit, and values for various power and current specifications at STC.

Electrical Specification (NOCT*)

Table with 11 columns: Parameter, Unit, and values for various power and current specifications at NOCT.

Mechanical Data

Table with 2 columns: Parameter and Value, detailing physical characteristics like solar cell type, dimensions, and weight.


Temperature Ratings

Table with 2 columns: Parameter and Value, showing operating and storage temperature ranges.


Packaging Configuration

Table with 2 columns: Parameter and Value, indicating the number of modules per box and per container.


Module Dimension

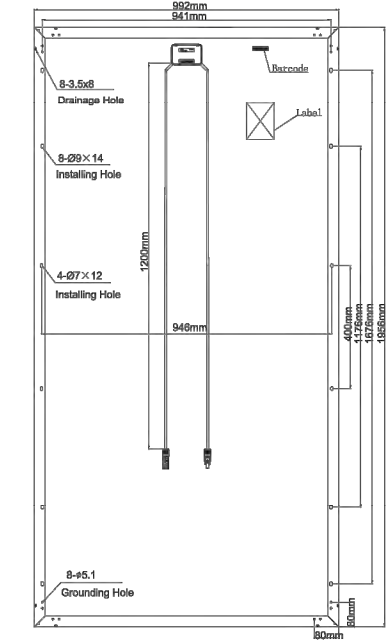

U-I Curve at Different Temperature (ISOH)

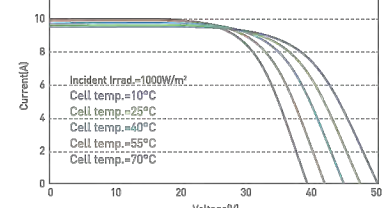

U-I/P-U Curve at Different Irradiation (ISOH)

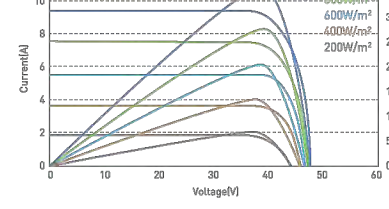

GCL logo and contact information for GCL Solar, including website and email.

PVI 50TL & PVI 60TL

Specifications

Large table detailing specifications for PVI 50TL and PVI 60TL inverters, including DC input, AC output, efficiency, and safety features.

Notes regarding compatibility with module-level power electronics (MLPE) and safety requirements.

SOLECTRIA SOLAR

SOLECTRIA SOLAR contact information and YASKAWA logo.

Table comparing specifications for PVI 14TL, PVI 20TL, PVI 23TL, PVI 28TL, and PVI 36TL inverters.

YASKAWA SOLECTRIA SOLAR contact information and website details.

SOLAR FLEXRACK A Division of Northern States Metals

ATTACHMENT B FLEXRACK SERIES G3L | Specifications





Table detailing specifications for FlexRack Series G3L, including materials, hardware, racking structure, foundations, design, orientation, tilt angle, racking slope tolerance, wind speed, snow load, module accommodation, module mounting type, foundation accommodation, warranty, design life, certifications and testing, UL certification, wind tunnel testing, structural connection testing, code compliance, finite element modeling, services, geotechnical engineering, structural/civil engineering, installation, and training.

A MODULE DATA SHEET

B INVERTER DATA SHEET

C INVERTER DATA SHEET

D RACKING DATA SHEET

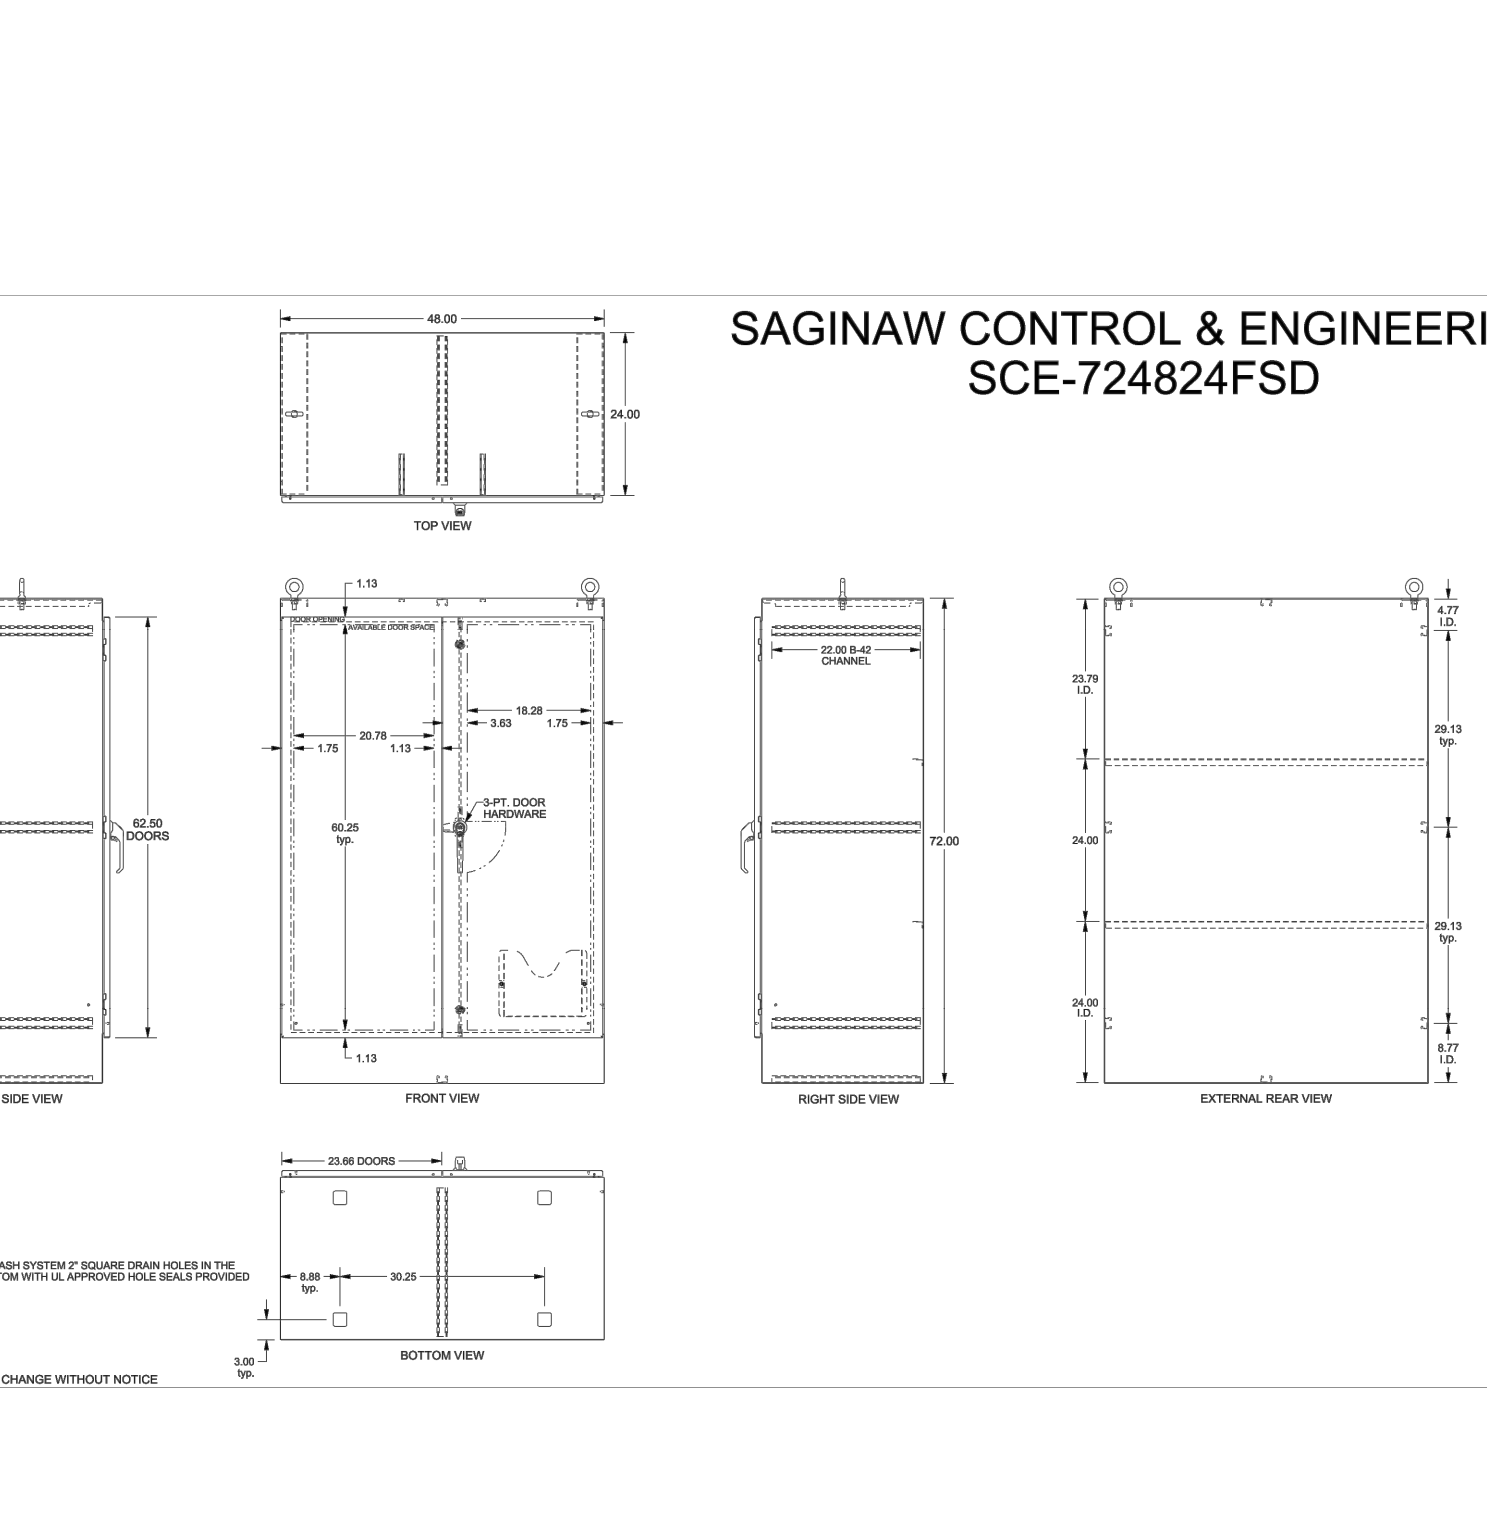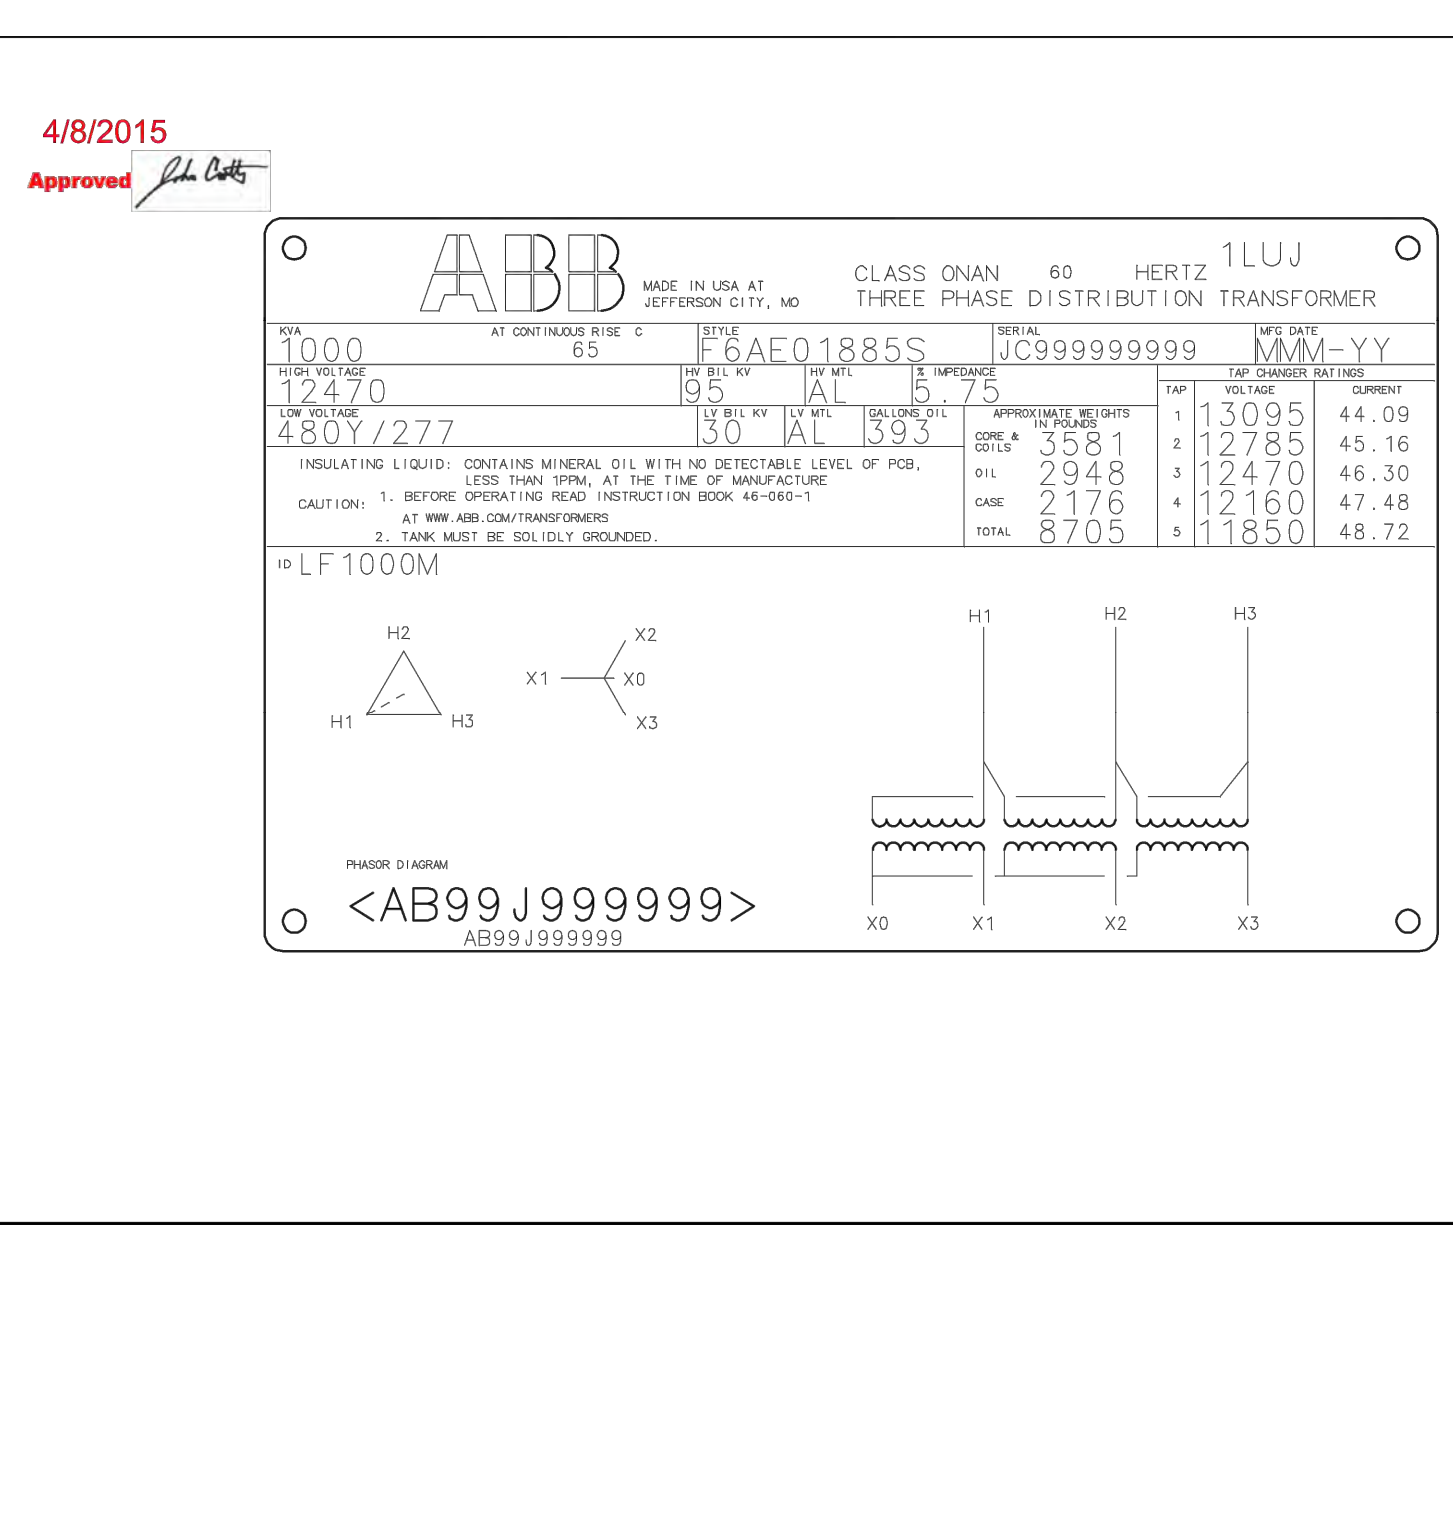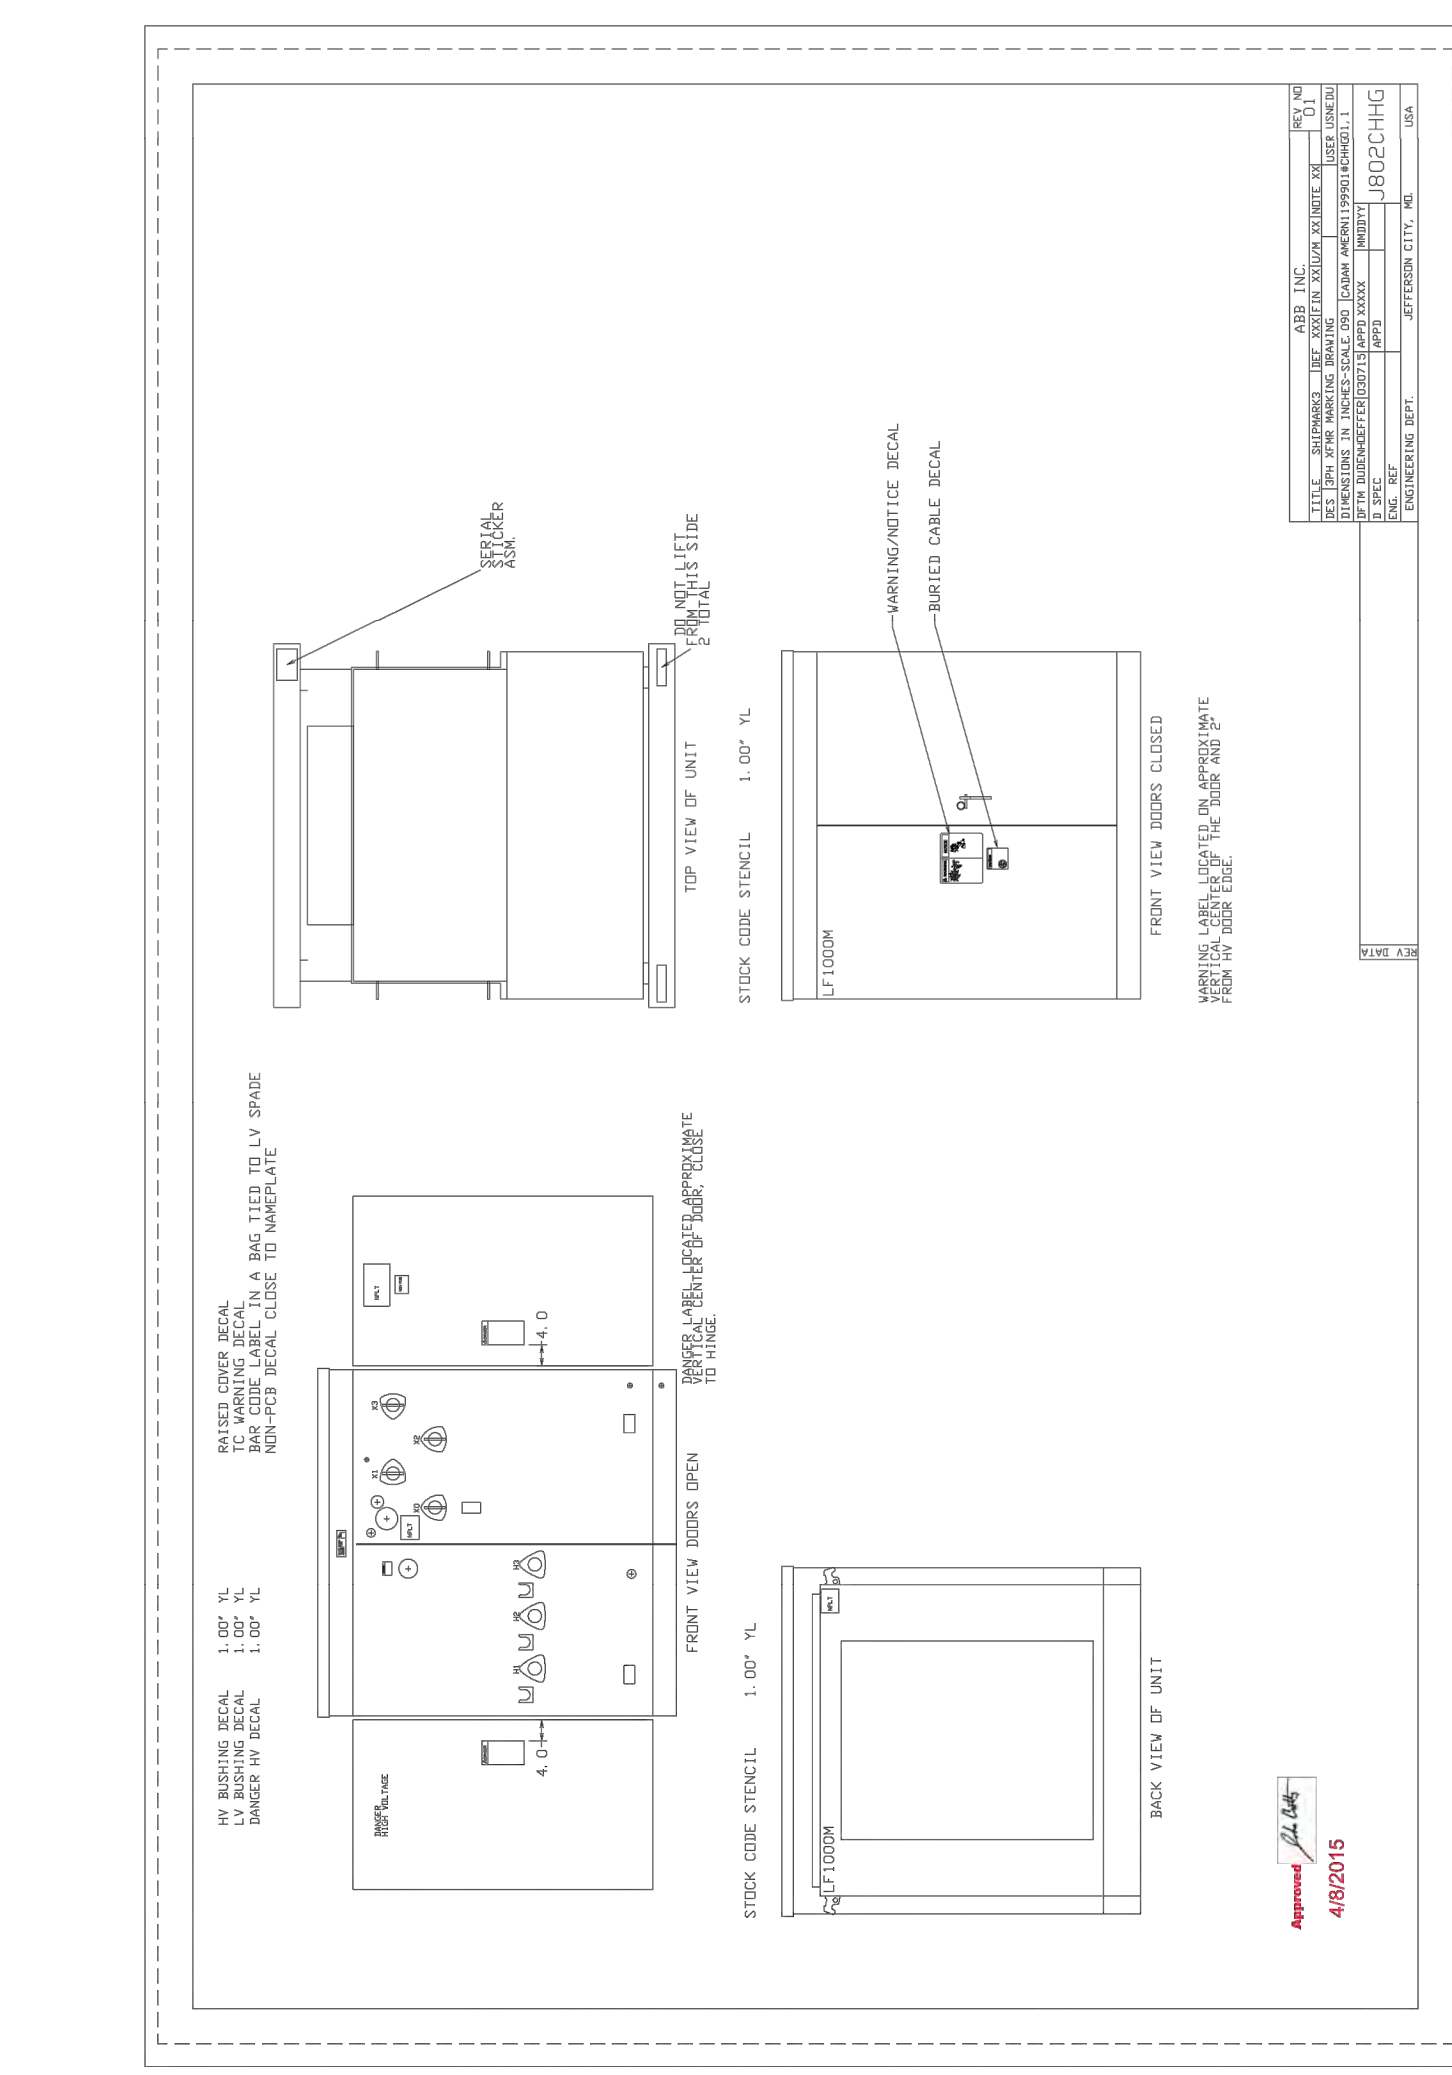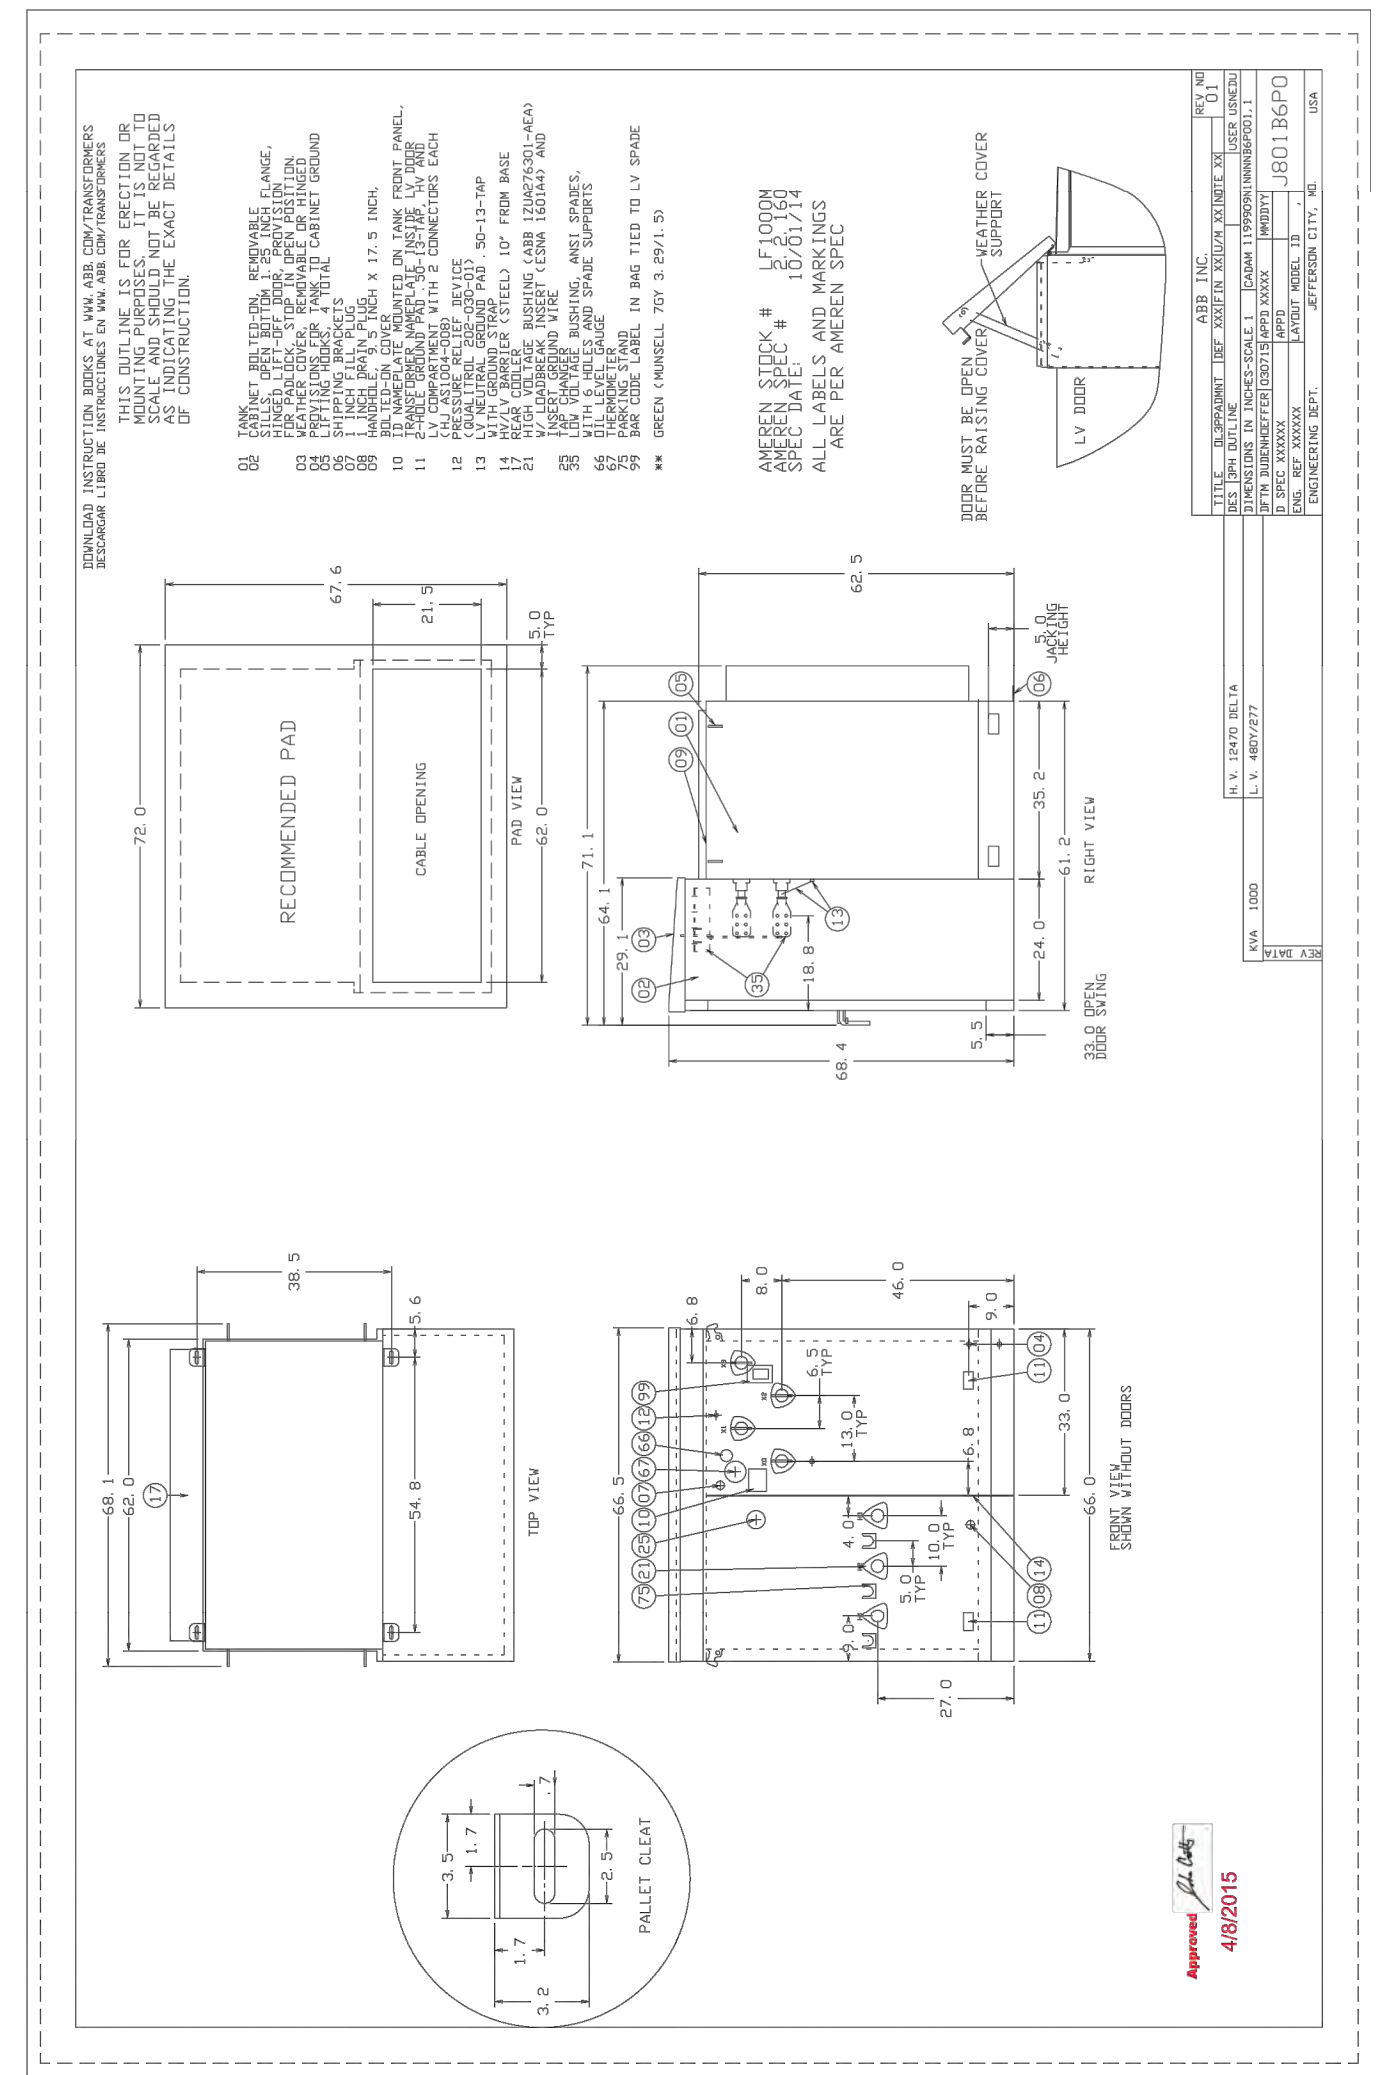

E TRANSFORMER DATA SHEET 1

F TRANSFORMER DATA SHEET 2

G TRANSFORMER DATA SHEET 3

H AMEREN SECURITY ENCLOSURE


AMEREN COMMUNITY SOLAR (MISSOURI BOTTOMS) AZIMUTH ENERGY EST118387

SHEET INDEX

NO.	DATE	DESCRIPTION
1	2/15/2019	COVER SHEET
2	2/15/2019	CONSTRUCTION DRAWINGS
3	2/15/2019	ENCLOSURE
4	2/15/2019	FIELD LAYOUT
5	2/15/2019	MONITORING DETAILS
6	2/15/2019	COMMUNICATIONS SCHEDULES
7	2/15/2019	WARRANTY

PROJECT DESCRIPTION

SITE NAME: AMEREN COMMUNITY SOLAR (MISSOURI BOTTOMS)
 SITE ADDRESS: 11519 MISSOURI BOTTOM ROAD, ST. LOUIS, MO 63145, UNITED STATES
 SITE OWNER: AZIMUTH ENERGY
 EPC NAME: -
 SYSTEM SIZE: 1050 KW DC
 SYSTEM TYPE: MONITORING/STANDARD
 TECH CONTACT NAME: AZIMUTH ENERGY : CORY BRENNAN
 TECH CONTACT EMAIL: CORY@AZIMUTH.ENERGY
 TECH CONTACT PHONE: 618.691.9123
 ALSOENERGY SALES REP: ELI TIFFAULT
 ALSOENERGY ACCT. MGR: SARAH MARGOLIN-ROSS

TECHNICAL SUPPORT

SUPPORT CONTACTS: 866-303-5668 SUPPORT@ALSOENERGY.COM
 WEEKDAY(9-5) 8AM-5PM US-ET, WEEKENDS: 11AM-7PM US-ET
 CONTACT YOUR ACCOUNT REPRESENTATIVE TO PURCHASE ON-SITE COMMISSIONING OR ONSITESERVICE@ALSOENERGY.COM TO SCHEDULE PREVIOUSLY PURCHASED SERVICES.

ABBREVIATIONS

A	AMPS	MCE	MAIN COMMUNICATION ENCLOSURE
AC	ALTERNATING CURRENT	MIN	MINIMUM
ACD	AC DISCONNECT	MV	MEDIUM VOLTAGE
AWG	AMERICAN WIRE GAUGE	NEC	NATIONAL ELECTRIC CODE
C	CELSIUS	NEG	NEGATIVE
CB	CIRCUIT BREAKER	OCP	OVERCURRENT PROTECTION
CT	CURRENT TRANSFORMER	OD	OUTSIDE DIAMETER
CJ	COPPER	PDA	PLANE OF ARRAY
DAS	DATA ACQUISITION SYSTEM	PB	PANELBOARD
DC	DIRECT CURRENT	PCOC	POINT OF COMMON COUPLING
DCD	DC DISCONNECT	POS	POSITIVE
DISC	DISCONNECT	PV	PHOTOVOLTAIC
EGC	EQUIPMENT GROUNDING CONDUCTOR	SCADA	SUPERVISORY CONTROL AND DATA ACQUISITION
F	FAHRENHEIT	SCH	SCHEDULE
FO	FIBER OPTIC	TYP	TYPICAL
GH	GLOBAL HORIZONTAL IRRADIANCE	UL	UNDERWRITERS LABORATORIES
GND	GROUND	V	VOLTS
HV	HIGH VOLTAGE	VAC	VOLTS AC
ID	INSIDE DIAMETER	VAR	VOLT-AMPERE REACTIVE
INV	INVERTER	VDC	VOLTS DC
JB	JUNCTION BOX	W	WATTS
KV	KILOVOLT	WS	WEATHER STATION
KWH	KILOWATT-HOUR	XFMR	TRANSFORMER
LV	LOW VOLTAGE		
MAX	MAXIMUM		

GENERAL NOTES


- ALL WORK SHALL COMPLY WITH APPLICABLE CODE.
- THIS SYSTEM HAS BEEN DESIGNED TO APPLICABLE SPECIFICATIONS. MODIFICATIONS MADE TO THE SYSTEM MAY CAUSE IMPROPER OPERATION UNLESS YOU NOTIFY ALSOENERGY OF THE CHANGES.
- INTERNAL DEVICES ARE SUPPLIED PRE-WIRED BY ALSO ENERGY WITH IP AND MODBUS ADDRESSING CONFIGURED.
- THE RS-485 BUS LINE IS DAISY-CHAINED CONFIGURATION FOR ALL DEVICES, I.E. NO MORE THAN TWO WIRES ON ANY TERMINAL.
- FOR RS-485 CONNECTIONS, GROUND THE DRAIN WIRE OF THE SHIELDED CABLE AT ONE END ONLY. DO NOT GROUND THE DRAIN WIRE AT BOTH ENDS OF A CABLE RUN.
- RS-485 CABLE SHALL MEET OR EXCEED BELDEN 3108A SPECIFICATIONS. 4000FT (1220M) MAX LENGTH PER BUS. 1000FT (305M) MAX BETWEEN EACH DEVICE.
- ETHERNET NETWORK CABLE (CAT5e or CAT6) SHALL MEET OR EXCEED BELDEN 7919A SPECIFICATIONS. 300FT (91M) MAX BETWEEN EACH ACTIVE DEVICE.
- SINGLE MODE FIBER CABLE WILL BE OS2 WITH LC CONNECTORS.
- MULTI-MODE FIBER CABLE WILL BE OM3/OM4 OR 62.5/125um WITH SC CONNECTORS. (PRE-TERMINATED WITH PULL RING RECOMMENDED FOR EASE OF INSTALL)
- SENSOR CABLES ARE CALIBRATED. LENGTH SHOULD NOT BE MODIFIED WITHOUT APPROVAL FROM ALSOENERGY.
- RADIO CONNECTIONS MUST BE LINE OF SIGHT.
- WARRANTY IS VOID IF HOLES ARE MADE ANYWHERE OTHER THAN BOTTOM OF ENCLOSURE OR IF BOTTOM HOLES ARE MADE WITHIN 1" (25.4MM) OF OTHERS.

COVER SHEET

DRAWN BY: PAVH
 CHECKED BY: PAVH
 DATE: 2/15/2019
 ISSUE: RELEASED FOR PERMITTING

AMEREN COMMUNITY SOLAR (MISSOURI BOTTOMS) AZIMUTH ENERGY EST118387
 SCALE: AS SHOWN
 SIZE: ANS C
 WMM043
 OF 7

1 ALSO ENERGY DETAILS: COVER SHEET

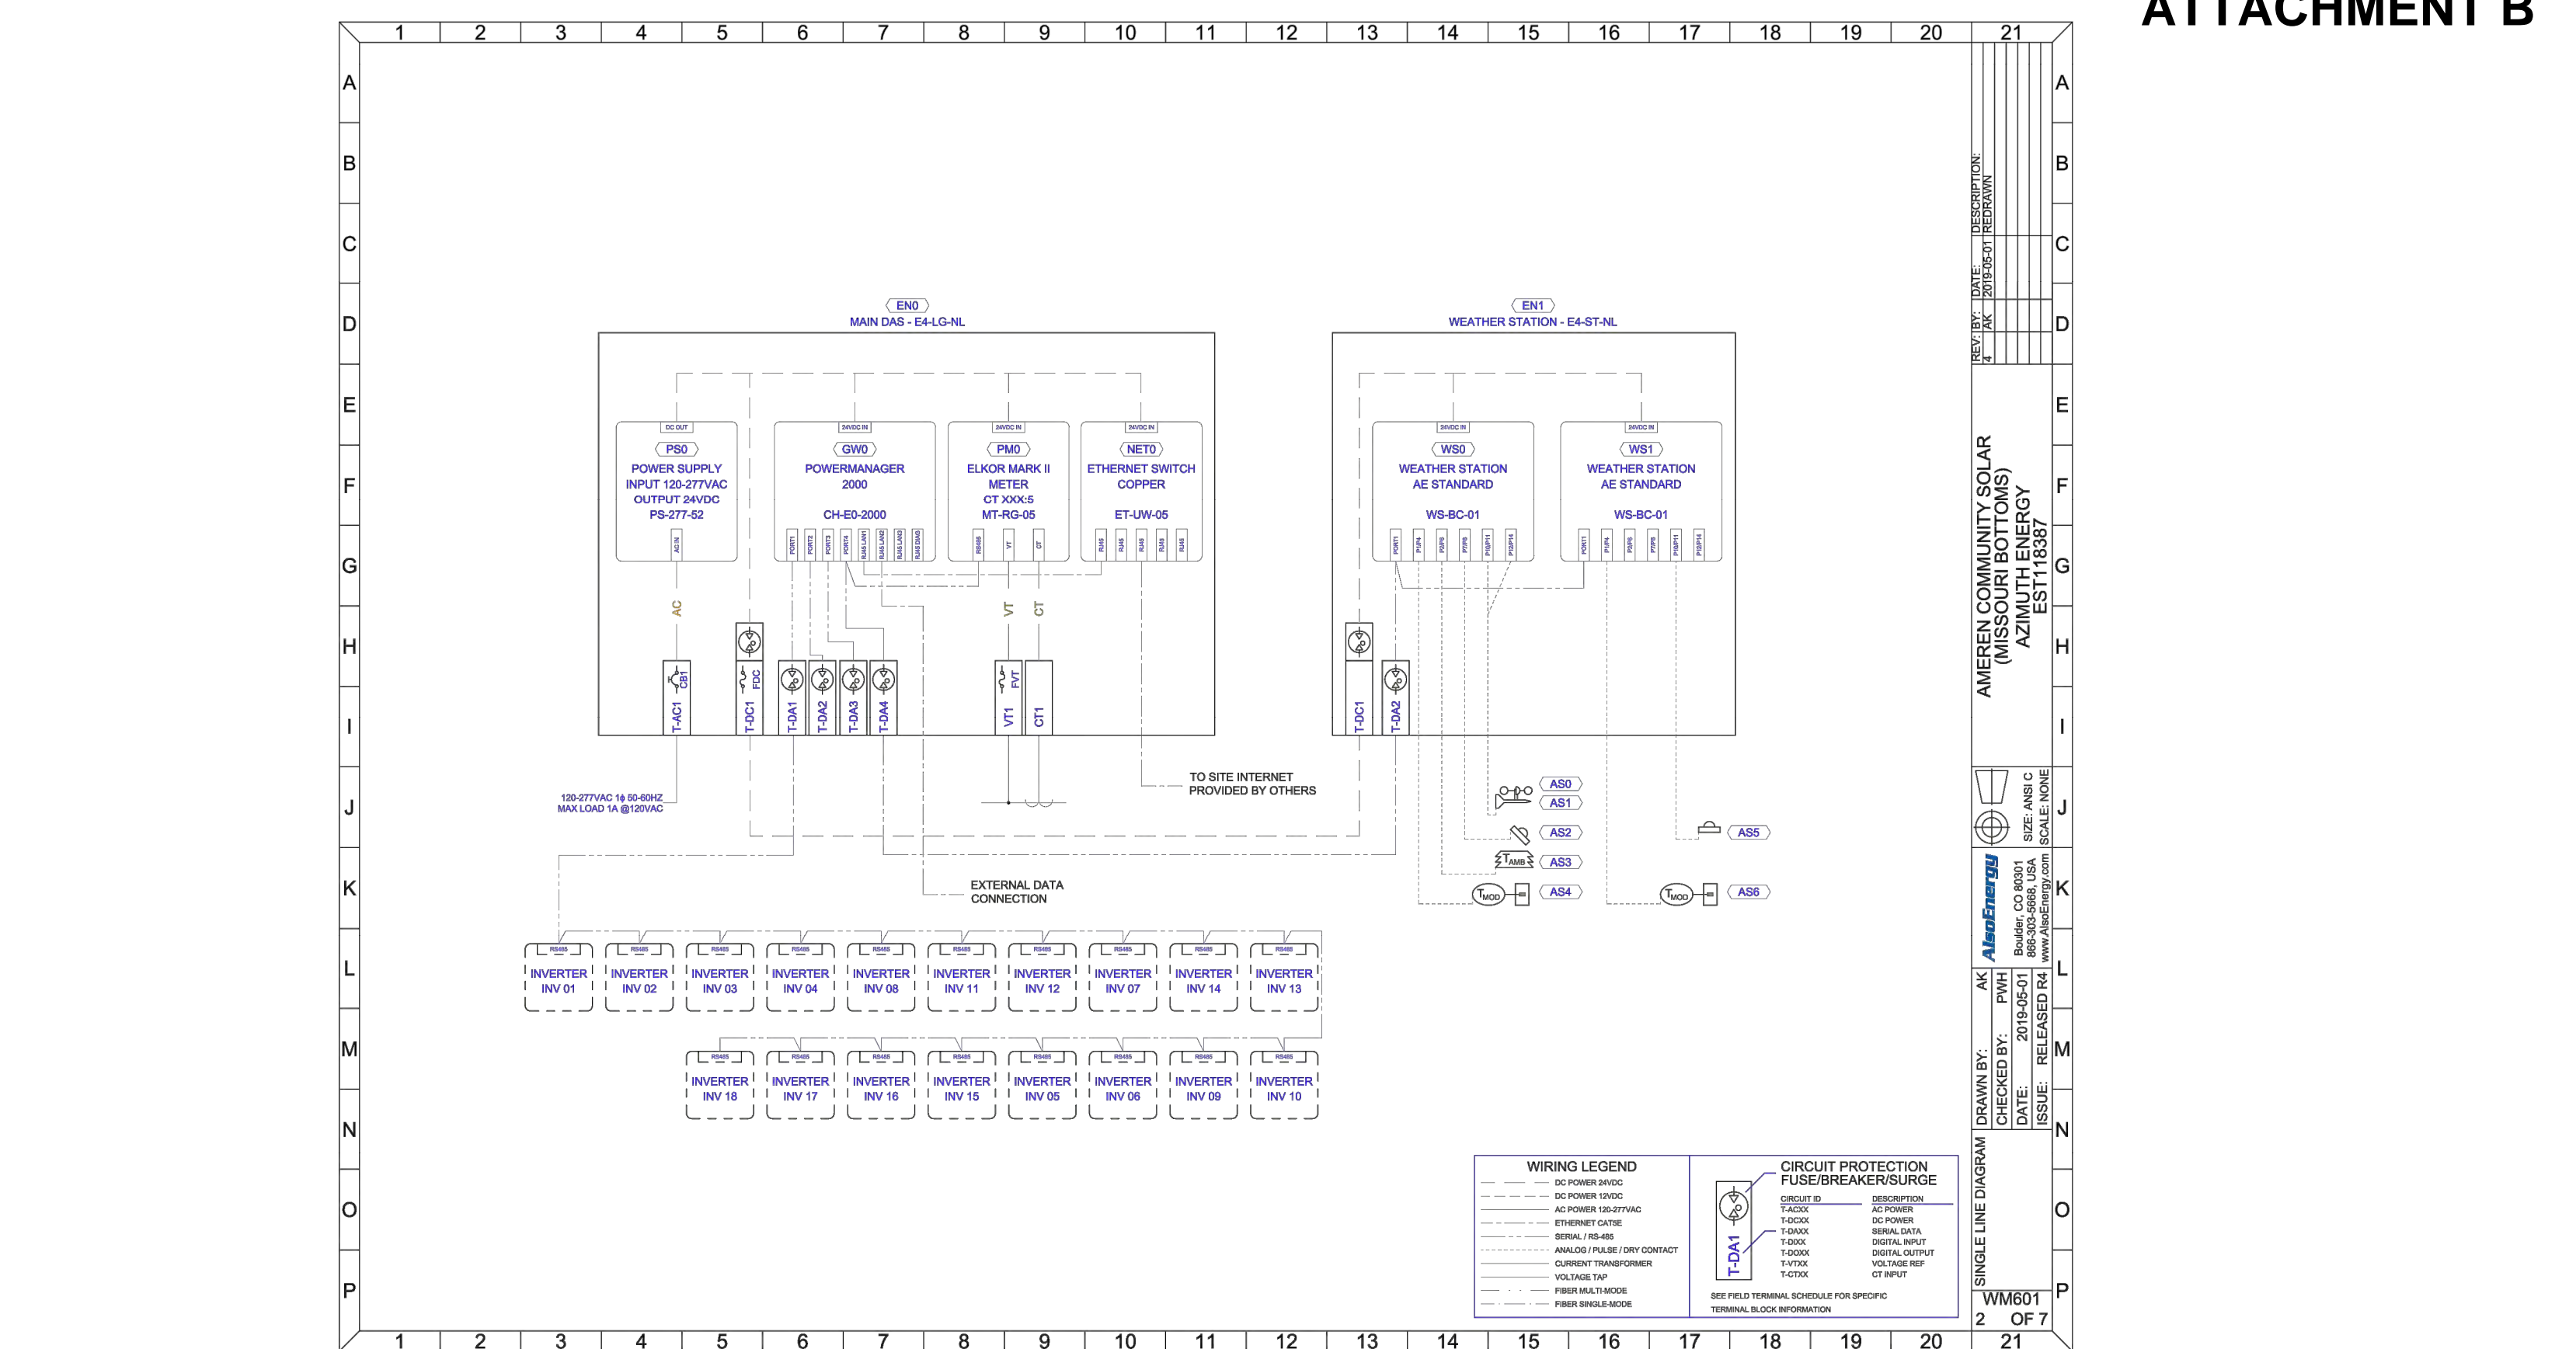

2 ALSO ENERGY DETAILS: SINGLE LINE DIAGRAM

COMMUNICATIONS SCHEDULES

DEVICE	ID	DESCRIPTION	COMMUNICATION PROTOCOL	COMMUNICATION PORT / CHANNEL	MASTER	UNIT ID	IP ADDRESS	SUPPLIER
DATALOGGER AND GATEWAY	GW0	POWERMANAGER 2000	TCP/IP	LAN1	POWERTRACK	-	STATIC TR0	ALSOENERGY
PRODUCTION METER	PMB	ELKOR MARK II	MODBUS RTU	T-G04	GND	41	-	ALSOENERGY
INVERTER 1	PV0	SOLECTRA PV100TL-480	MODBUS RTU	T-G01	GND	51	-	BY OTHERS
INVERTER 2	PV1	SOLECTRA PV100TL-480	MODBUS RTU	T-G01	GND	52	-	BY OTHERS
INVERTER 3	PV2	SOLECTRA PV100TL-480	MODBUS RTU	T-G01	GND	53	-	BY OTHERS
INVERTER 4	PV3	SOLECTRA PV100TL-480	MODBUS RTU	T-G01	GND	54	-	BY OTHERS
INVERTER 5	PV4	SOLECTRA PV100TL-480	MODBUS RTU	T-G01	GND	55	-	BY OTHERS
INVERTER 6	PV5	SOLECTRA PV100TL-480	MODBUS RTU	T-G01	GND	56	-	BY OTHERS
INVERTER 7	PV6	SOLECTRA PV100TL-480	MODBUS RTU	T-G01	GND	57	-	BY OTHERS
INVERTER 8	PV7	SOLECTRA PV100TL-480	MODBUS RTU	T-G01	GND	58	-	BY OTHERS
INVERTER 9	PV8	SOLECTRA PV100TL-480	MODBUS RTU	T-G01	GND	59	-	BY OTHERS
INVERTER 10	PV9	SOLECTRA PV100TL-480	MODBUS RTU	T-G01	GND	60	-	BY OTHERS
INVERTER 11	PV10	SOLECTRA PV100TL-480	MODBUS RTU	T-G01	GND	61	-	BY OTHERS
INVERTER 12	PV11	SOLECTRA PV100TL-480	MODBUS RTU	T-G01	GND	62	-	BY OTHERS
INVERTER 13	PV12	SOLECTRA PV100TL-480	MODBUS RTU	T-G01	GND	63	-	BY OTHERS
INVERTER 14	PV13	SOLECTRA PV100TL-480	MODBUS RTU	T-G01	GND	64	-	BY OTHERS
INVERTER 15	PV14	SOLECTRA PV100TL-480	MODBUS RTU	T-G01	GND	65	-	BY OTHERS
INVERTER 16	PV15	SOLECTRA PV100TL-480	MODBUS RTU	T-G01	GND	66	-	BY OTHERS
INVERTER 17	PV16	SOLECTRA PV100TL-480	MODBUS RTU	T-G01	GND	67	-	BY OTHERS
INVERTER 18	PV17	SOLECTRA PV100TL-480	MODBUS RTU	T-G01	GND	68	-	BY OTHERS
WEATHER STATION 1	WS0	ALSOENERGY WEATHER STATION	MODBUS RTU	T-G04	GND	16	-	ALSOENERGY
WEATHER STATION 2	WS1	ALSOENERGY WEATHER STATION	MODBUS RTU	T-G04	GND	17	-	ALSOENERGY
WIND SPEED	AS0	DAVIS ANEMOMETER	ANALOG PULSE	P12 / PH2	WS0	-	-	ALSOENERGY
WIND DIRECTION	AS1	DAVIS ANEMOMETER	ANALOG HV	P18 / PH1	WS0	-	-	ALSOENERGY
POA PYRANOMETER	AS2	AP050E	ANALOG HV	P7 / PH	WS0	-	-	ALSOENERGY
MODULE TEMP	AS3	BMV MODULE	ANALOG I/A	P2 / PE	WS0	-	-	ALSOENERGY
MODULE TEMPERATURE 1	AS4	BMV MODULE	ANALOG I/A	P1 / PE	WS0	-	-	ALSOENERGY
GH PYRANOMETER	AS5	AP050E	ANALOG HV	P12 / PH1	WS1	-	-	ALSOENERGY
MODULE TEMPERATURE 2	AS6	BMV MODULE	ANALOG I/A	P1 / PH1	WS1	-	-	ALSOENERGY


STATIC IP ADDRESSES ARE REQUIRED AS INDICATED FOR DEVICE COMMUNICATION. THE FOLLOWING ARE REQUIRED FOR SITE COMMUNICATION:
 - DEFAULT GATEWAY
 - SUBNET MASK
 - STATIC IP FOR ALL DEVICES INDICATED IN THE COMMUNICATIONS SCHEDULE.

COVER SHEET

DRAWN BY: PAVH
 CHECKED BY: PAVH
 DATE: 2/15/2019
 ISSUE: RELEASED FOR PERMITTING

AMEREN COMMUNITY SOLAR (MISSOURI BOTTOMS) AZIMUTH ENERGY EST118387
 SCALE: AS SHOWN
 SIZE: ANS C
 WMM021
 OF 7

3 ALSO ENERGY DETAILS: SCHEDULES

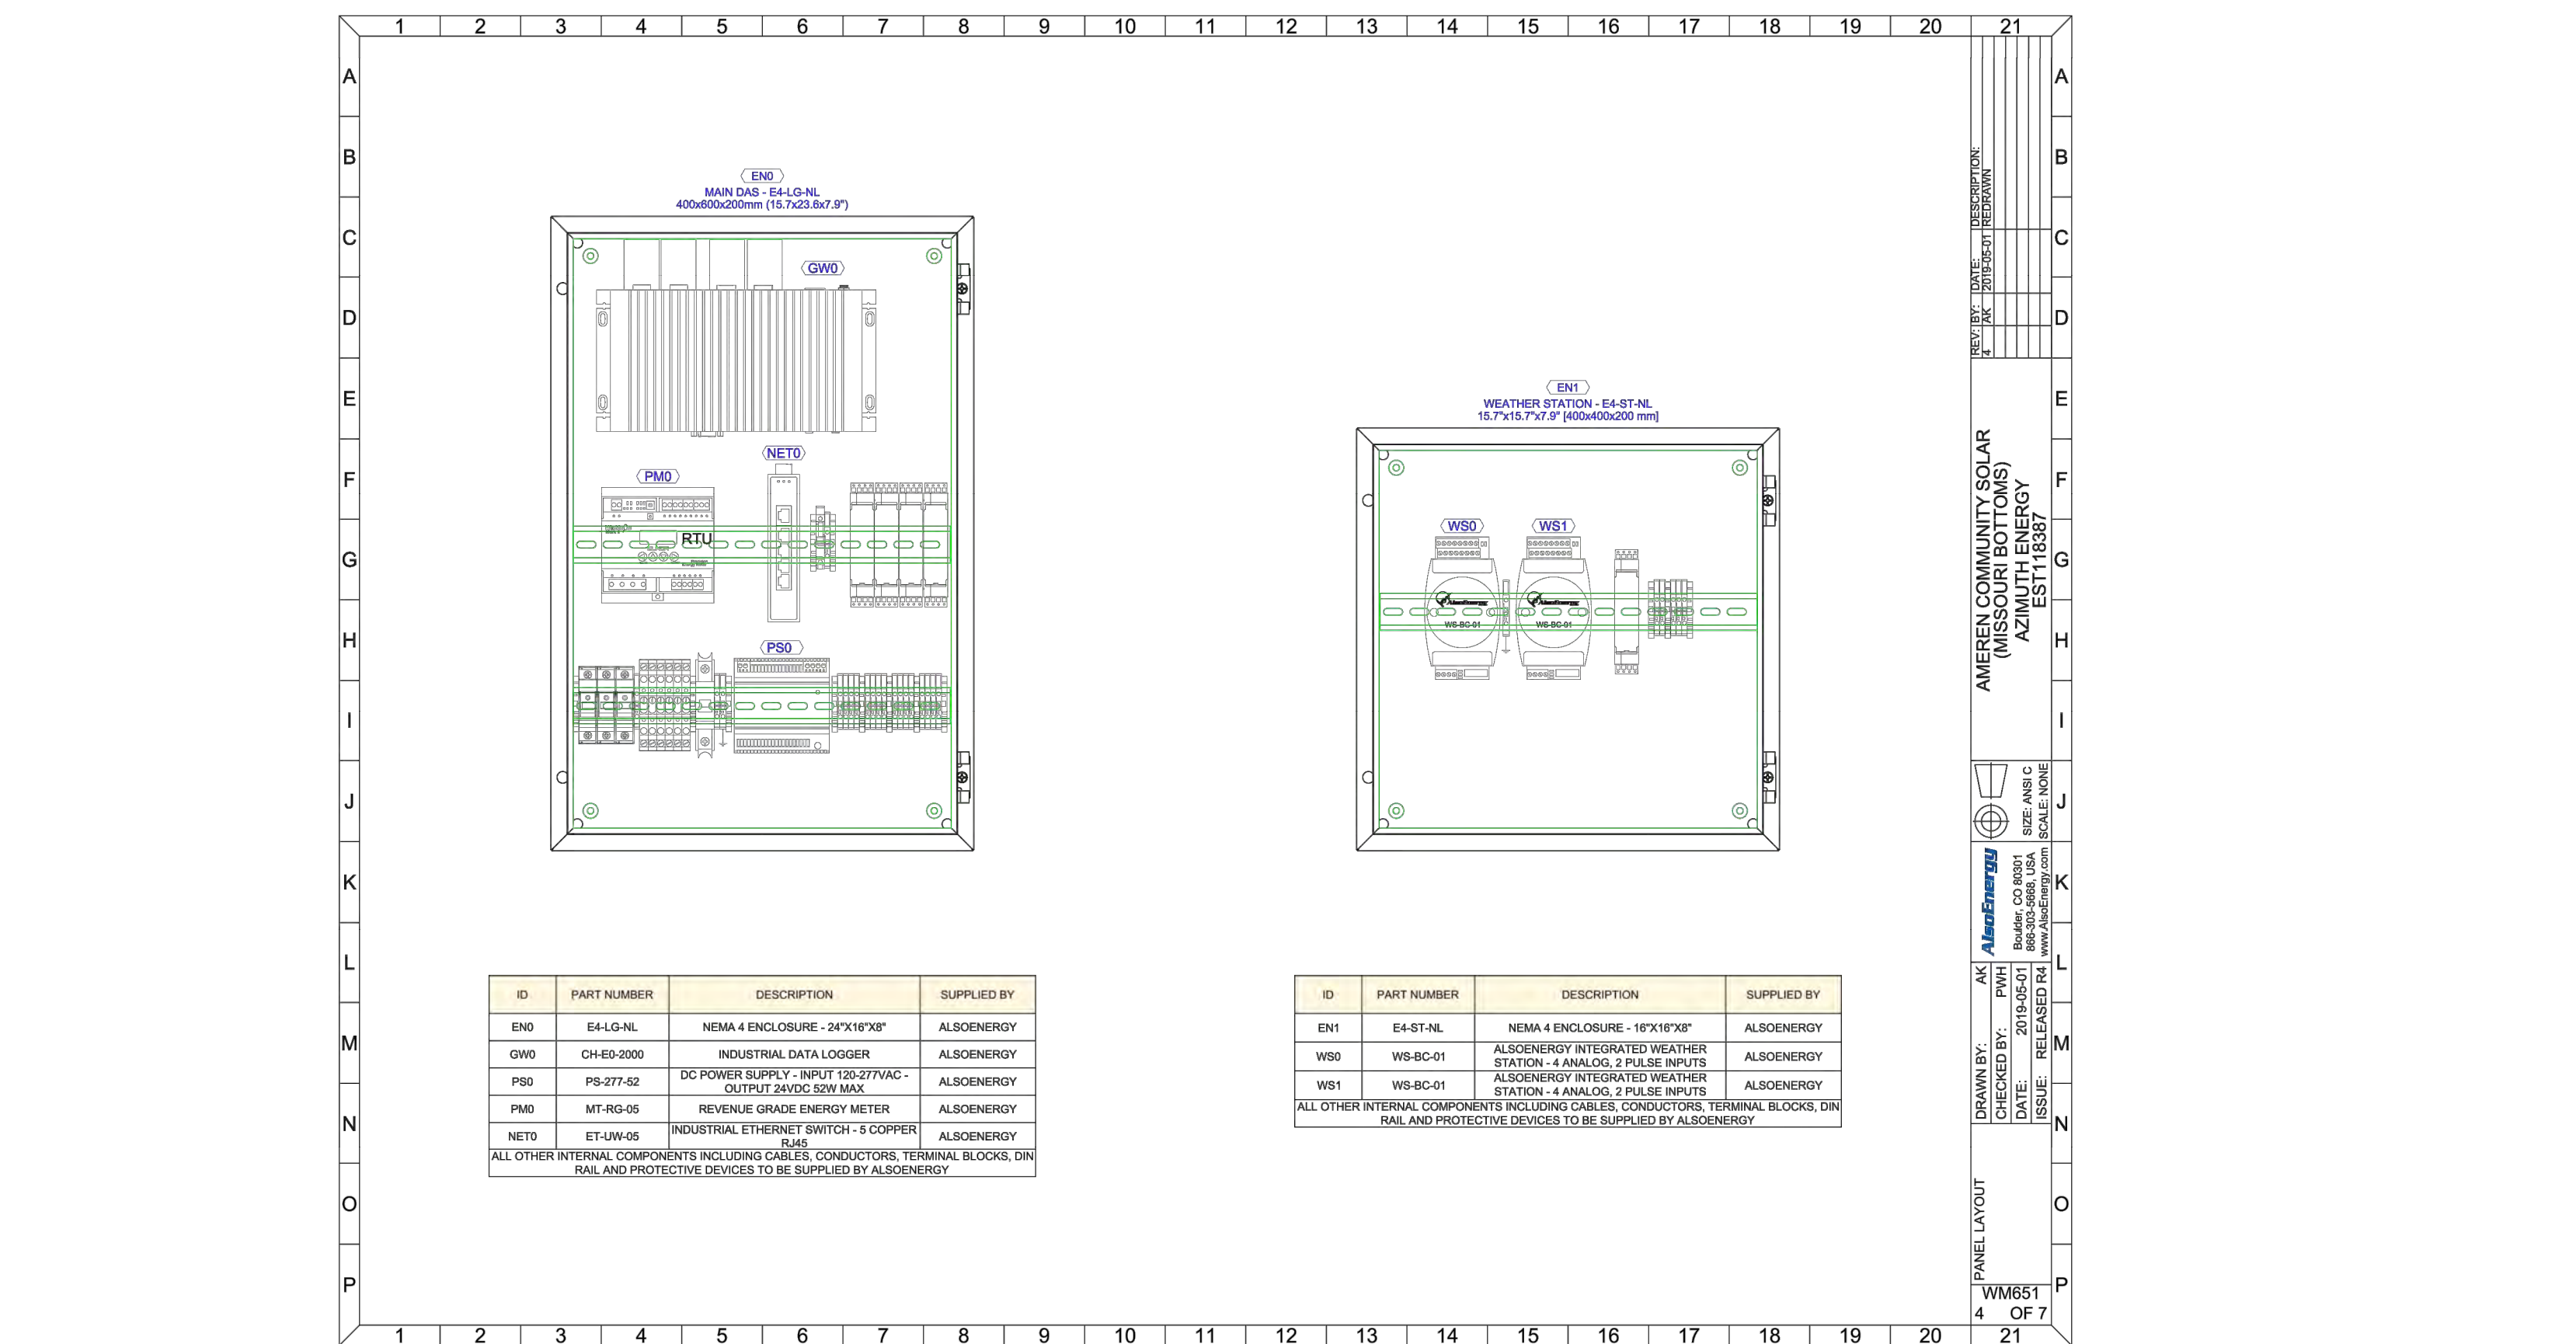

4 ALSO ENERGY DETAILS: PANEL LAYOUT

NABCEP CERTIFIED
Professional
PV Installation

CERTIFICATES: MARC LOPATA, PE CERT # 0911-110-241 DANIEL STROH, EIT CERT # 042013-130

PROFESSIONAL ENGINEER
MAR 15 2019
NUMBER PE-2000403330

CERTIFICATES: MARC LOPATA, PE CERT # PVSI-120917-006937

OPERATING DIAGRAM

NOTICE OF LIMITED RESPONSIBILITY

THE RESPONSIBILITY OF THE UNDERSIGNED ENGINEER IS LIMITED TO THE DESIGN WORK SHOWN ON PROJECT AND RECORDS. BEARING THEREON. THE UNDERSIGNED ENGINEER DOES NOT HAVE AUTHORITY OVER THE PROJECT AS A WHOLE. THE UNDERSIGNED DISCLAIMS ANY RESPONSIBILITY FOR WORK DONE UNDER SUBSEQUENT REVISIONS AND ANY OTHER DOCUMENTS ASSOCIATED WITH THE PROJECT WHICH DO NOT BEAR HIS/HER SIGNATURE OR INITIALS.


MARK UP DRAWING NO. ---
 REV. ---

MONITORING DETAILS


UNIT NO: NOT TO SCALE
 DWG. SIZE: Y ARCH D (36X24)
 SUB CLASS: ---

SITE: AMEREN MISSOURI LAMBERT COMMUNITY SOLAR CENTER
 DRAWING NO.: LC-DWG-FPD-00002
 REVISION NO.: 0


REV.	DATE	PROJECT NO.	DRAWING NO.	DRAWN BY	CHECKED BY	SUPV.	ENGR.	DESCRIPTION
A	03/04/19	1704-101	CJ/B	DIR	DAS	ML		CONSTRUCTION DRAWINGS
B	3/15/2019	1704-101	CJ/B	DAS	DAS	ML		FENCE UPDATES
C	5/6/2019	1704-101	CJ/B					MONITORING UPDATES
D	5/21/2019	1704-101	CJ/B					SECURITY ENCLOSURE

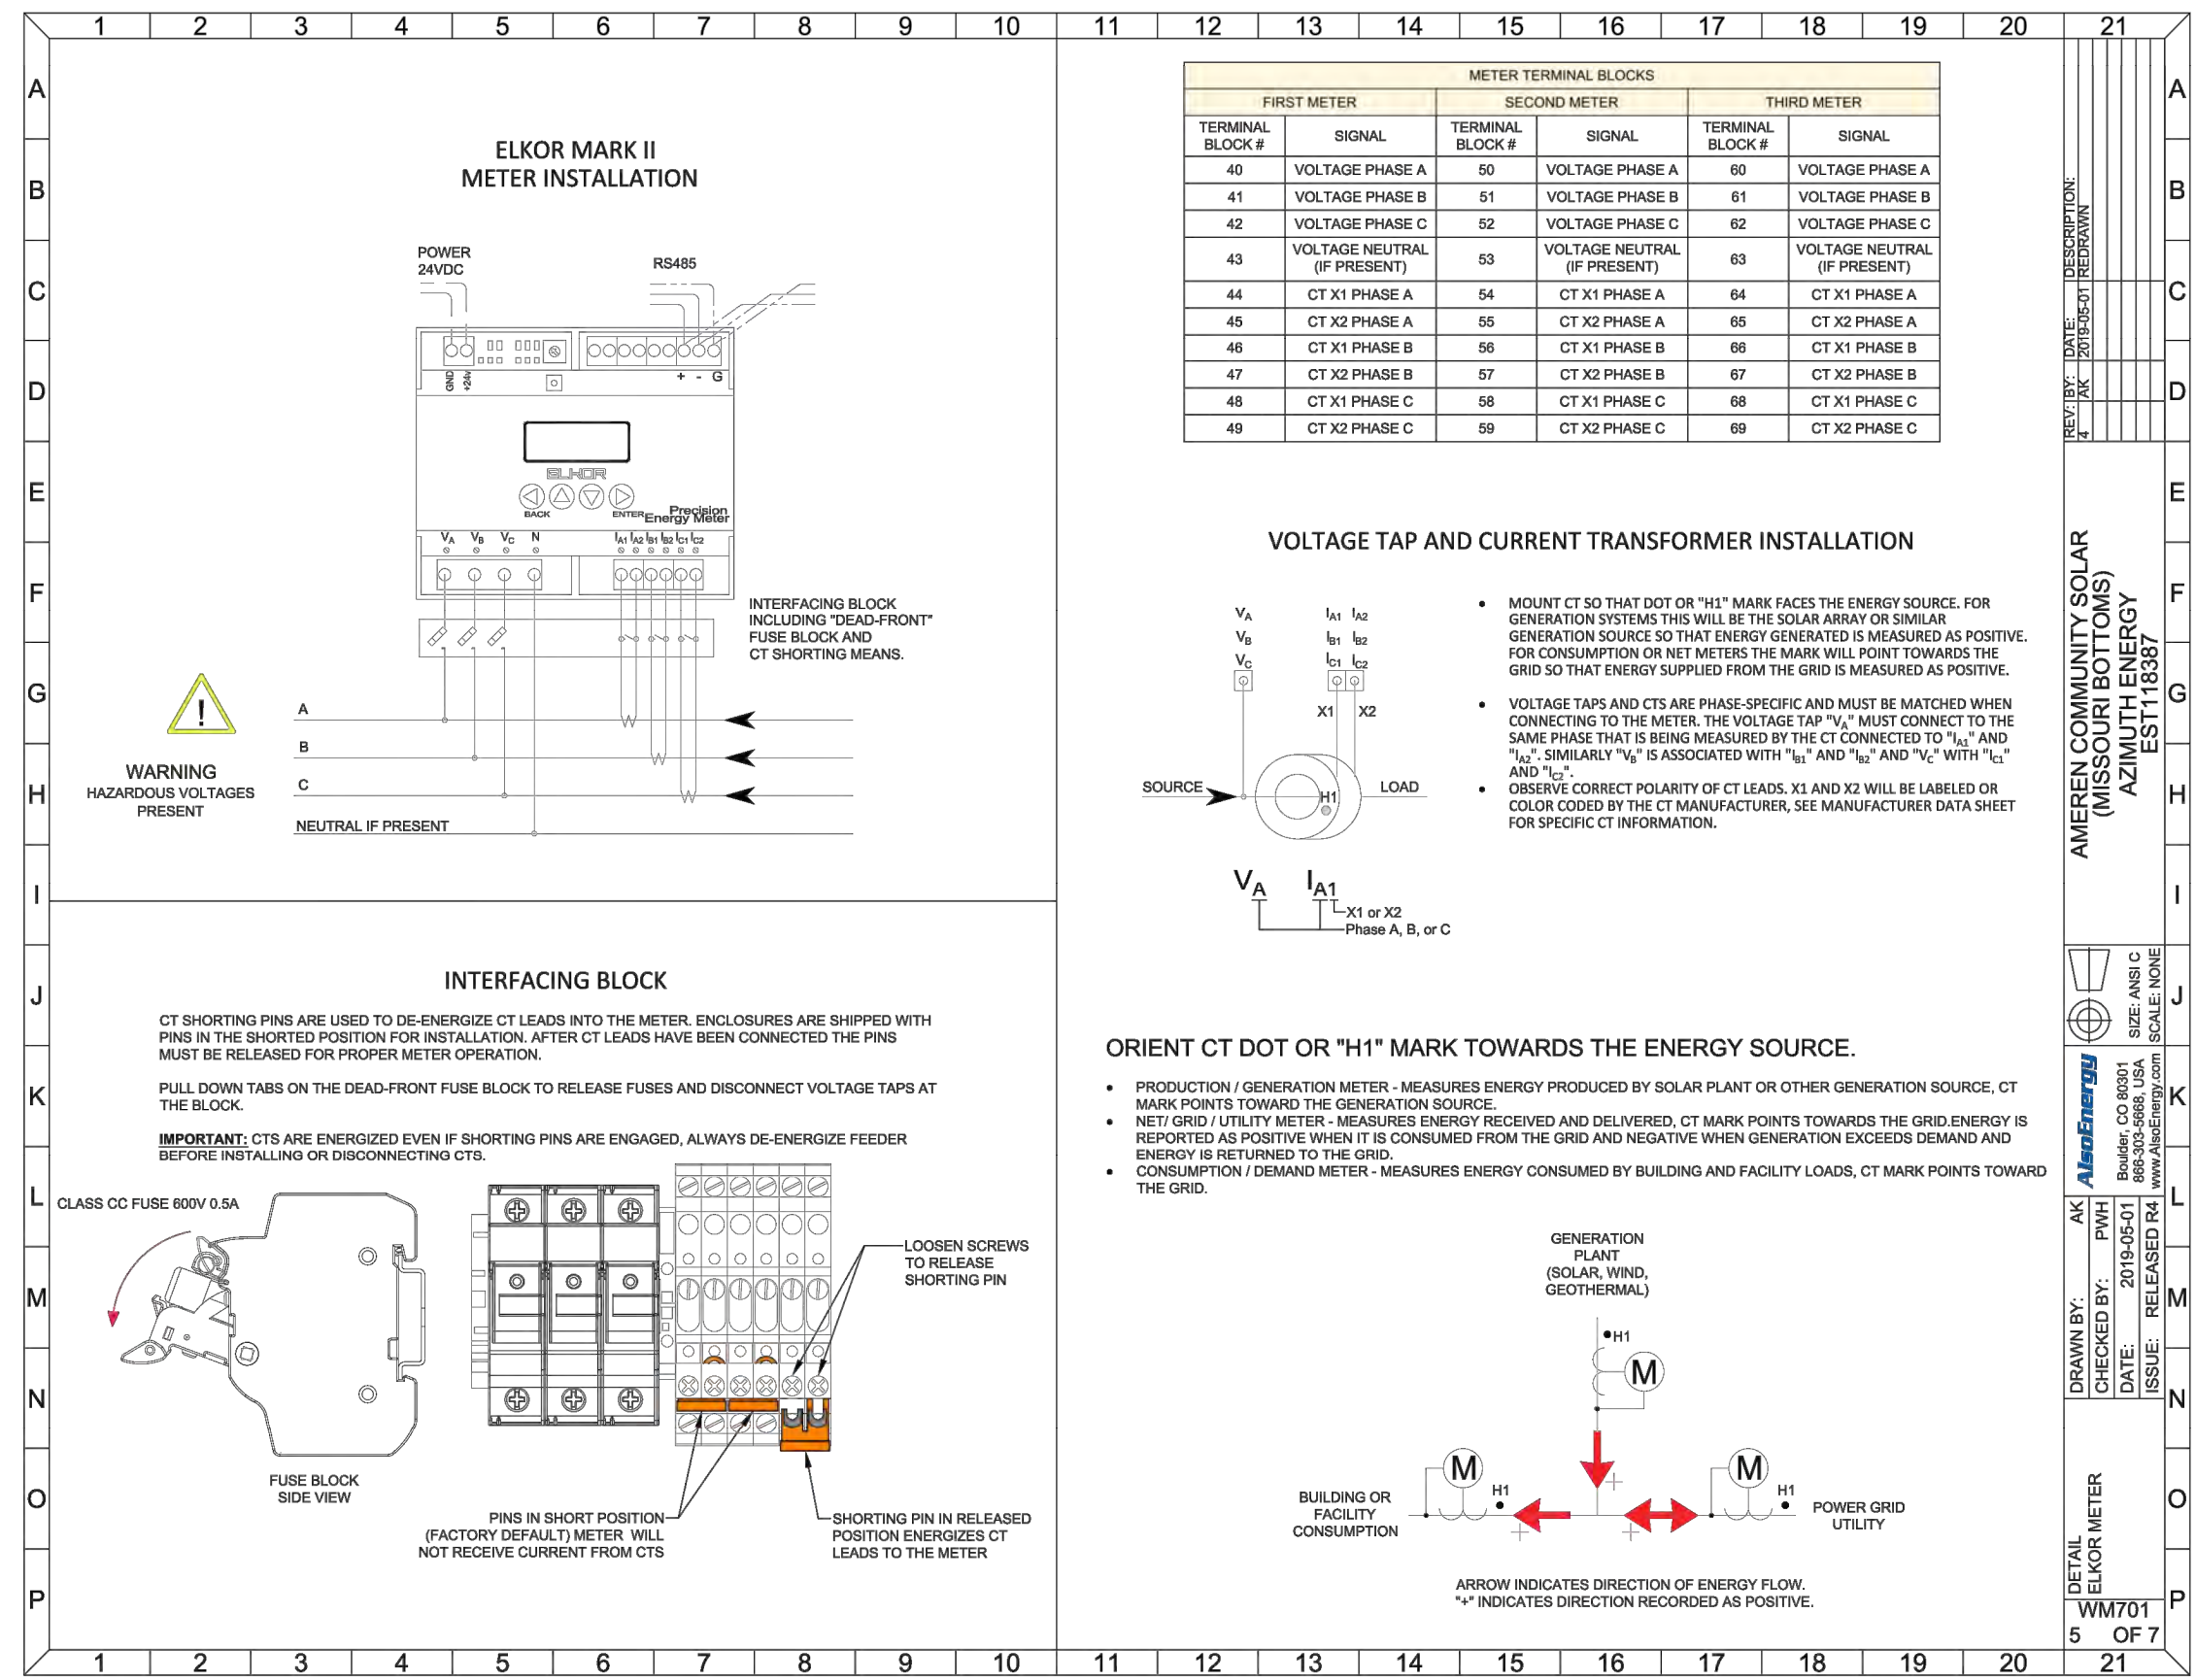

1 ALSO ENERGY DETAILS: DETAIL ELKOR METER

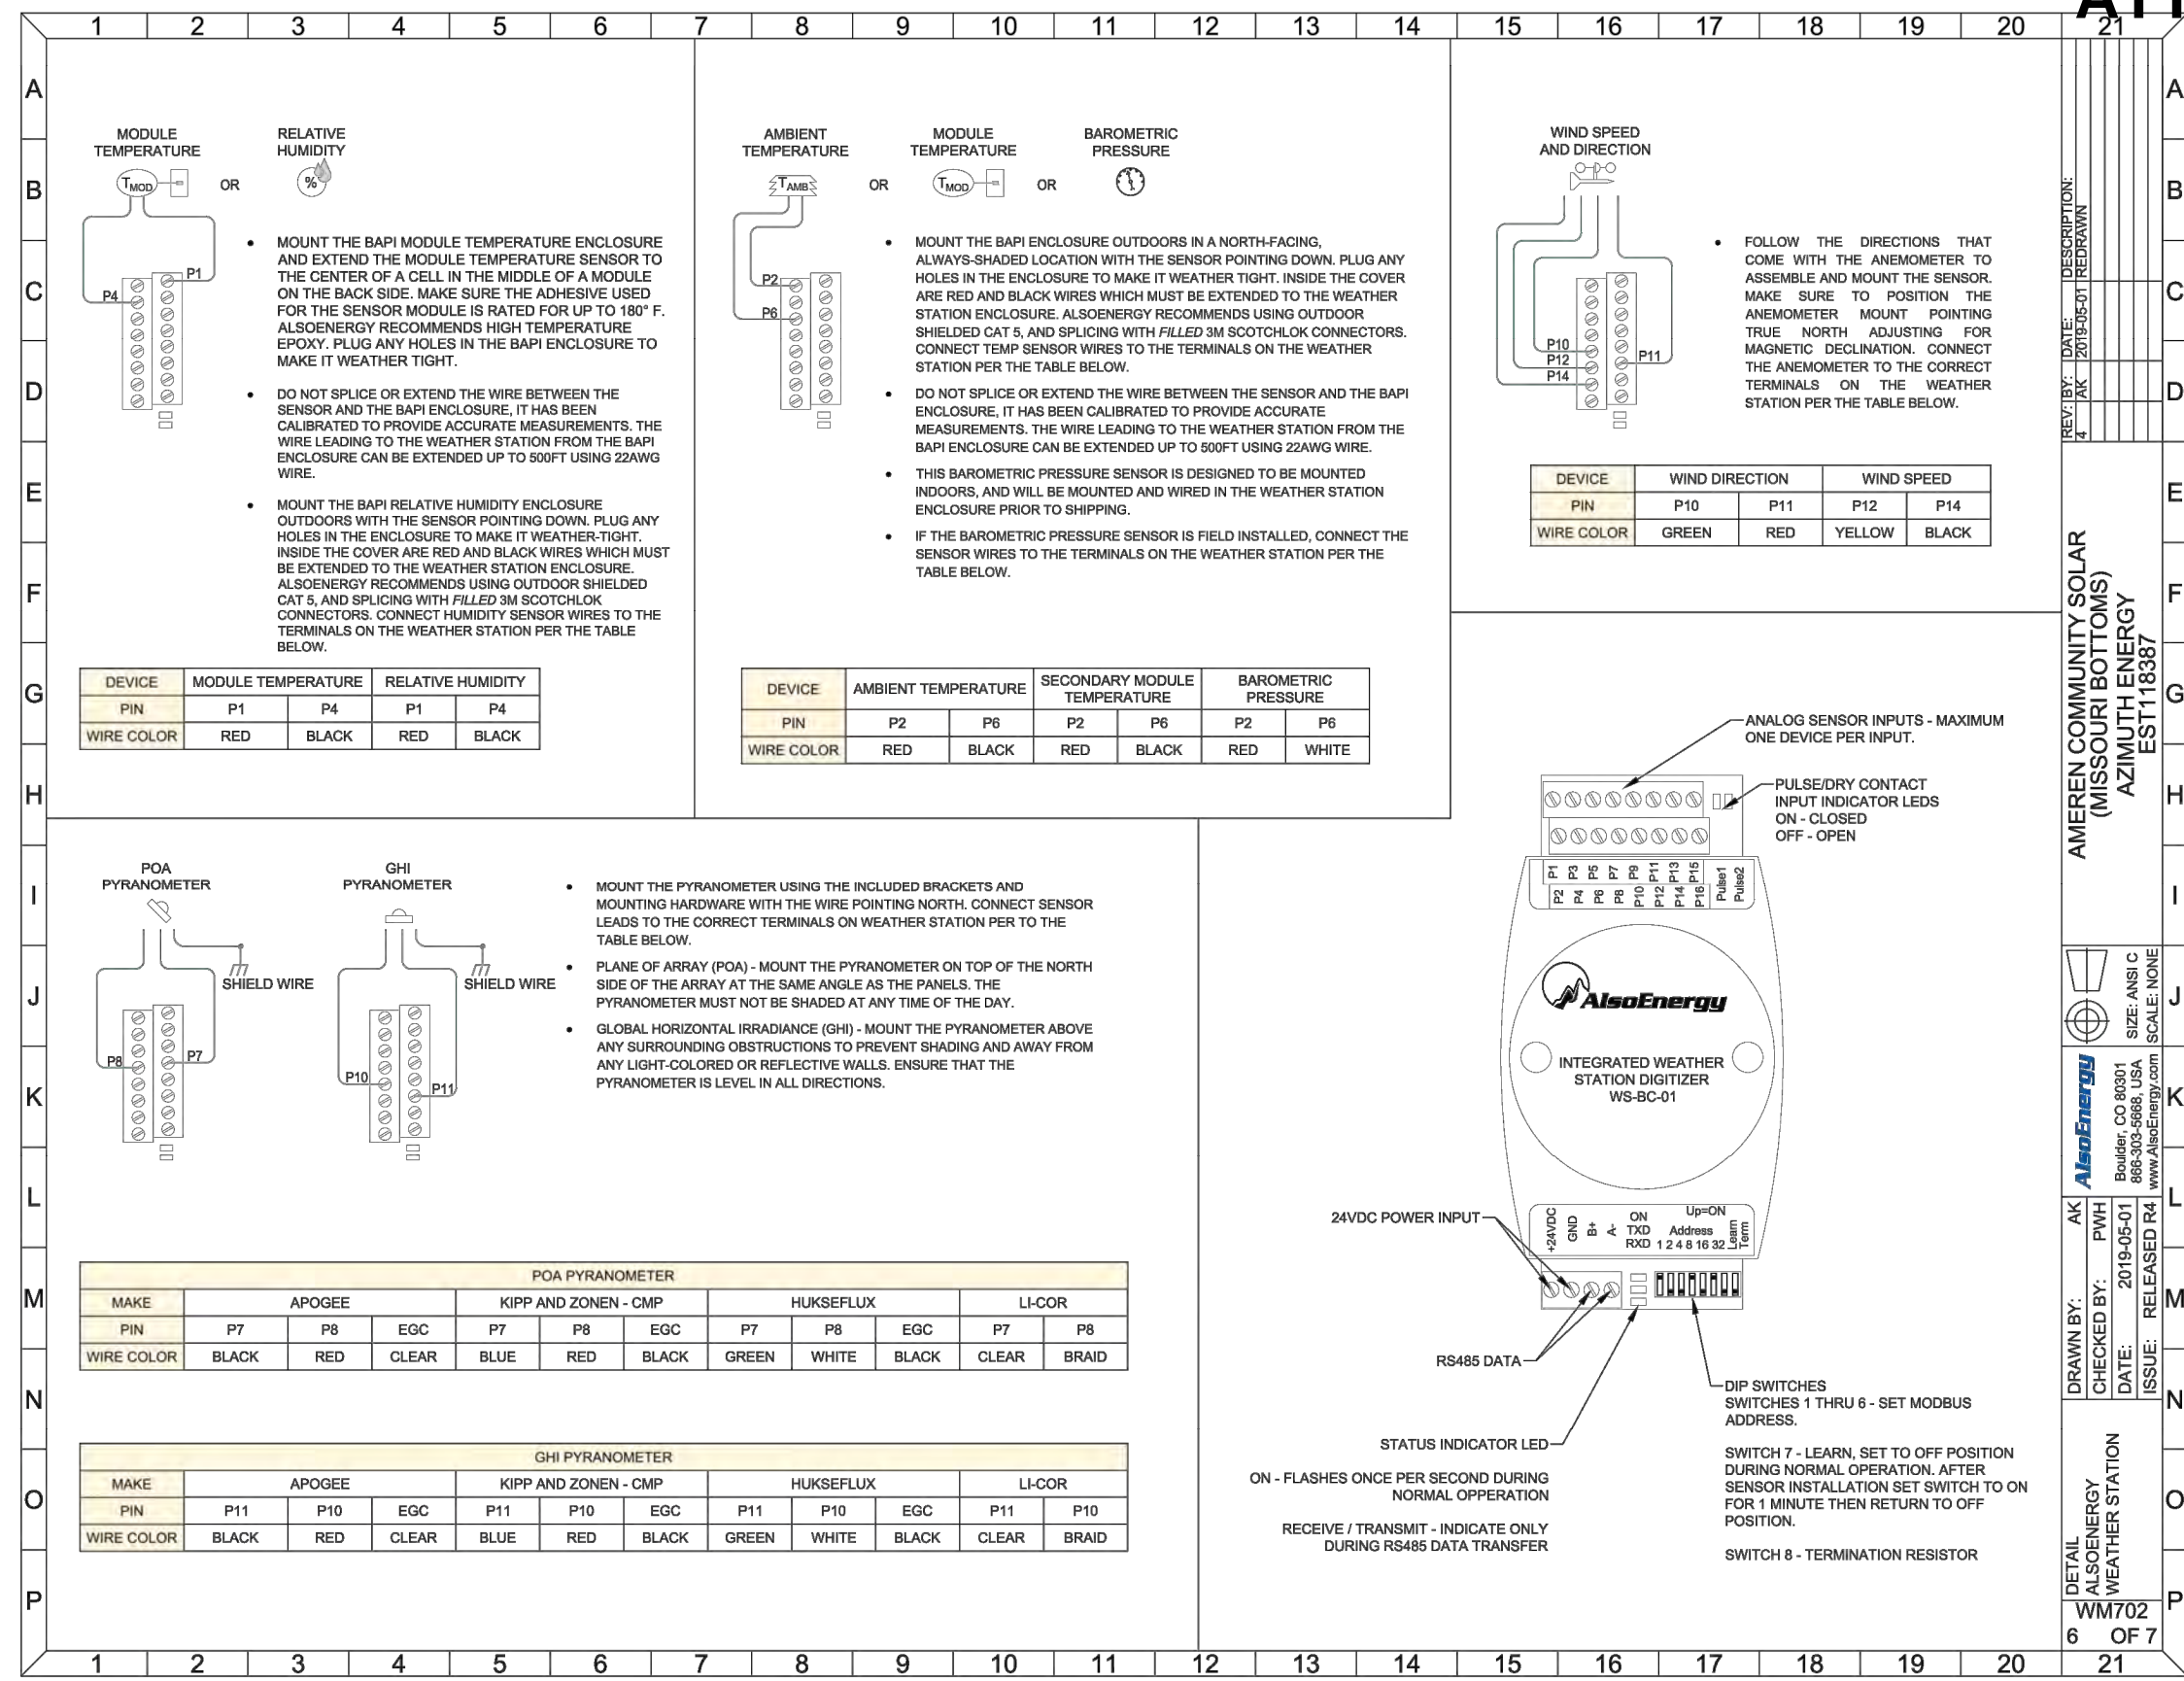

2 ALSO ENERGY DETAILS: DETAIL ALSO ENERGY WEATHER STATION

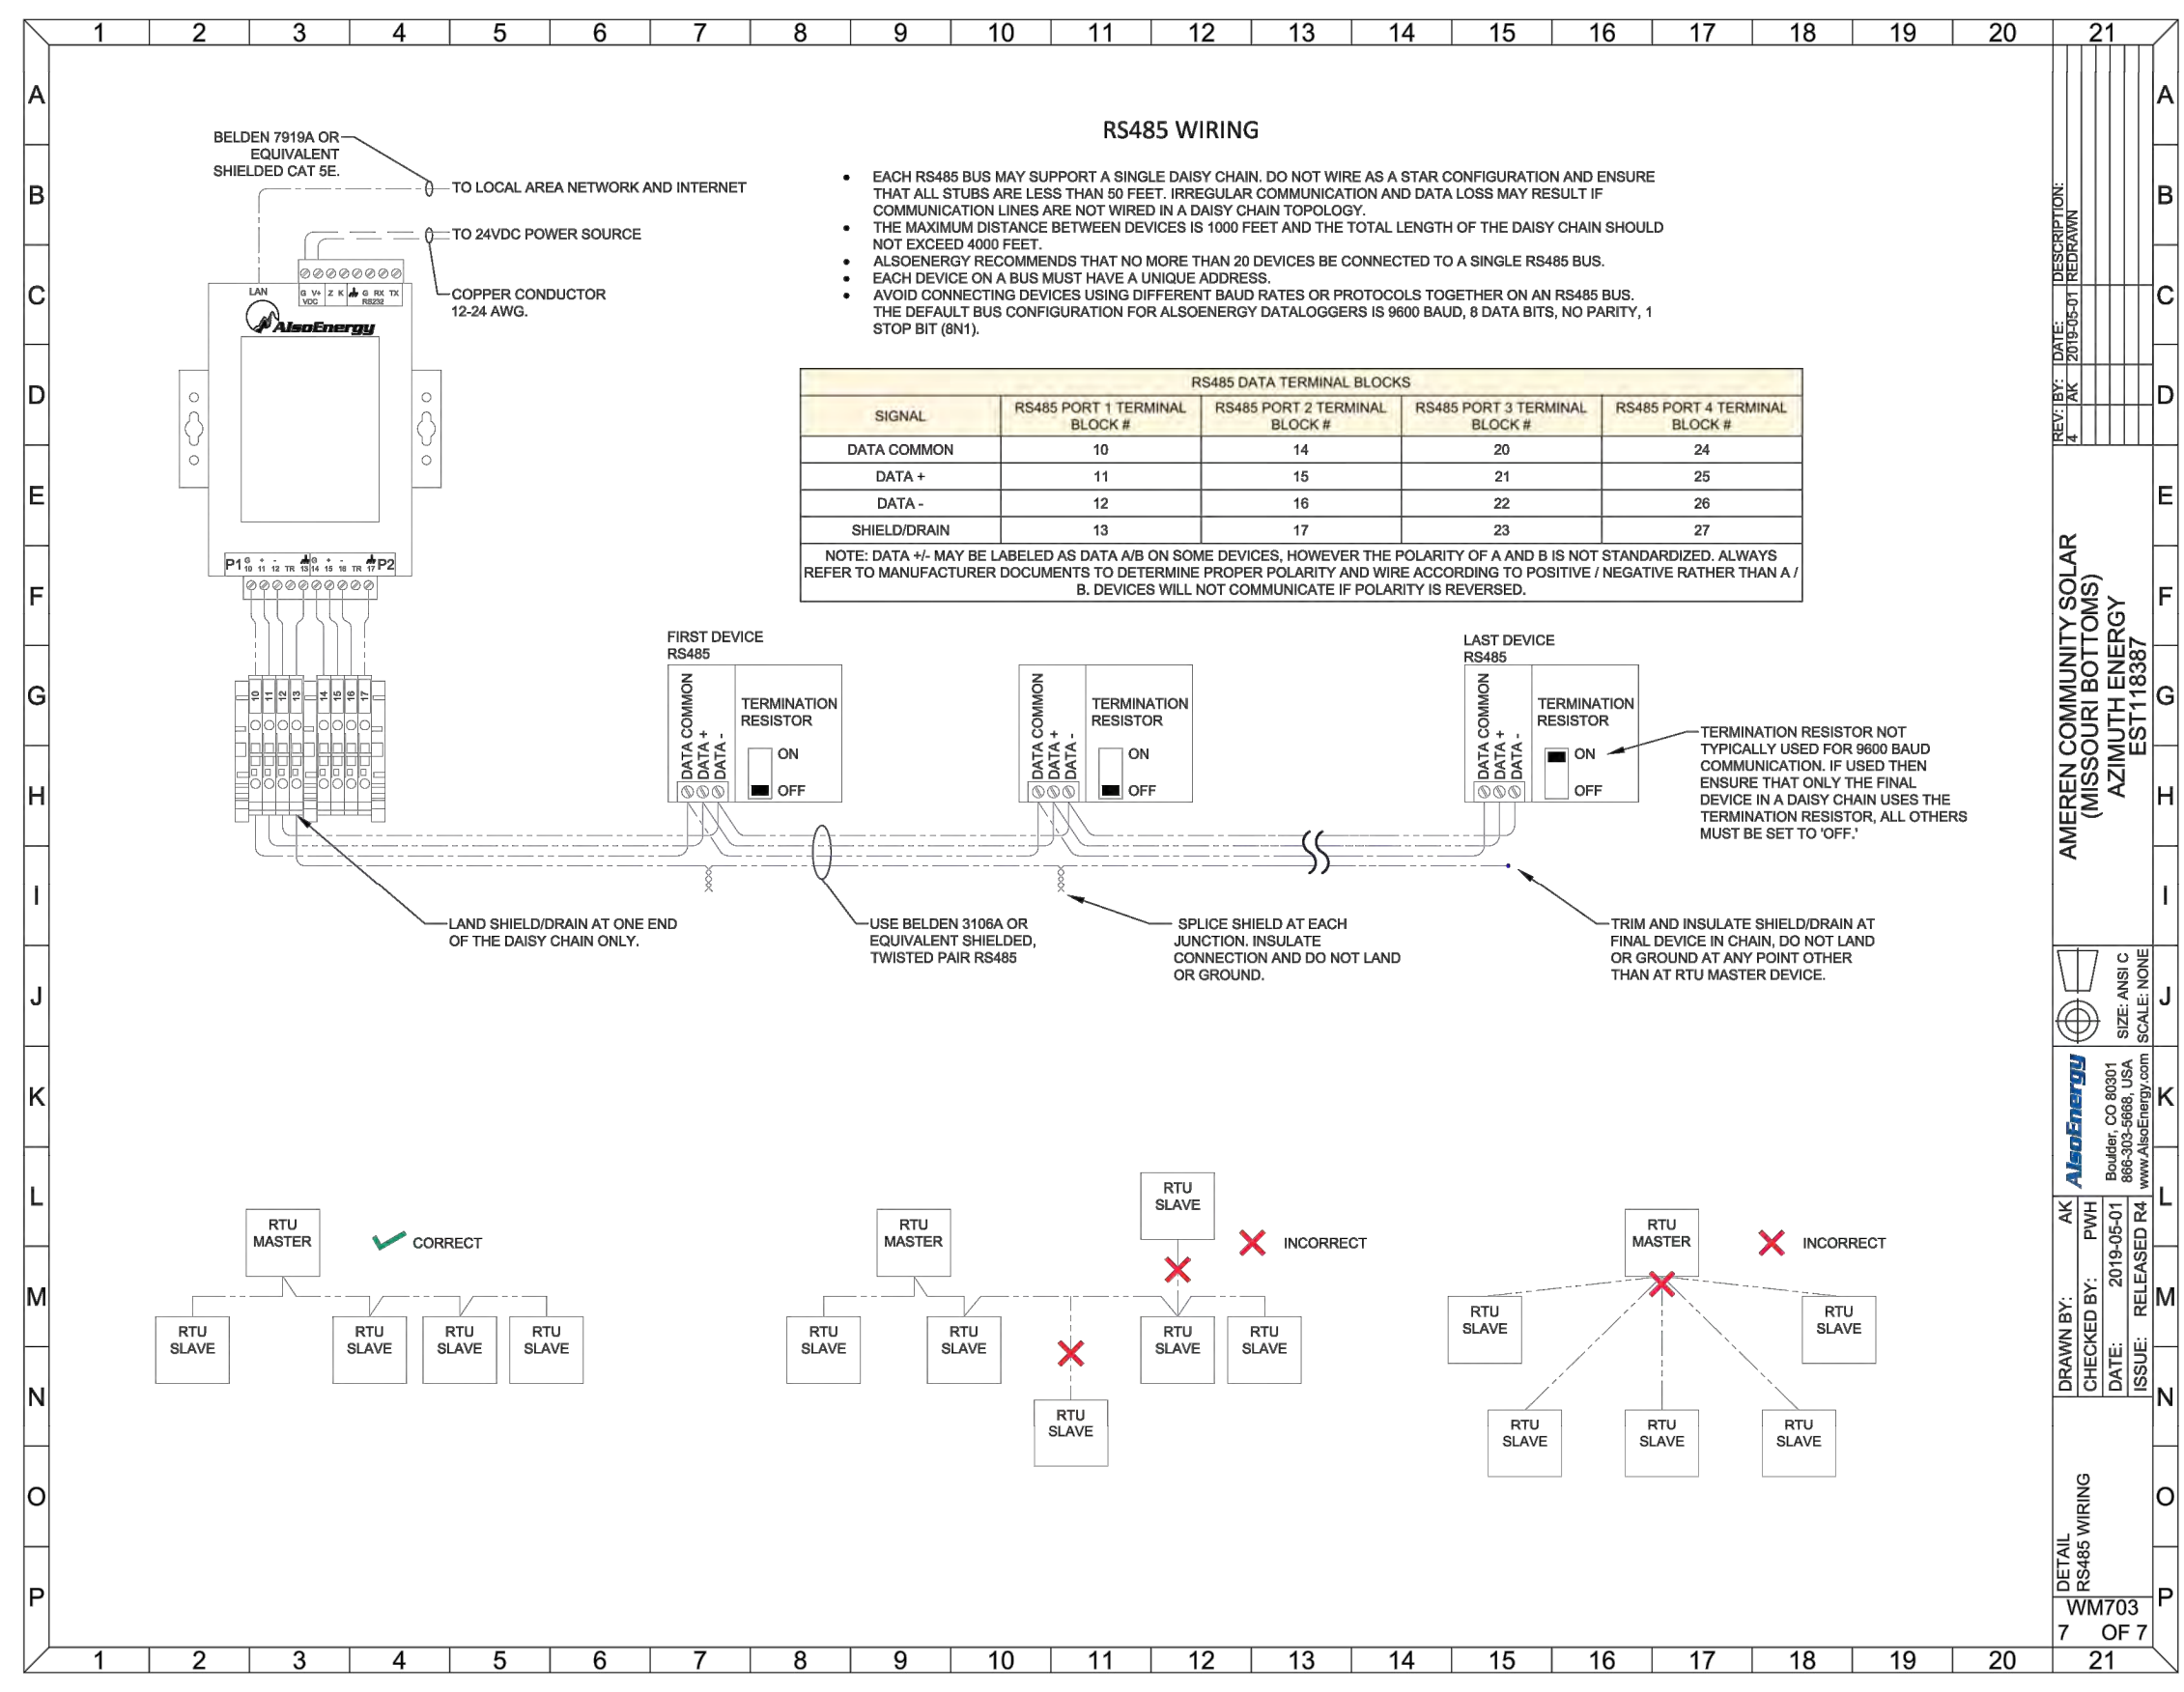

3 ALSO ENERGY DETAILS: DETAIL RS485 WIRING

NABCEP CERTIFIED

CERTIFICATES: MARC LOPATA, PE CERT # 0911102-241 DANIEL STROH, EIT CERT # 042013-130

NABCEP CREDENTIALLED

CERTIFICATES: MARC LOPATA, PE CERT # PVSI-120917-006937

PROFESSIONAL ENGINEER

MARC LOPATA
MAR 15 2019
NUMBER PE-2004023383

OPERATING DIAGRAM

NOTICE OF LIMITED RESPONSIBILITY

THE RESPONSIBILITY OF THE UNDERSIGNED ENGINEER IS LIMITED TO THE DESIGN WORK SHOWN ON PROJECT AND DOCUMENTS BEARING HIS/HER SEAL, SIGNATURE OR INITIALS. HE/SHE DOES NOT HAVE AUTHORITY OVER THE PROJECT AS A WHOLE. THE UNDERSIGNED DISCLAIMS ANY RESPONSIBILITY FOR WORK DONE UNDER SUBSEQUENT REVISIONS AND ANY OTHER DOCUMENTS ASSOCIATED WITH THE PROJECT WHICH DO NOT BEAR HIS/HER SEAL, SIGNATURE OR INITIALS.

MARK UP DRAWING NO. REV.

SCALE: NOT TO SCALE

UNIT NO. Y ARCH D (36X24)

DWG. SIZE

SUB CLASS

MONITORING DETAILS

SITE: AMEREN MISSOURI LAMBERT COMMUNITY SOLAR CENTER

DRAWING NO. LC-DWG-FPD-00003

REVISION NO. 0

DRAWING RECORD

REV.	DATE	PROJECT NO.	DRAFTING	CHKD	SUPV	ENGR	DESCRIPTION
A	03/04/19	1704-101	CJB	DIR	DAS	ML	CONSTRUCTION DRAWINGS
B	3/15/2019	1704-101	CJB	DAS	DAS	ML	FENCE UPDATES
C	5/8/2019	1704-101	CJB	DAS	DAS	ML	MONITORING UPDATES
D	5/21/2019	1704-101	CJB				SECURITY ENCLOSURE

PROPOSED SOLAR POWER SITES:
AMEREN PROJECT
11601 MISSOURI BOTTOM RD.
SAINT LOUIS, MO 63145

PREPARED FOR:
AZIMUTH ENERGY
4220 DUNCAN AVE. STE 201
ST. LOUIS, MO 63110

PREPARED BY:
SOLAR FLEXRACK
A DIVISION OF NORTHERN STATES METALS
3207 INNOVATION PLACE
YOUNGSTOWN, OHIO 44509
PHONE: 1-888-380-8138



NORTH
PROJECT SITE

GENERAL NOTES:

1. CODES AND STANDARDS
IBC 2012
NEC 2017
AISC 360-10
AISI S100-10
ASCE 7-10
 2. WIND DESIGN PARAMETERS:
DESIGN WIND SPEED, V - 105 MPH
RISK CATEGORY - I
WIND EXPOSURE, KZ - 0.85
TOPOGRAPHIC FACTOR, KZT - 1.00
WIND DIRECTIONALITY FACTOR, KD - 0.85
GUST FACTOR & NET PRESSURE COEFFICIENT, GCN (BASED ON WIND TUNNEL STUDY)
UPWARD - 1.2
DOWNWARD - 0.97
 3. SNOW DESIGN PARAMETERS:
GROUND SNOW LOAD, Pf - 20 PSF
SNOW EXPOSURE FACTOR, Ce - 0.9
IMPORTANCE FACTOR, I - 0.8
SNOW THERMAL FACTOR, Ct - 1.2
SNOW REDUCTION FACTOR, SLIPPERY FACTOR, CS - 0.82
 4. EARTHQUAKE DESIGN PARAMETERS:
RISK CATEGORY - I
SEISMIC IMPORTANCE FACTOR, Ie - 1.0
MAPPED SPECTRAL RESPONSE ACCELERATION PARAMETERS,
SS -0.374g
S1 -0.152g
SITE CLASS - D
DESIGN SPECTRAL RESPONSE ACCELERATION PARAMETERS,
SDS -0.374g
SD1 -0.222g
SEISMIC DESIGN CATEGORY - D
BASIC SEISMIC FORCE-RESISTING SYSTEM - SOLAR RACKING SYSTEM
DESIGN BASE SHEARS - 0.337 KIP
SEISMIC RESPONSE COEFFICIENT, Cs - 0.187
RESPONSE MODIFICATION COEFFICIENT, R - 2
ANALYSIS PROCEDURE- EQUIVALENT LATERAL FORCE PROCEDURE
 5. FOUNDATION DESIGN PARAMETERS:
FOUNDATION DESIGN DERIVED FROM GEOTECHNICAL REPORT PROVIDED BY REITZ & JENS, INC. DATED JUNE 28, 2017 (REPORT NO: 2017012415)
 6. POST INSTALLATION TOLERANCES AT TOP OF POST:
VERTICAL: +/-1" (SEE NOTE BELOW)
MAX TWIST: +/-2"
EAST/WEST: +/-2.5"
NORTH/SOUTH: +/-1"
MAX OUT OF PLUMB: +/- 1"
- (POST INSTALLATION TOLERANCES ACCOUNT FOR STACKED MANUFACTURING TOLERANCES)

7. GROUND CLEARANCE REQUIREMENTS:
SNOW REMOVAL AT FRONT EDGE OF RACK IS REQUIRED TO MAINTAIN PROPER CLEARANCE FOR SNOW TO SLIDE OFF.
A. MINIMUM GROUND CLEARANCE TO BE HELD AT ALL "CONTROL POSTS".
B. IF GROUND CLEARANCE BETWEEN CONTROL POSTS IS GREATER THAN MINIMUM GROUND CLEARANCE, IT IS ACCEPTABLE.
C. IF GROUND CLEARANCE BETWEEN CONTROL POSTS IS LESS THAN MINIMUM GROUND CLEARANCE, THEN EXCAVATION IS REQUIRED AT LEADING EDGE OF RACK TO ACHIEVE MINIMUM GROUND CLEARANCE.
8. CONNECTIONS:
ALL CONNECTIONS TO BE SNUG TIGHT UNLESS OTHERWISE NOTED. SOME 1/2"-13 ASTM A325T BOLTS MUST BE FASTENED BY TURN OF THE NUT METHOD PER THE RESEARCH COUNCIL OF STRUCTURAL CONNECTIONS (RSCC). ALL MODULE AND RACKING HARDWARE TO BE TORQUED AS SPECIFIED AND MARKED WITH AN INDELIBLE MARKER. SEE SHEET S2-S3 FOR DETAILS.
9. PV MODULE INFORMATION:
NAME/MODEL: GCL-M6/72H 370W
DIMENSIONS: 77.008" LONG X 39.055" WIDE X 1.378" TALL
WEIGHT 48.94 LBS.
10. MATERIALS AND COATING:
A. PILES
I. W-SECTIONS: A992 STEEL HOT DIPPED GALVANIZED PER ASTM A123.
II. COLD FORMED BALLAST CHANNELS - A36 STEEL HOT DIPPED GALVANIZED PER ASTM A123.
III. SMART POST - A653 GRADE 50 STEEL HOT DIPPED GALVANIZED PER ASTM A123.
B. HARDWARE:
I. 1/2"Ø TO BE A325 HOT DIPPED GALVANIZED PER ASTM A153.
II. 3/8"Ø TO BE A449 MECHANICAL GALVANIZED PER MAGNI 560.
III. 5/16"Ø TO BE A449 MECHANICAL GALVANIZED PER MAGNI 560 OR STAINLESS STEEL.
IV. 1/4"Ø TO BE A449 MECHANICAL GALVANIZED PER MAGNI 560 OR STAINLESS STEEL.
C. COLD FORMED STEEL - ALL COLD FORM STEEL TO BE PRE GALVANIZED PER A653 UNLESS OTHERWISE NOTED. SEE S1-S2 FOR THE GRADE OF STEEL FOR EACH MEMBER.

ABBREVIATIONS:

INT	INTERIOR	C-C	CENTER TO CENTER
MIN	MINIMUM	CL	CENTERLINE
MAX	MAXIMUM	CD	CRITICAL DIMENSION
DIA	DIAMETER	DIA	DIAMETER
PLCS	PLACES	DIM	DIMENSION
PAG	POST ABOVE GRADE	EOP	END OF PANEL
REF	REFERENCE	EXT	EXTERIOR
TB	TILT BRACKET	HORIZ	HORIZONTAL
TYP	TYPICAL	HDG	HOT DIPPED GALVANIZED
VERT	VERTICAL		

- RECOMMENDATIONS FOR SETTING POST ELEVATIONS:
- A. FIRST POST OF RACK AND FIRST POST OF NEXT RACK (CONTROL POSTS) SHALL BE PLACED SO THAT THE TOP OF POST IS EQUAL TO THE "POST ABOVE GRADE" DIMENSION. MINIMUM EMBEDMENT DEPTH REQUIRED AT ALL CONTROL POSTS.
 - B. THE CONTROL POST DOESN'T NECESSARILY HAVE TO BE THE 1ST POST WITHIN EACH RACK.
 - C. FOR AREAS WITH TERRAIN CHANGE, CONTROL POINTS CAN BE TAKEN AT THE MID-POINT BETWEEN THE LAST POST OF RACK AND FIRST POST OF THE NEXT RACK. TEMPORARY T-POSTS (INSTALLED PLUMB LEVEL) CAN BE USED FOR THESE CONTROL POINTS.
 - D. A TAUT STRING-LINE SHALL THEN BE PLACED FROM TOP CENTER OF FIRST CONTROL POST TO TOP CENTER OF NEXT CONTROL POST.
 - E. THE MAXIMUM SLOPE OF THE STRING-LINE SHALL BE LESS THAN OR EQUAL TO +/- 20%
 - F. THE REMAINING POSTS TO BE INSTALLED WITHIN +/- 1" FROM STRING LINE.
 - G. EMBEDMENT DEPTH FOR POSTS BETWEEN CONTROL POSTS MUST BE INSTALLED TO WITHIN +/- 6" OF REQUIRED EMBEDMENT DEPTH.

MINIMUM RECOMMENDED CLEARANCE BETWEEN ADJACENT RACKS TO BE NO LESS THAN 6".

DRAWING INDEX: G3L-X RACK

REV	DESCRIPTION	ISSUED	REVISED, BUT NOT ISSUED
S1	4X9 RACK PLAN VIEW, ELEVATIONS, AND NOTES	●	●
S2	TILT BRACKET COMPONENTS, CONNECTIONS & FOUNDATION DETAILS	○	●
S3	CONNECTIONS	○	●
S4	HARDWARE	○	●

ISSUANCE/REVISION	DATE	BY
SIGN-OFF	JAN. 9, 2019	
REV. SIGN-OFF	JAN. 21, 2019	
REV. 2 SIGN-OFF	JAN. 24, 2019	
STAMPED SET	FEB. 1, 2019	

LEGEND:
● ISSUED
○ REVISED, BUT NOT ISSUED

CUSTOMER:
AZIMUTH ENERGY
Ameren Project
St. Louis, MO 63145

DATE: 2/1/2019
DRAWN BY: JS
CHECK BY: DK
JOB #: 8883
PAGE: 50 of 54

COVER SHEET

SOLAR FLEXRACK
A Division of Northern States Metals
3207 Innovation Place
Youngstown, OH 44509-4023
Phone (888) 380-8138

Copying in part or as a whole is prohibited. This is only to be used for the information of Northern States Metals Company (NSM). © Copyright, Northern States Metals, Co. All Rights Reserved.

REV	DESCRIPTION	DATE



AZIMUTH ENERGY

Ameren Project
St. Louis, MO 63145





SHEET #	8883	PAGE	S1 of S4
DATE	2/1/2019	CHECK BY	DK
DRAWN BY	JS		

GCL-M6/72H 370W MODULE
4X9 SOLAR FLEXRACK G3L-X



3207 Innovation Place
Youngstown, OH 44509-4023
Phone (888) 380-8138

REV	DESCRIPTION	CHK. BY	DATE

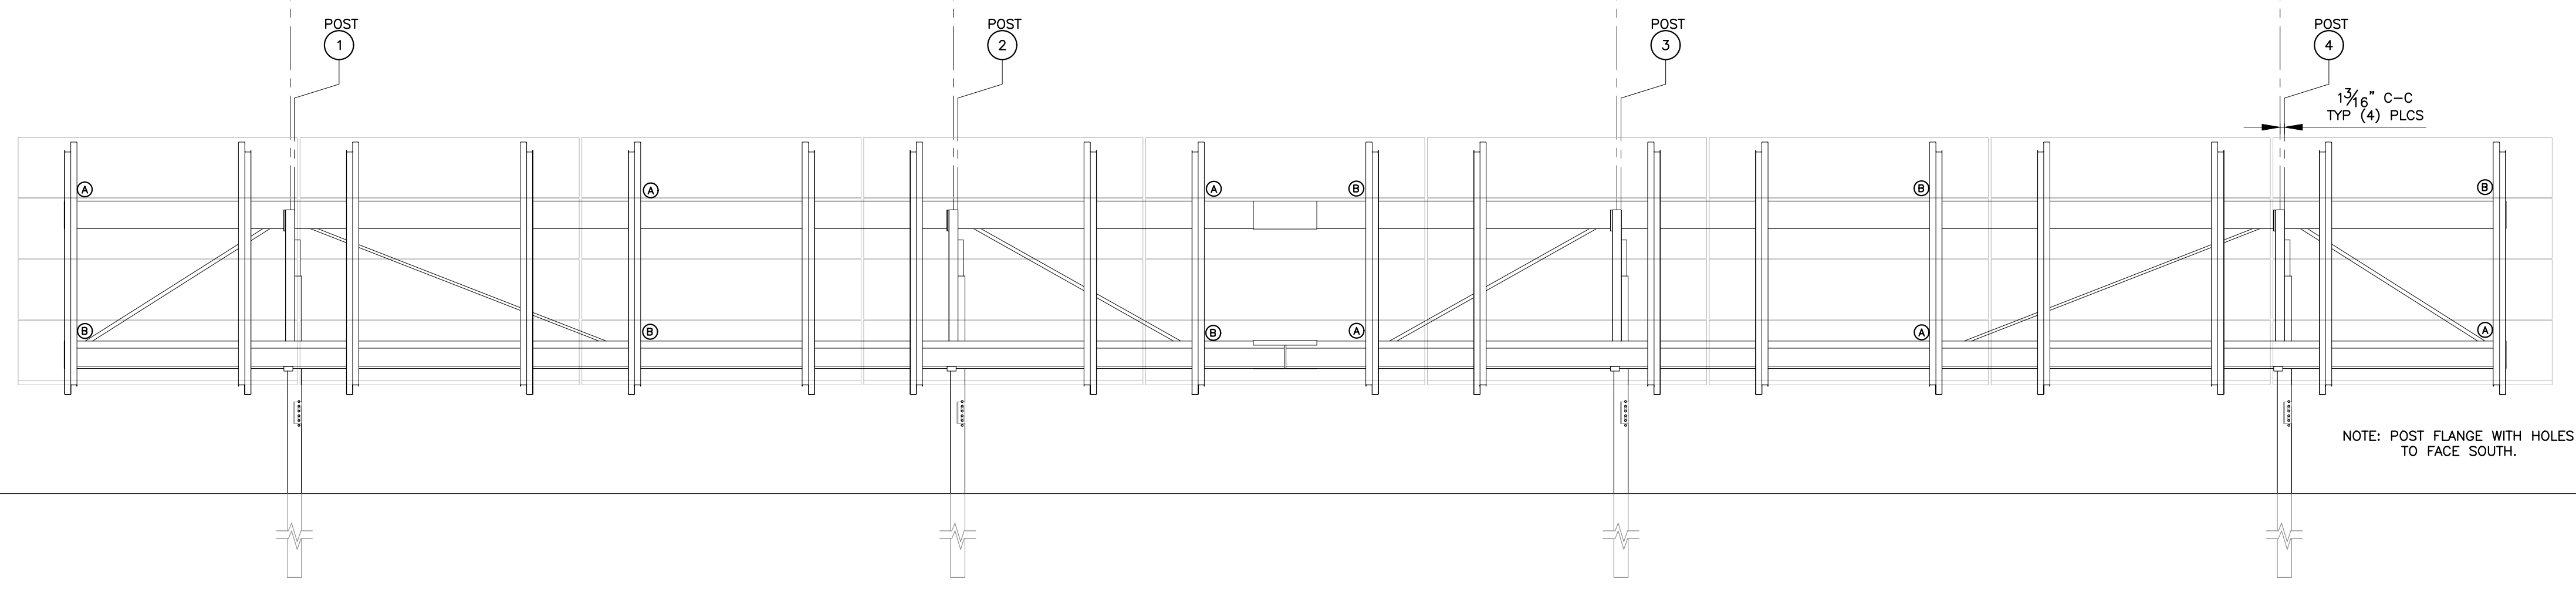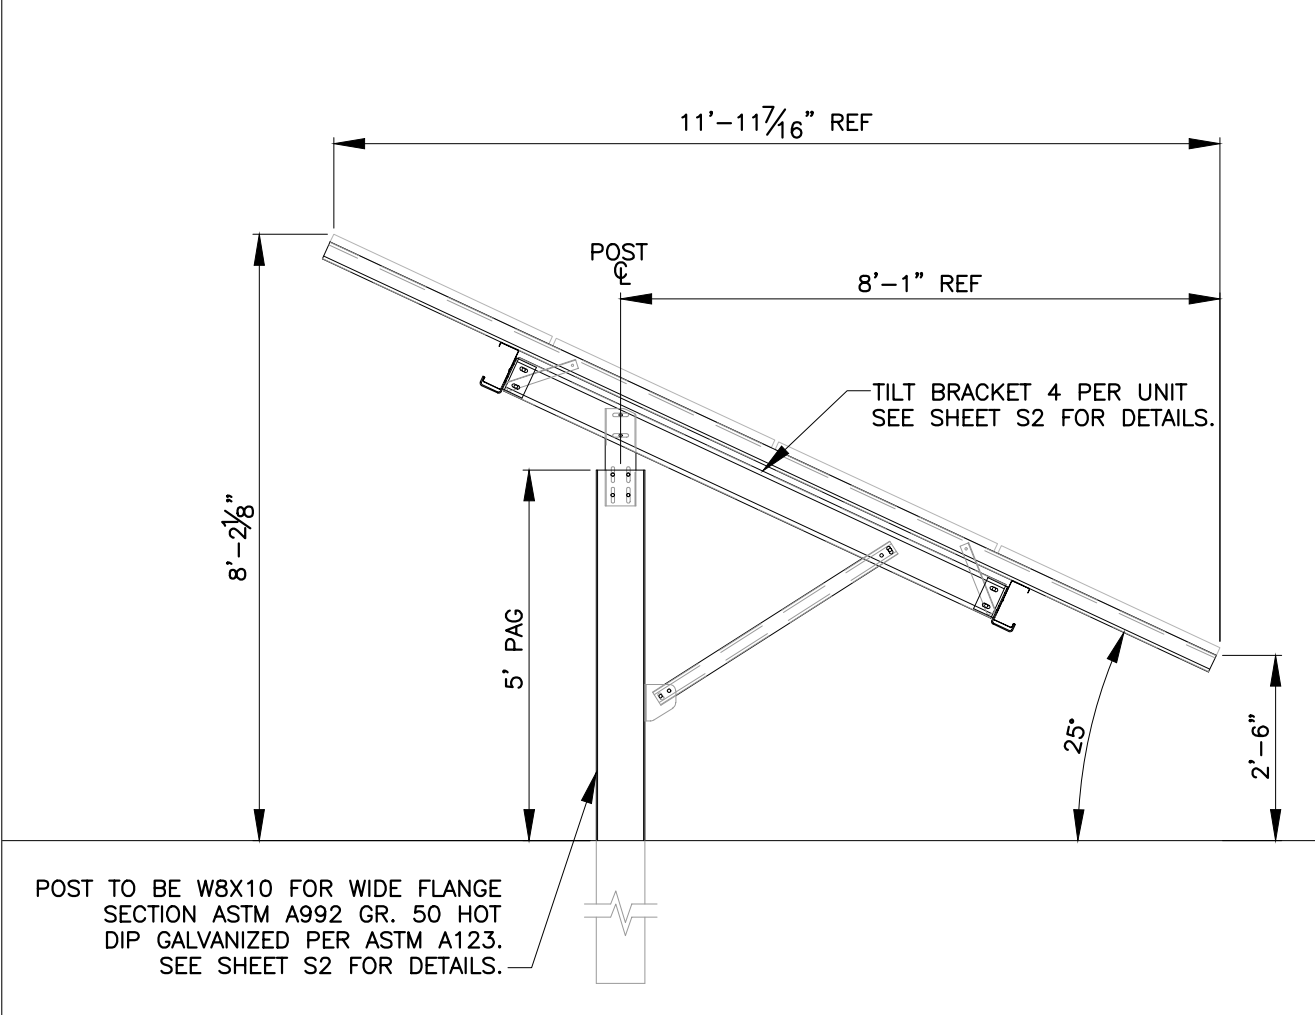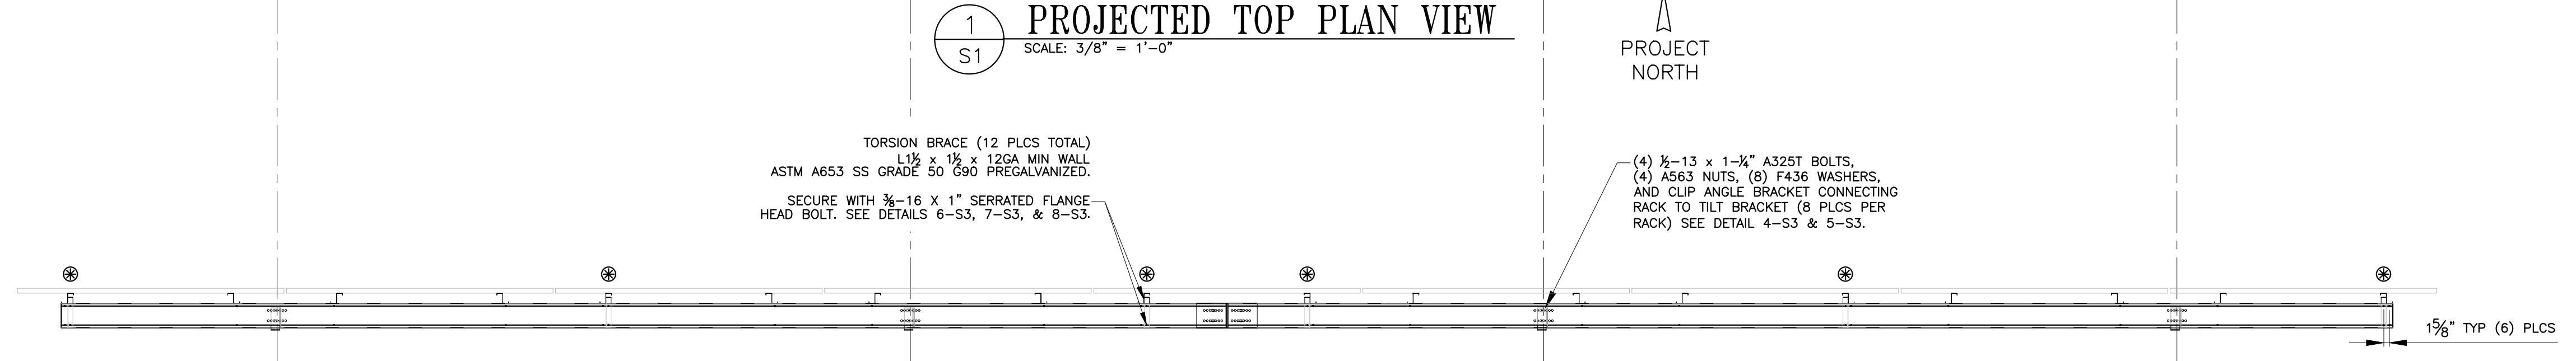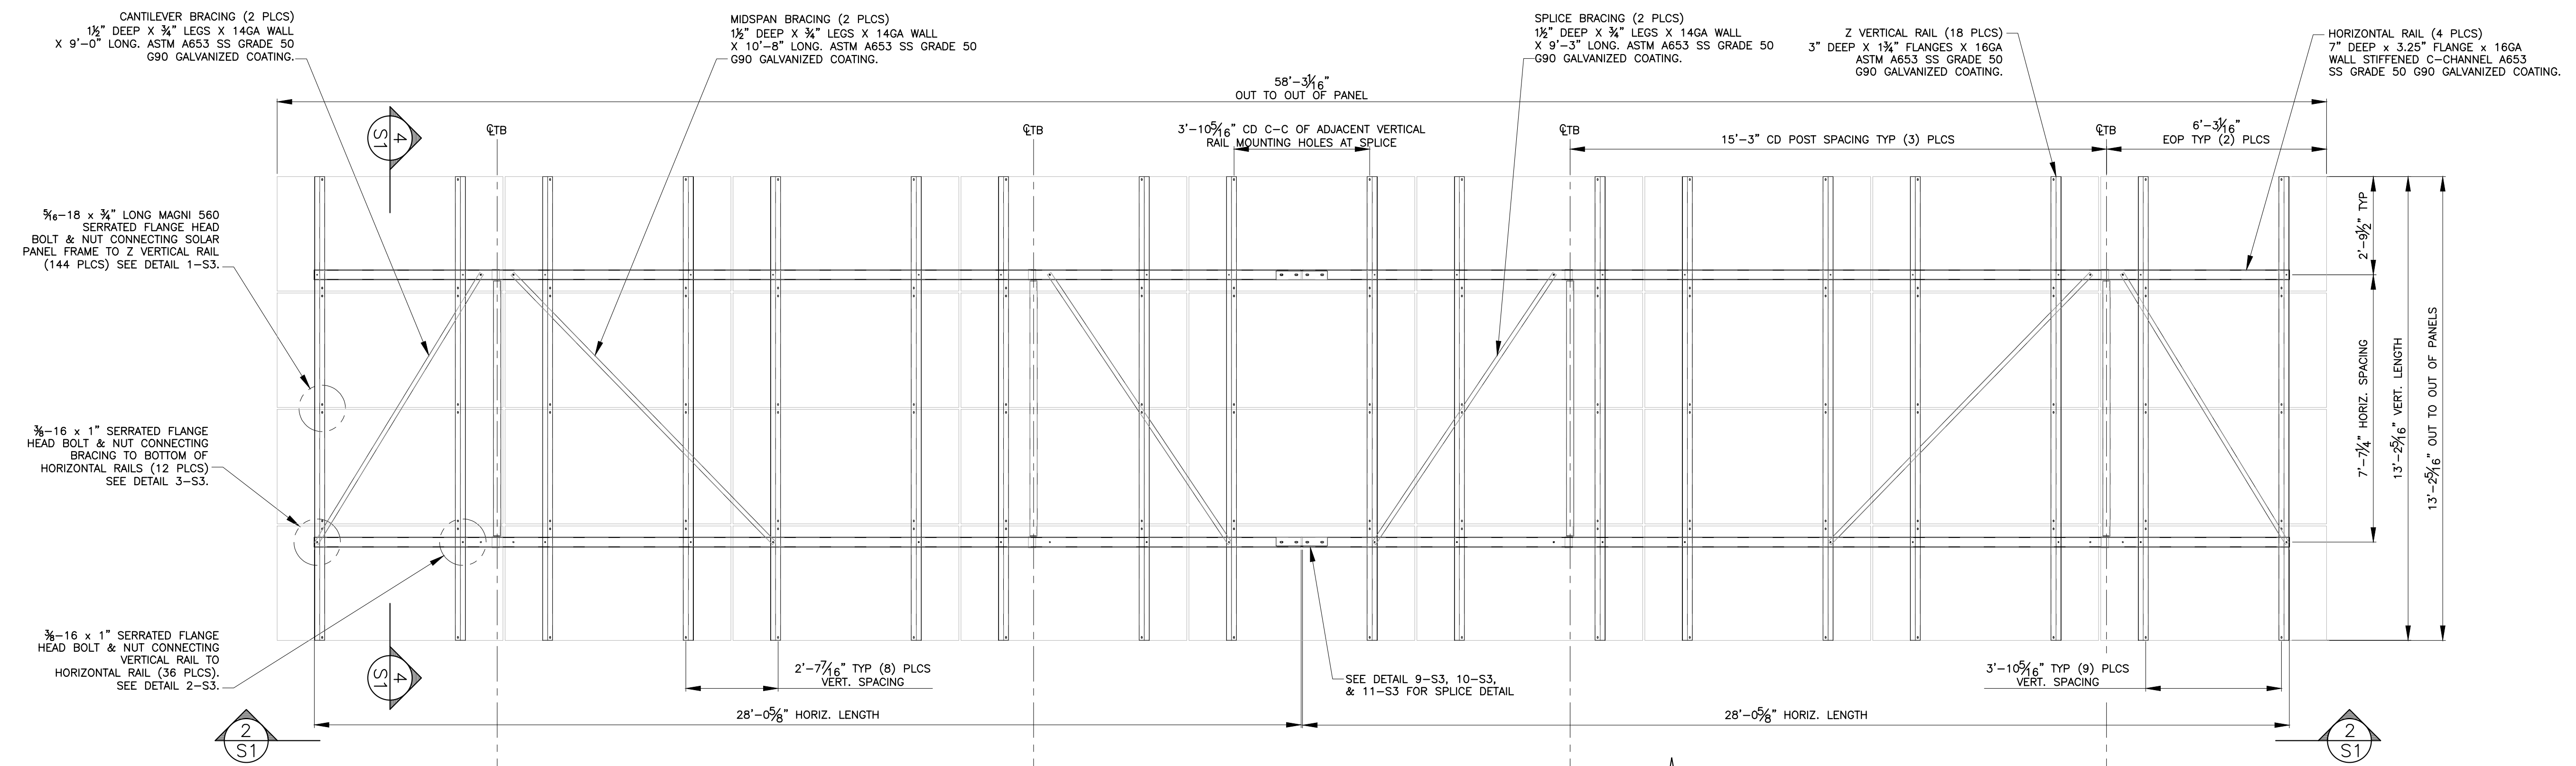

POST TO BE W8X10 FOR WIDE FLANGE SECTION ASTM A992, GR. 50 HOT DIP GALVANIZED PER ASTM A123. SEE SHEET S2 FOR DETAILS.

NOTE: POST FLANGE WITH HOLES TO FACE SOUTH.



4 S1 SCALE: 3/8" = 1'-0"

3 S1 SCALE: 3/8" = 1'-0"


Copying in part or as a whole is prohibited. This is only to be used by the party described in the "Title" section. This is proprietary information of Northern States Metals Company ("NSM"). © Copyright, Northern States Metals, Co. All Rights Reserved.

ITEM	DESCRIPTION	MATERIAL	QTY
1	TOP CHORD 6 DEEP x 2.5 LEG x 14GA THK C	ASTM A653 SS GRADE 50 G90	1
2	FRONT BRACE 2.5 DEEP x 1.75 LEG x 14GA THK C	ASTM A653 SS GRADE 50 G90	
3	LOWER HORIZ. RAIL BRACKET 6.457 x 3.68 x 0.188 THK	ASTM A36 HOT-DIP GALVANIZED	
4	UPPER HORIZ. RAIL BRACKET 6.457 x 3.68 x 0.188 THK	ASTM A36 HOT-DIP GALVANIZED	
5	LOWER BRACKET 5 x 2.5 x 0.18 BENT PLATE	ASTM A36 HOT-DIP GALVANIZED	1
6	TOP POST BRACKET 5 x 1.5 x 0.188 BENT PLATE	ASTM A36 HOT-DIP GALVANIZED	1
7	WBX10	ASTM A992 GR. 50 HOT-DIP GALVANIZED	1


* ALL QUANTITIES ABOVE ARE FOR ONE (1) TILT BRACKET ASSEMBLY
 * (1) TILT BRACKET ASSEMBLY PER POST
 * SEE 2-S2 THRU 5-S2 FOR ALL TILT BRACKET CONNECTION DETAILS.
 * ADDITIONAL TOP BRACKET LENGTHS ARE AVAILABLE IN 4" AND 8" OVER STANDARD LENGTH SIZES. USE VARYING TOP BRACKET SIZES AND HEIGHT SLOTS TO MAINTAIN MODULE SEPARATION BETWEEN ADJACENT RACKS TO GREATER THAN 2" DIFFERENCE.

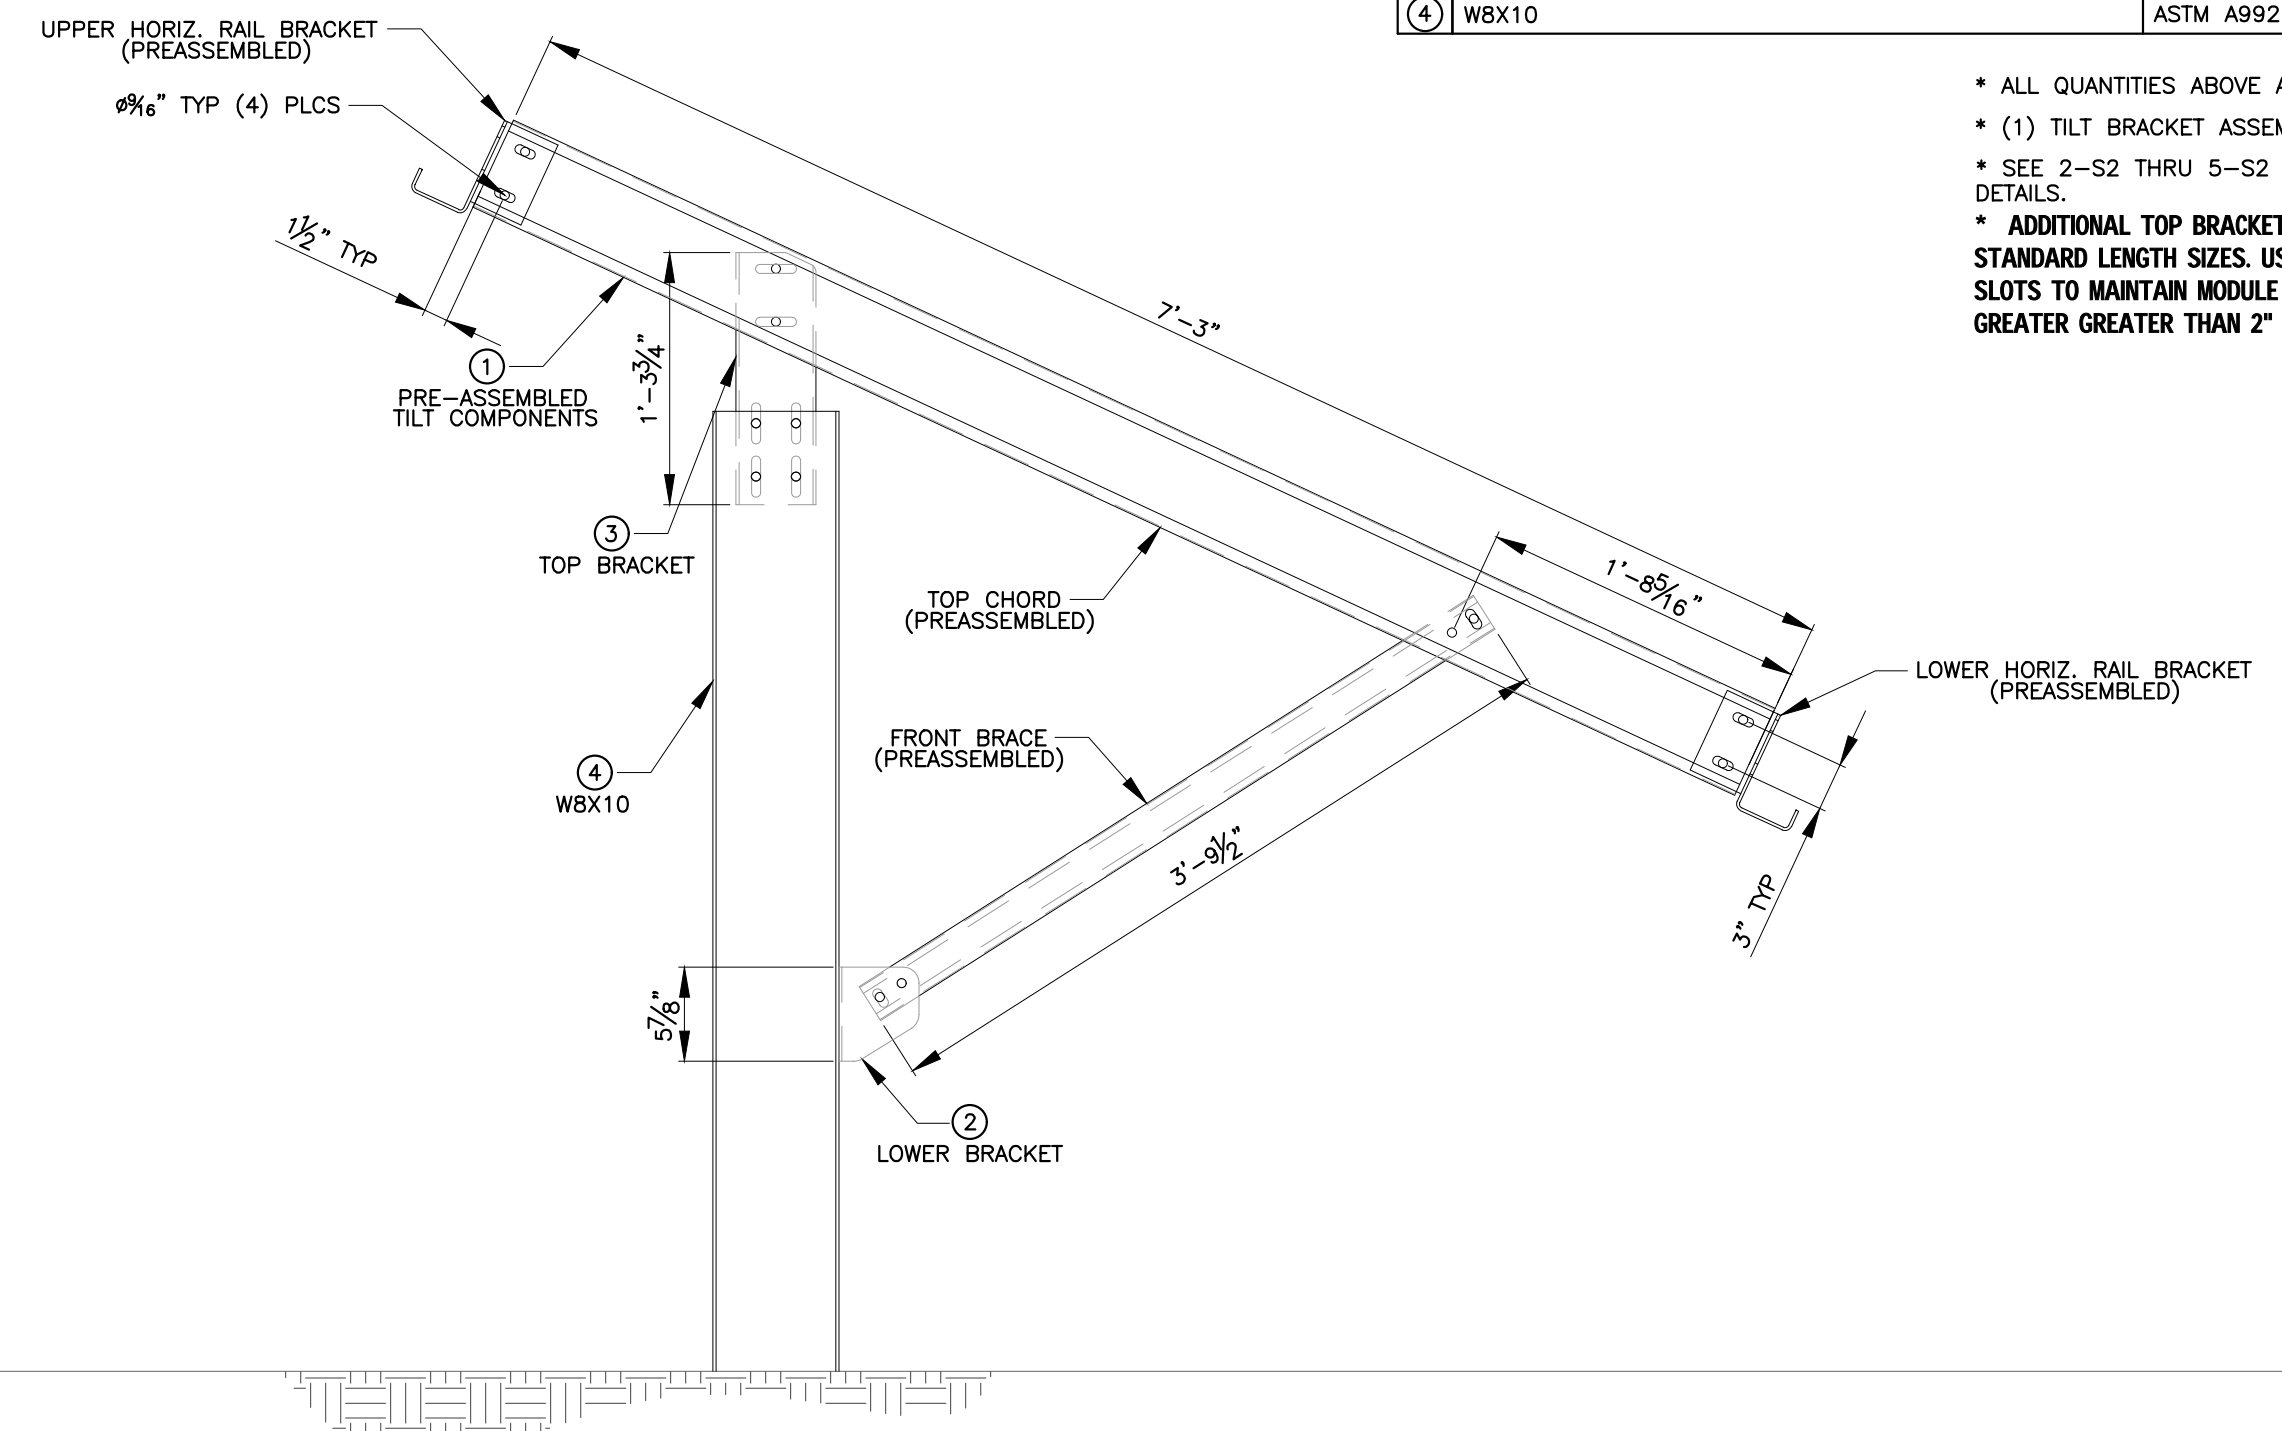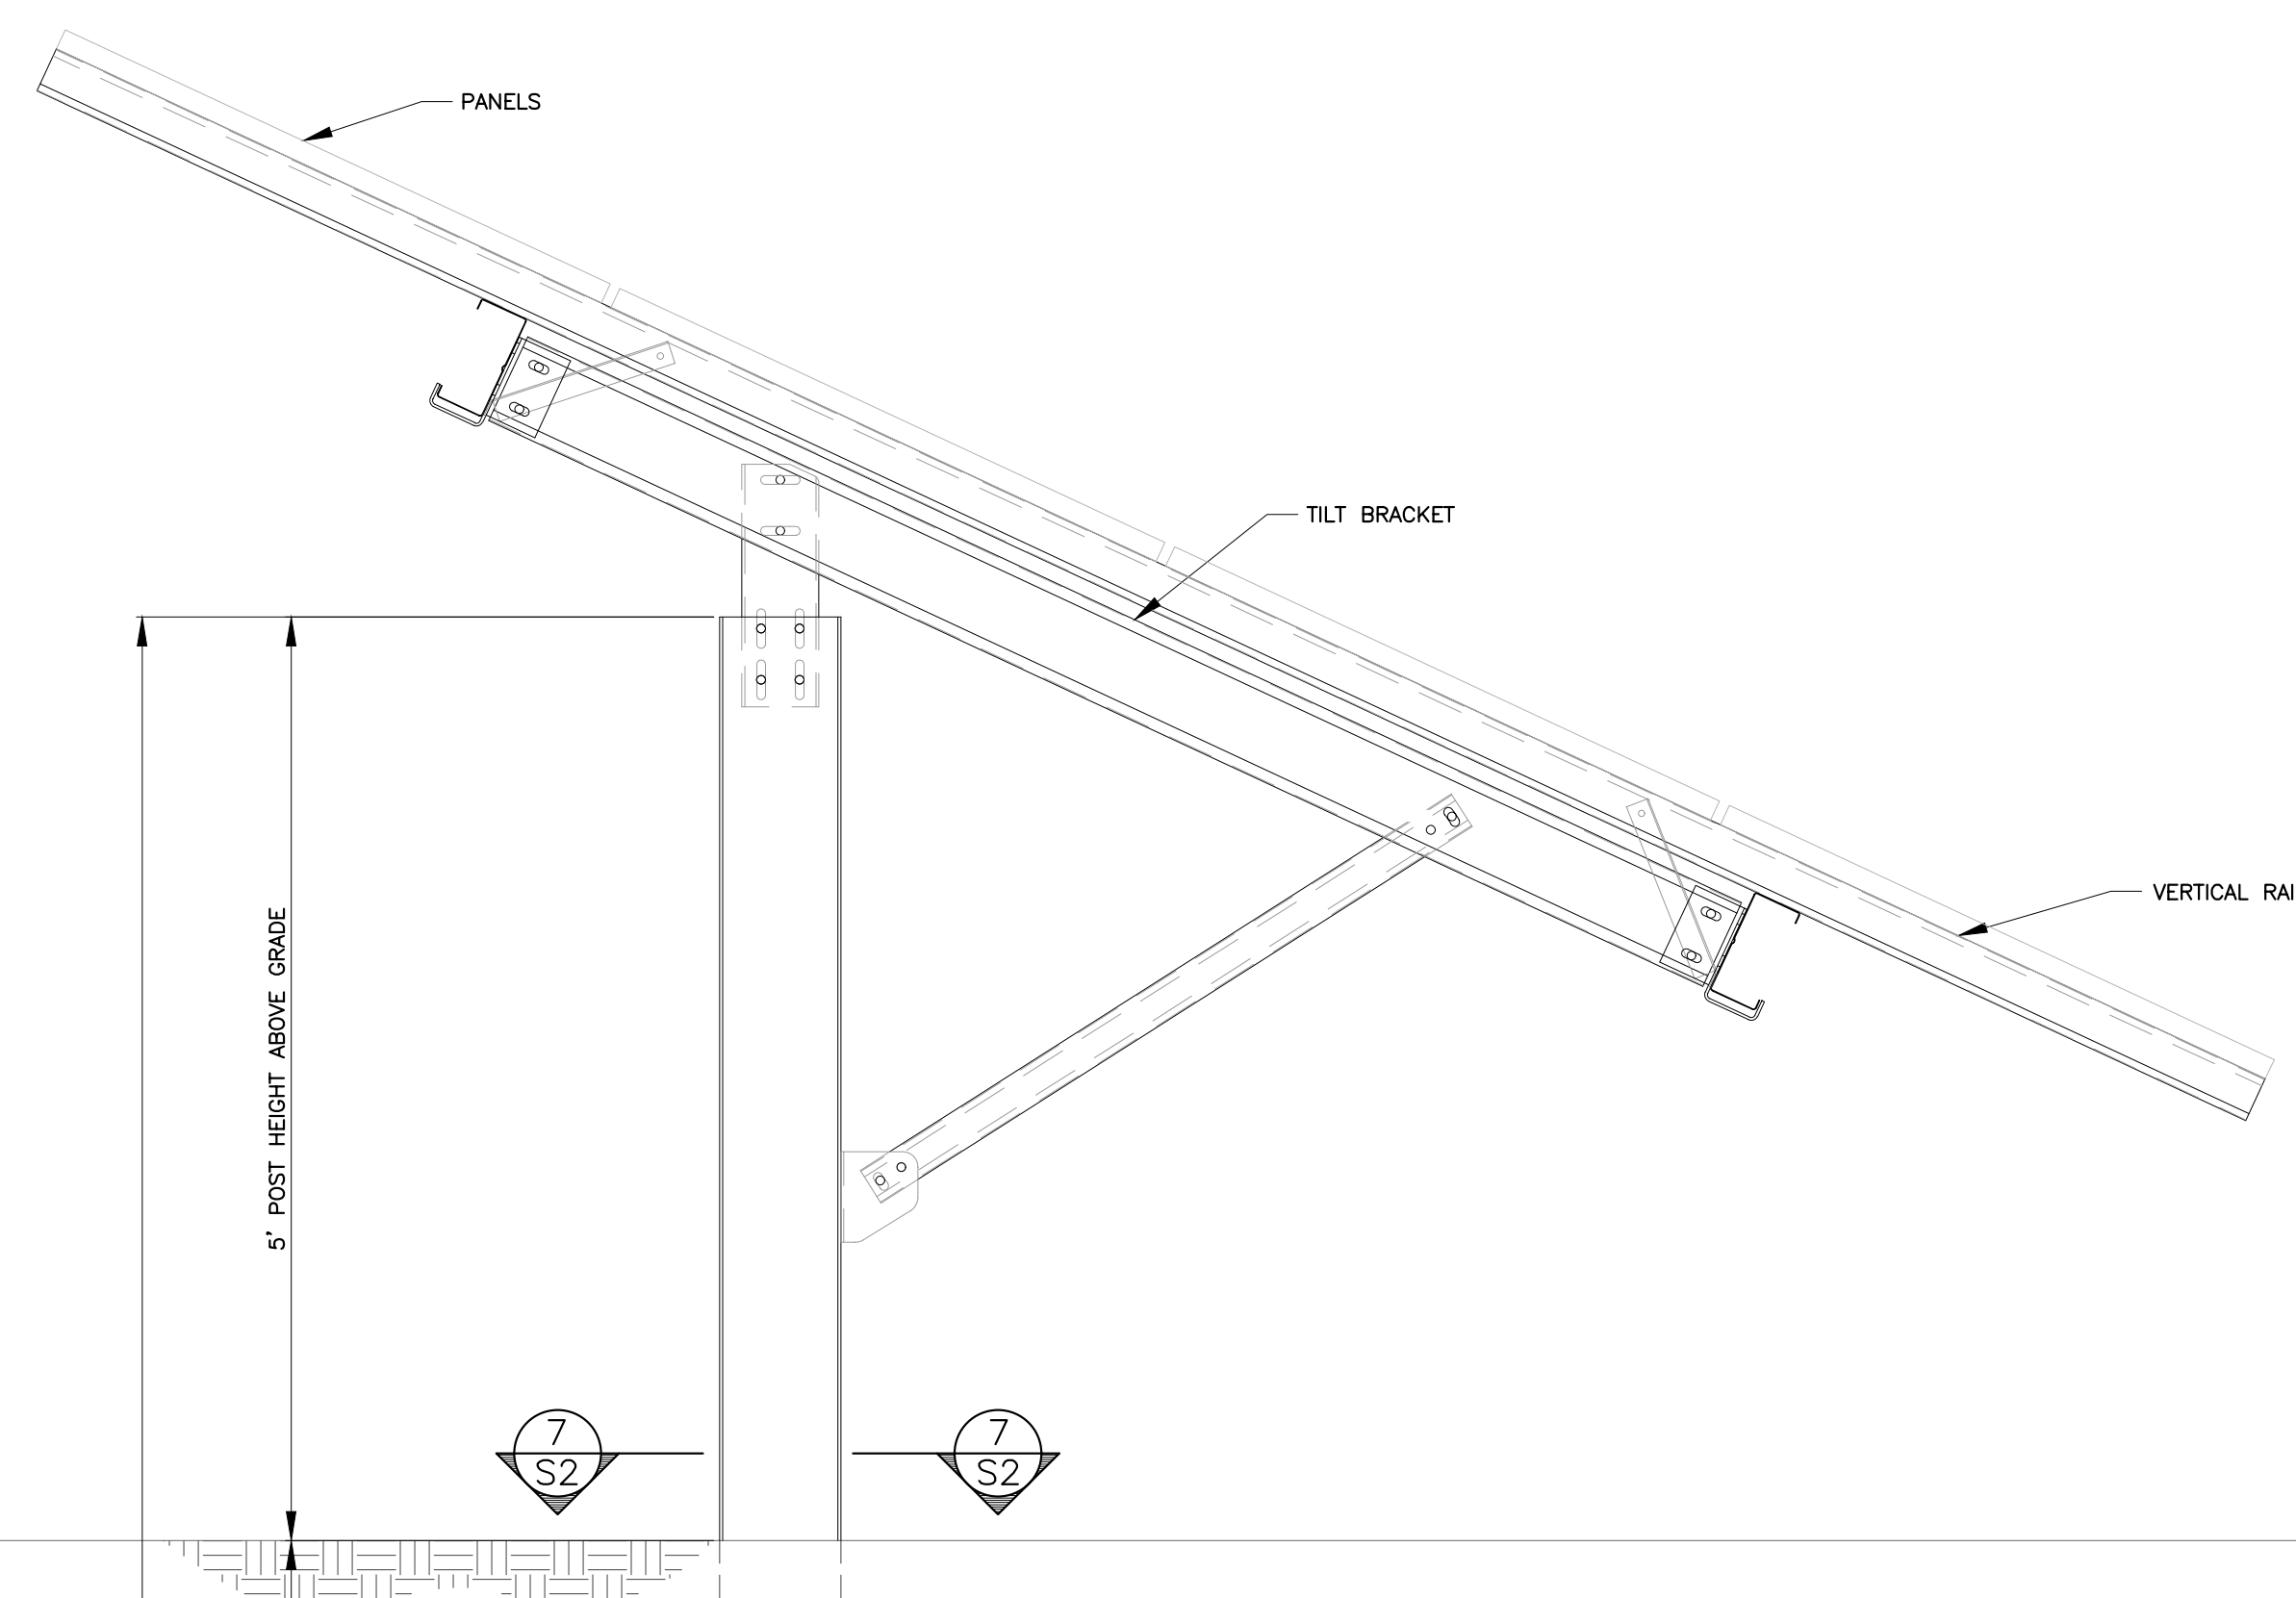


1 TILT BRACKET SIDE ELEVATION
 SCALE: 1" = 1'-0"

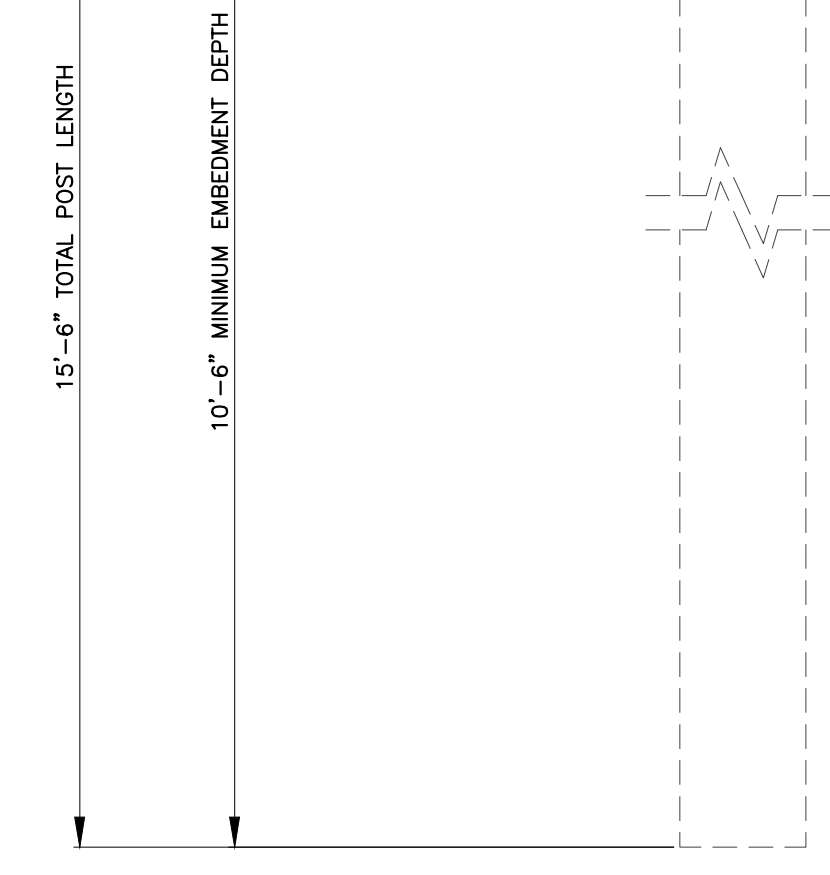


6 FOUNDATION DETAIL
 SCALE: 1" = 1'-0"

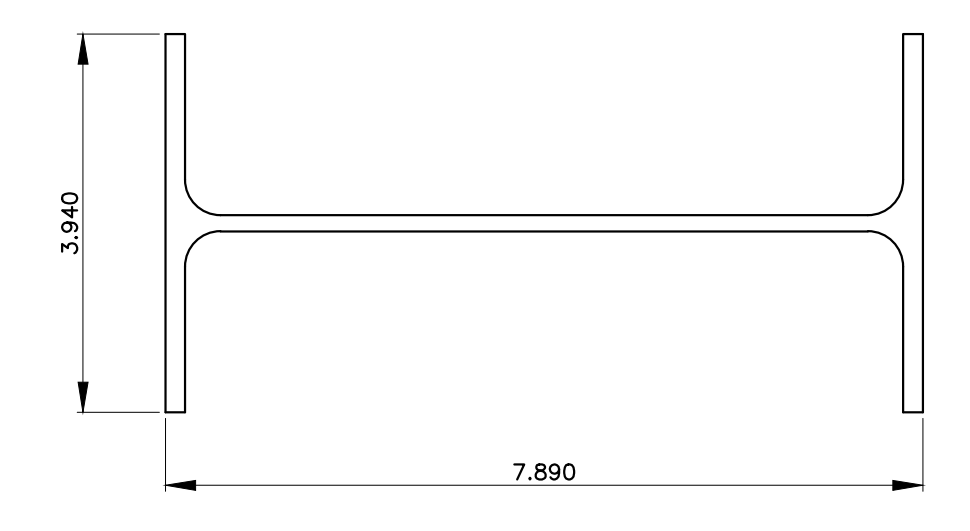


7 WBX10 CROSS SECTION
 SCALE: 8" = 1'-0"

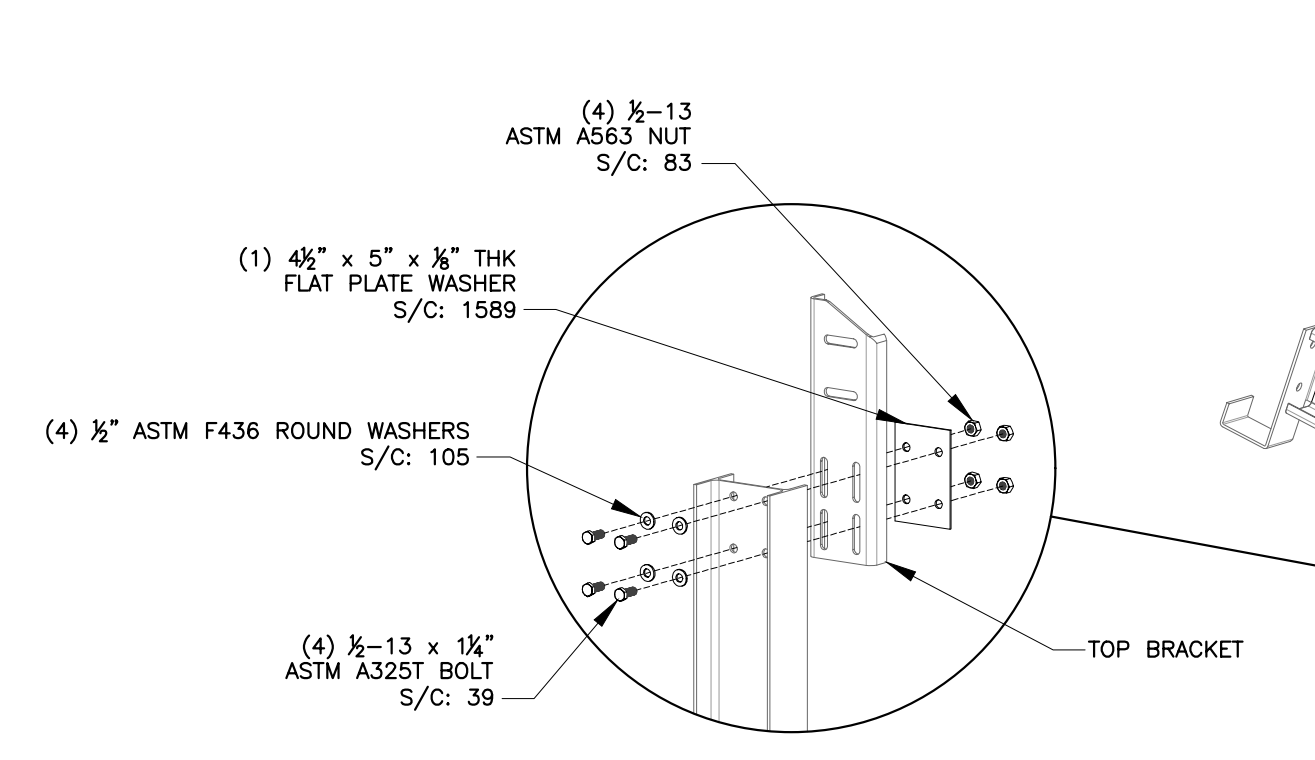


4 POST TO TOP BRACKET CONNECTION
 SCALE: NTS
 1/2"-13 ASTM A325T BOLTS CONNECTING TOP BRACKET TO POST SHALL BE FASTENED BY TURN OF THE NUT METHOD. (3/4) TURN PAST SNUG TIGHT)

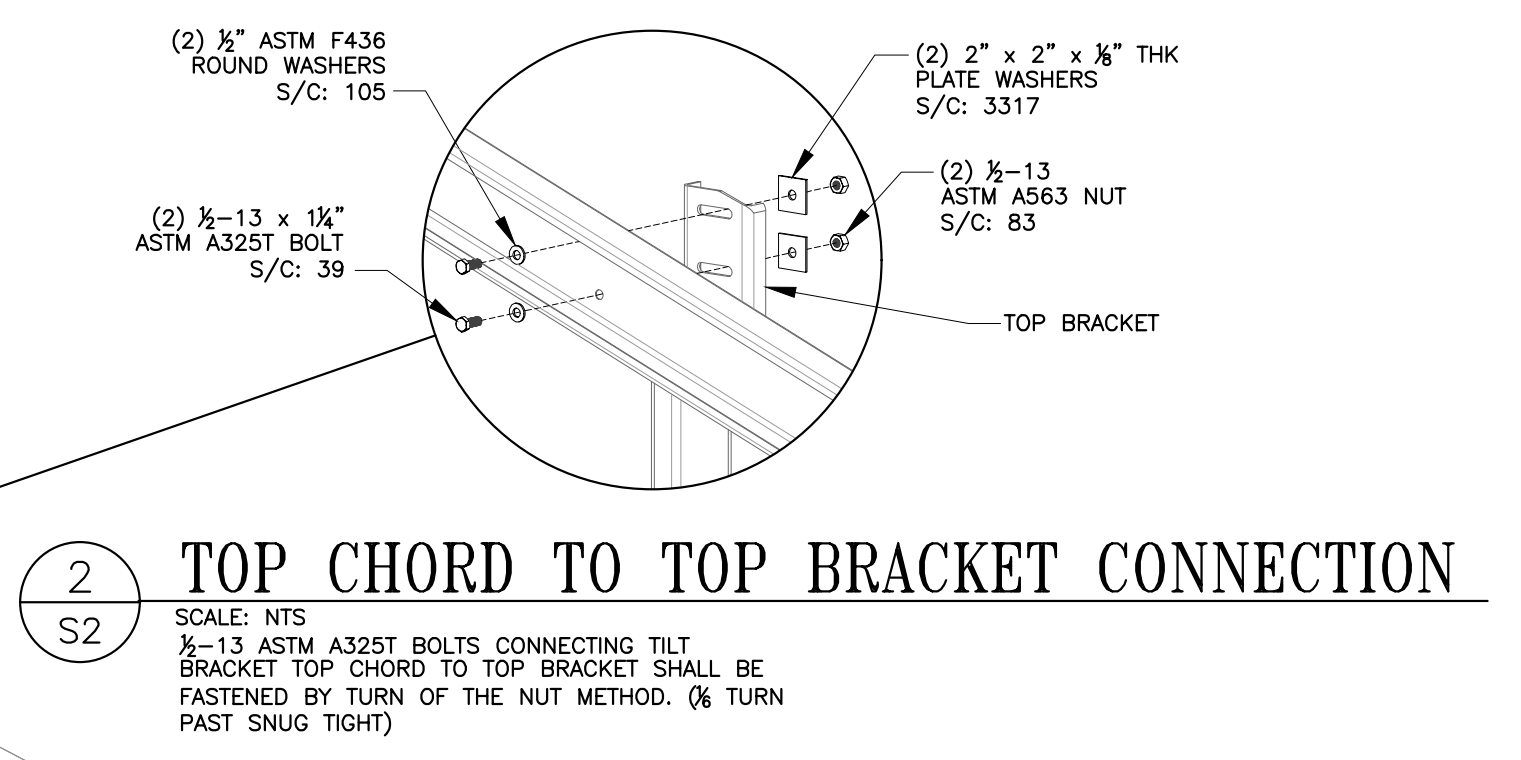

2 TOP CHORD TO TOP BRACKET CONNECTION
 SCALE: NTS

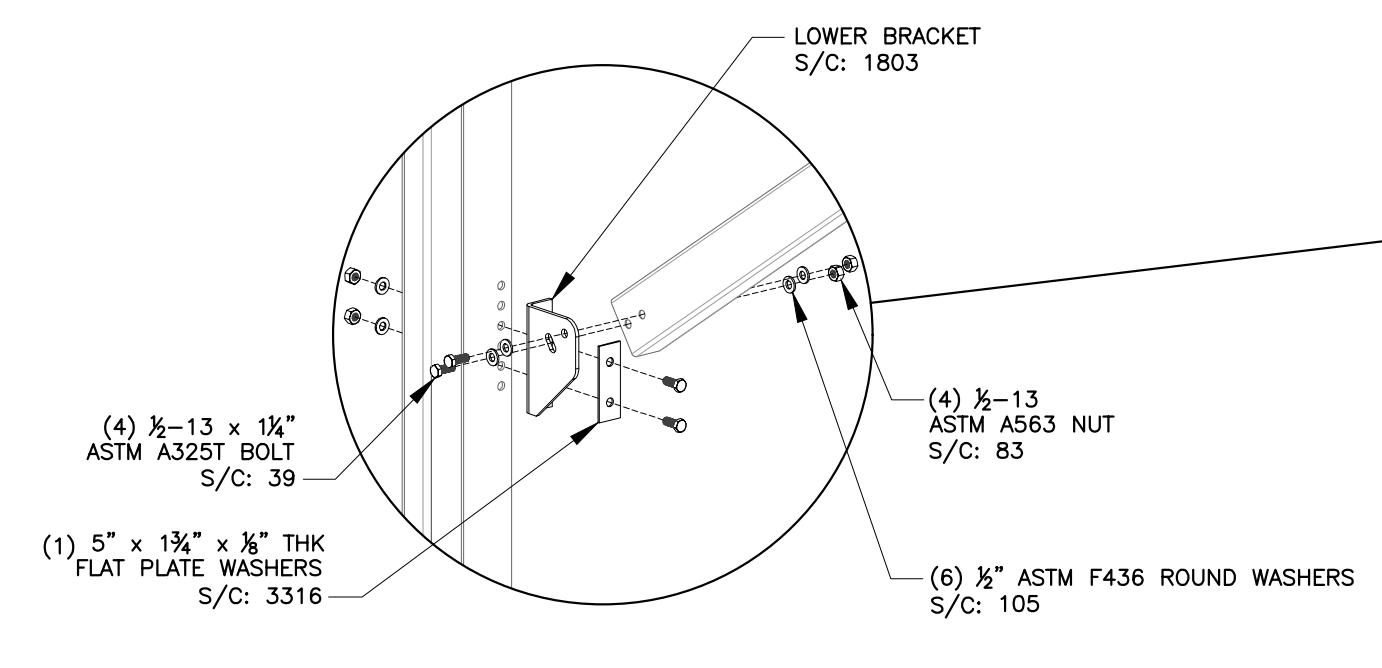

5 BRACE TO LOWER BRACKET CONNECTION
 SCALE: NTS
 1/2"-13 ASTM A325T BOLTS CONNECTING LOWER BRACKET TO POST SHALL BE FASTENED BY TURN OF THE NUT METHOD. (3/4) TURN PAST SNUG TIGHT)

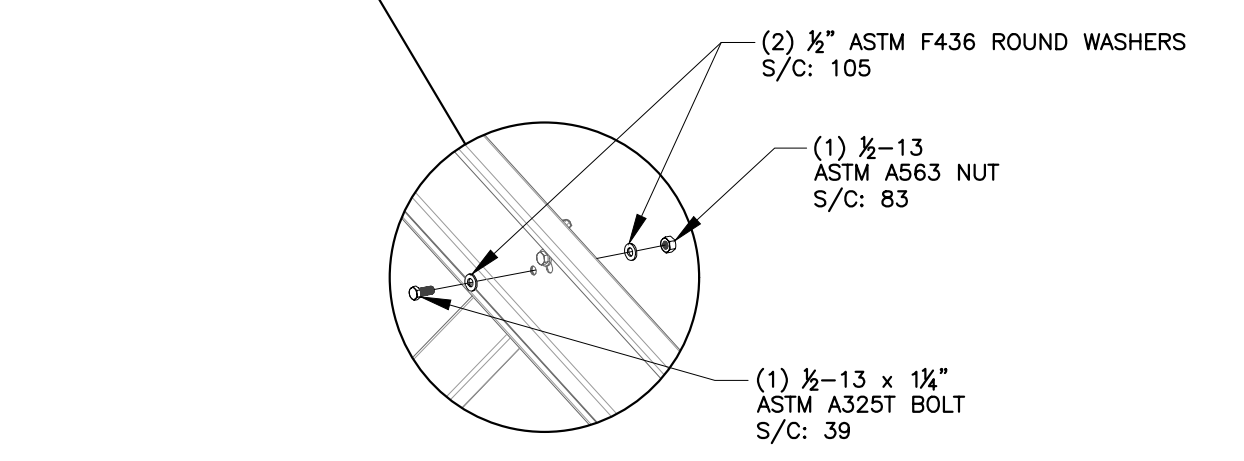

3 TOP CHORD TO BRACE CONNECTION
 SCALE: NTS


* TOP CHORD, FRONT BRACE, AND SEAT BRACKETS WILL BE DELIVERED PREINSTALLED AND FOLDED.
 * BOLTS THAT HAVE BEEN PREINSTALLED WILL HAVE SILICONE ON THEM FOR TRANSPORTING PURPOSES, BOLTS WILL HAVE TO BE TIGHTENED.

CUSTOMER: AZIMUTH ENERGY
 Ameren Project
 St. Louis, MO 63145


TILT BRACKET COMPONENTS,
 CONNECTIONS & FOUNDATION DETAILS

SOLAR FLEX RACK
 A Division of Northern States Metals
 3207 Innovation Place
 Youngstown, OH 44509-4023
 Phone (888) 380-8138


Copying in part or as a whole is prohibited. This is only to be used by the party described in the "Title" section. This is proprietary information of Northern States Metals Company ("NSM"). © Copyright, Northern States Metals, Co. All Rights Reserved.

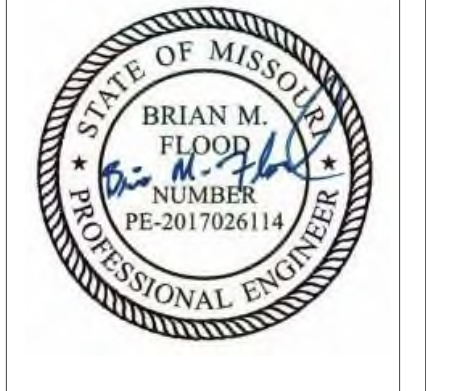


DATE	2/1/2019	JOB #	8883
DRAWN BY	JS	CHECK BY	DK
PAZ	S2	of	S4

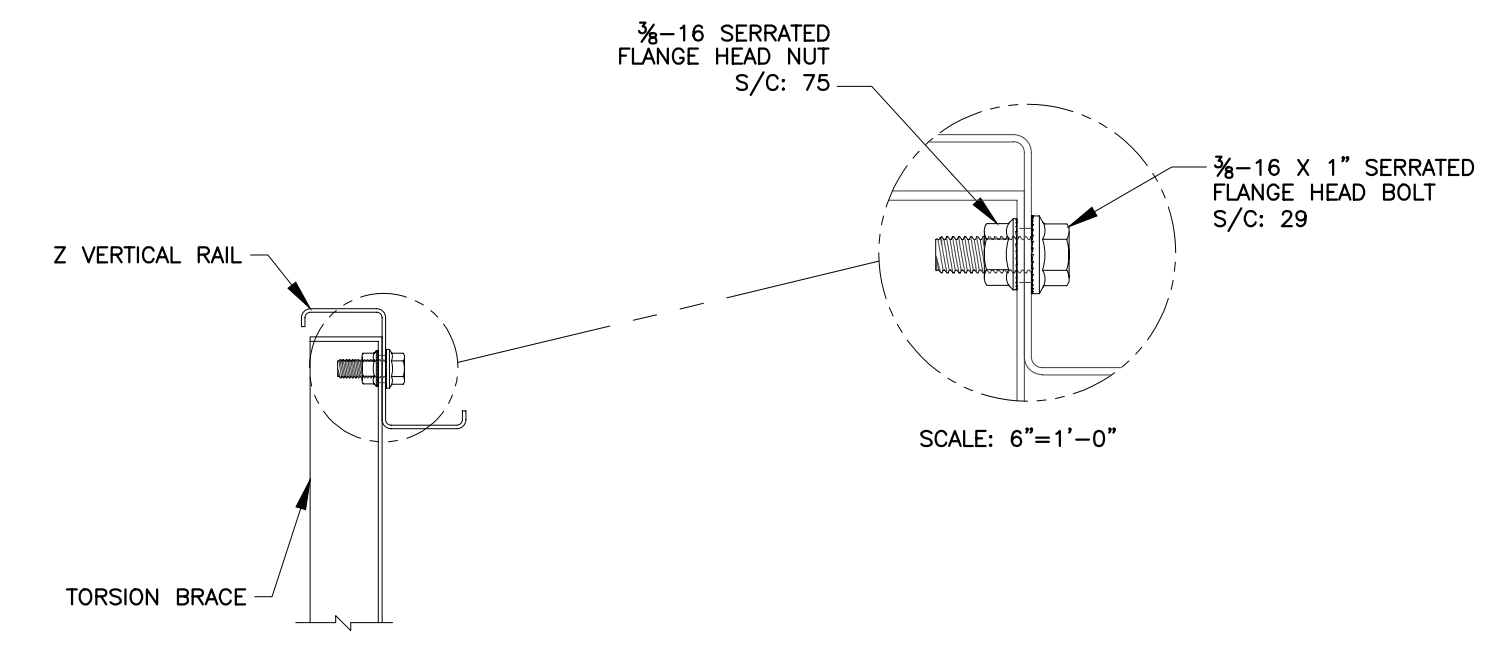

6 VERTICAL RAIL TO TORSION BRACE
SCALE: 3" = 1'-0"

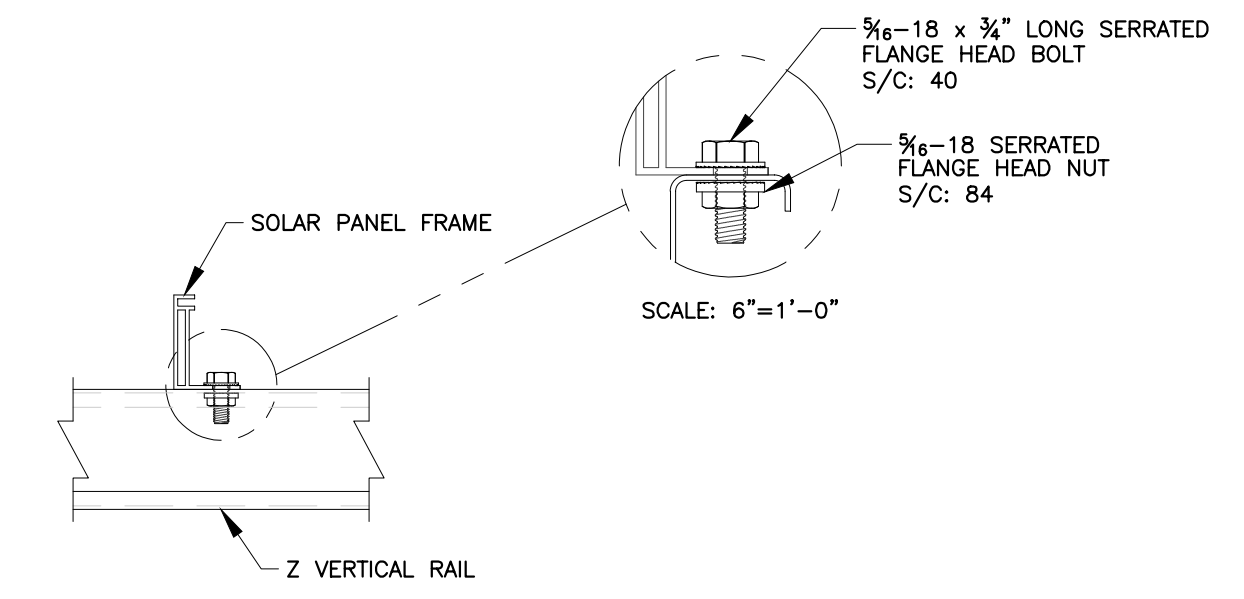


1 SOLAR PANEL TO VERTICAL CONN.
SCALE: 3" = 1'-0"
TORQUE: 8-14 FT-lbs

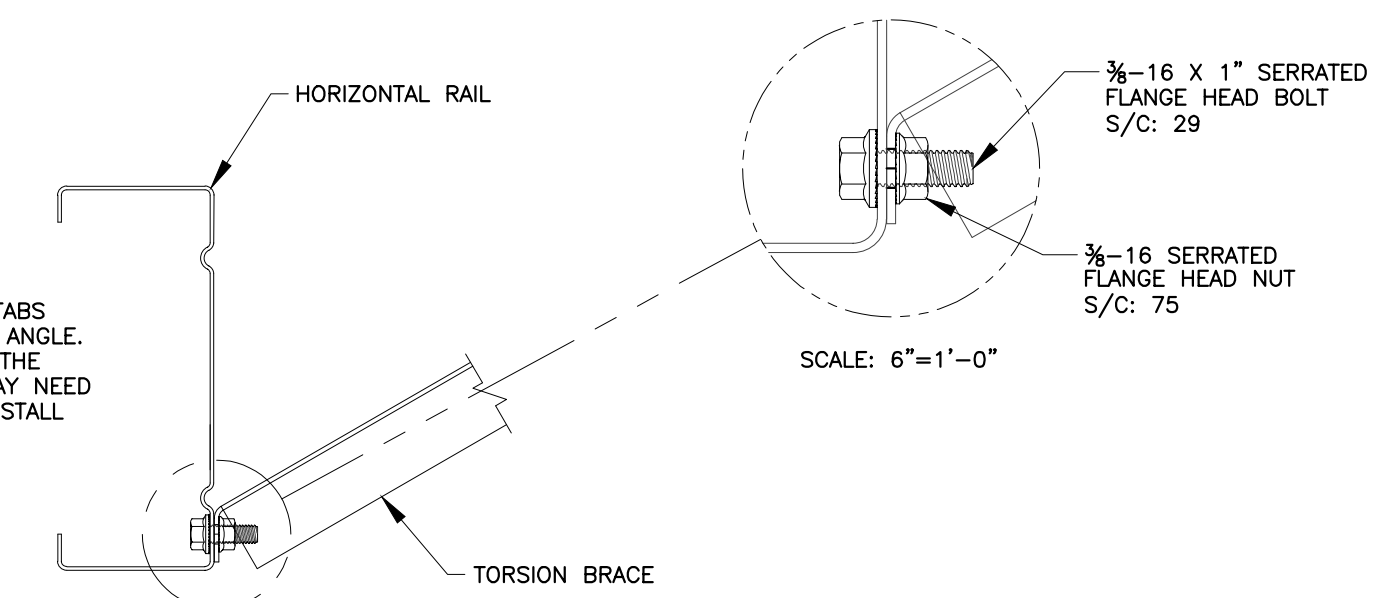


7 HORIZ. RAIL TO TORSION BRACE
SCALE: 3" = 1'-0"


*NOTE: TORSION BRACE BENT TABS ARE PRE-BENT TO A NOMINAL ANGLE TO ALIGN WITH THE HOLES IN THE VERTICAL RAILS, INSTALLERS MAY NEED TO BEND TABS FURTHER TO INSTALL HARDWARE.

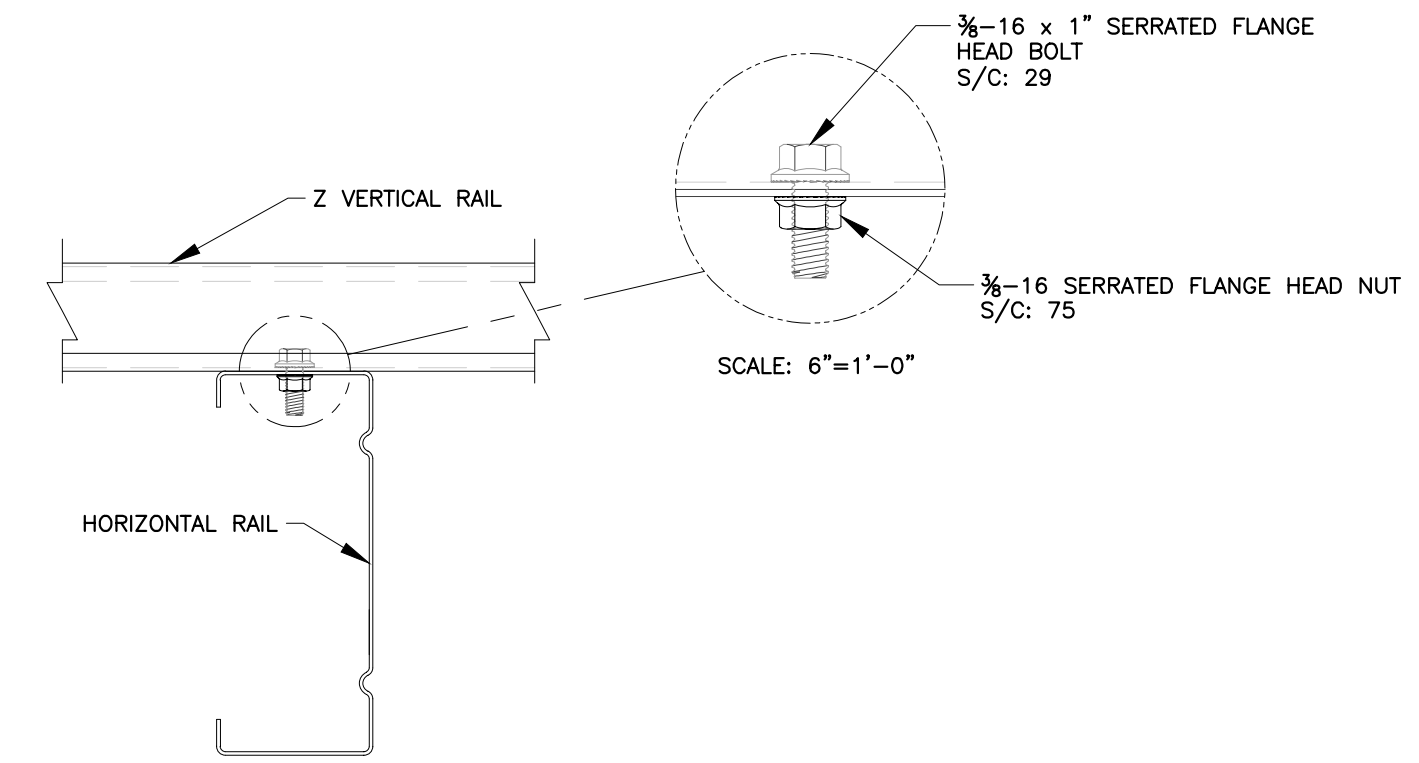


2 Z PURLIN TO HORIZ. RAIL CONN.
SCALE: 3" = 1'-0"

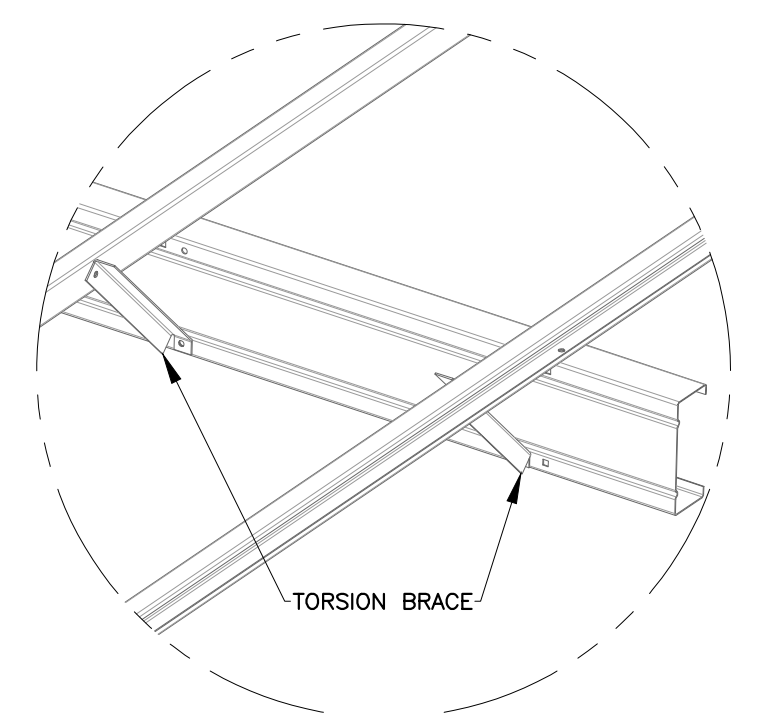


8 TORSION BRACE CONNECTIONS ISO VIEW
SCALE: NTS

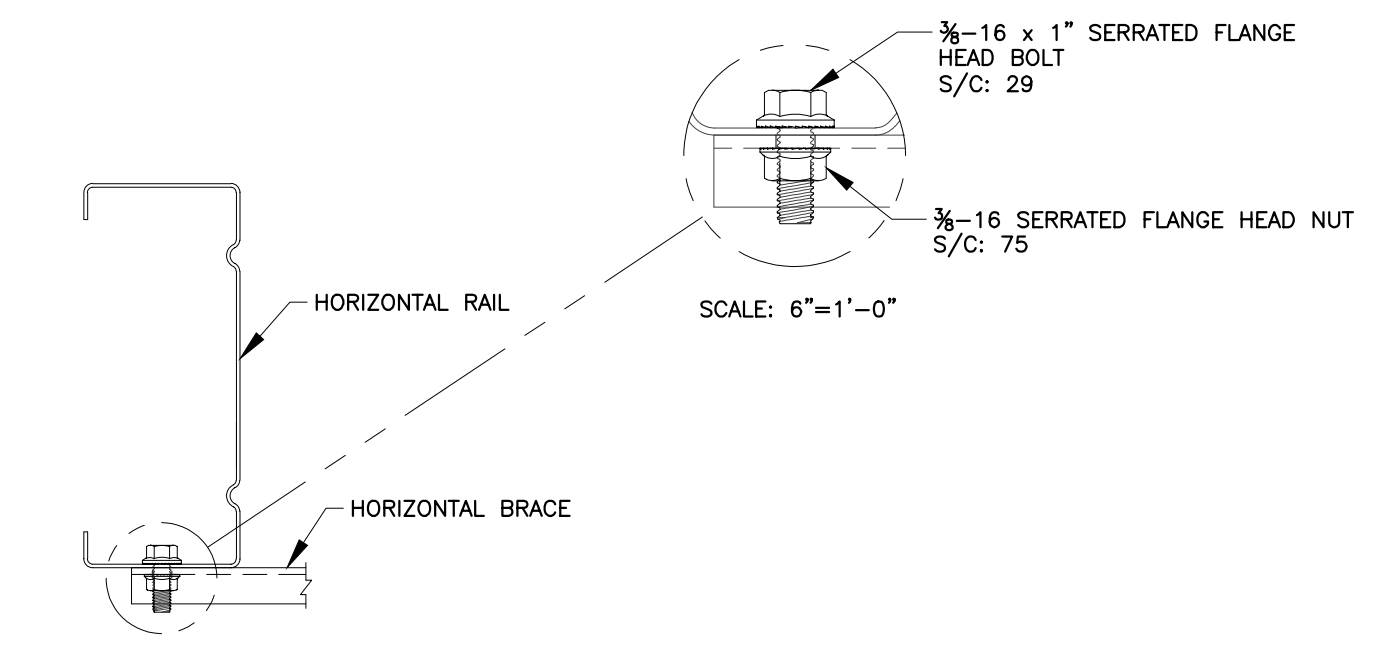


3 HORIZ. RAIL TO HORIZ. BRACING CONN.
SCALE: 3" = 1'-0"

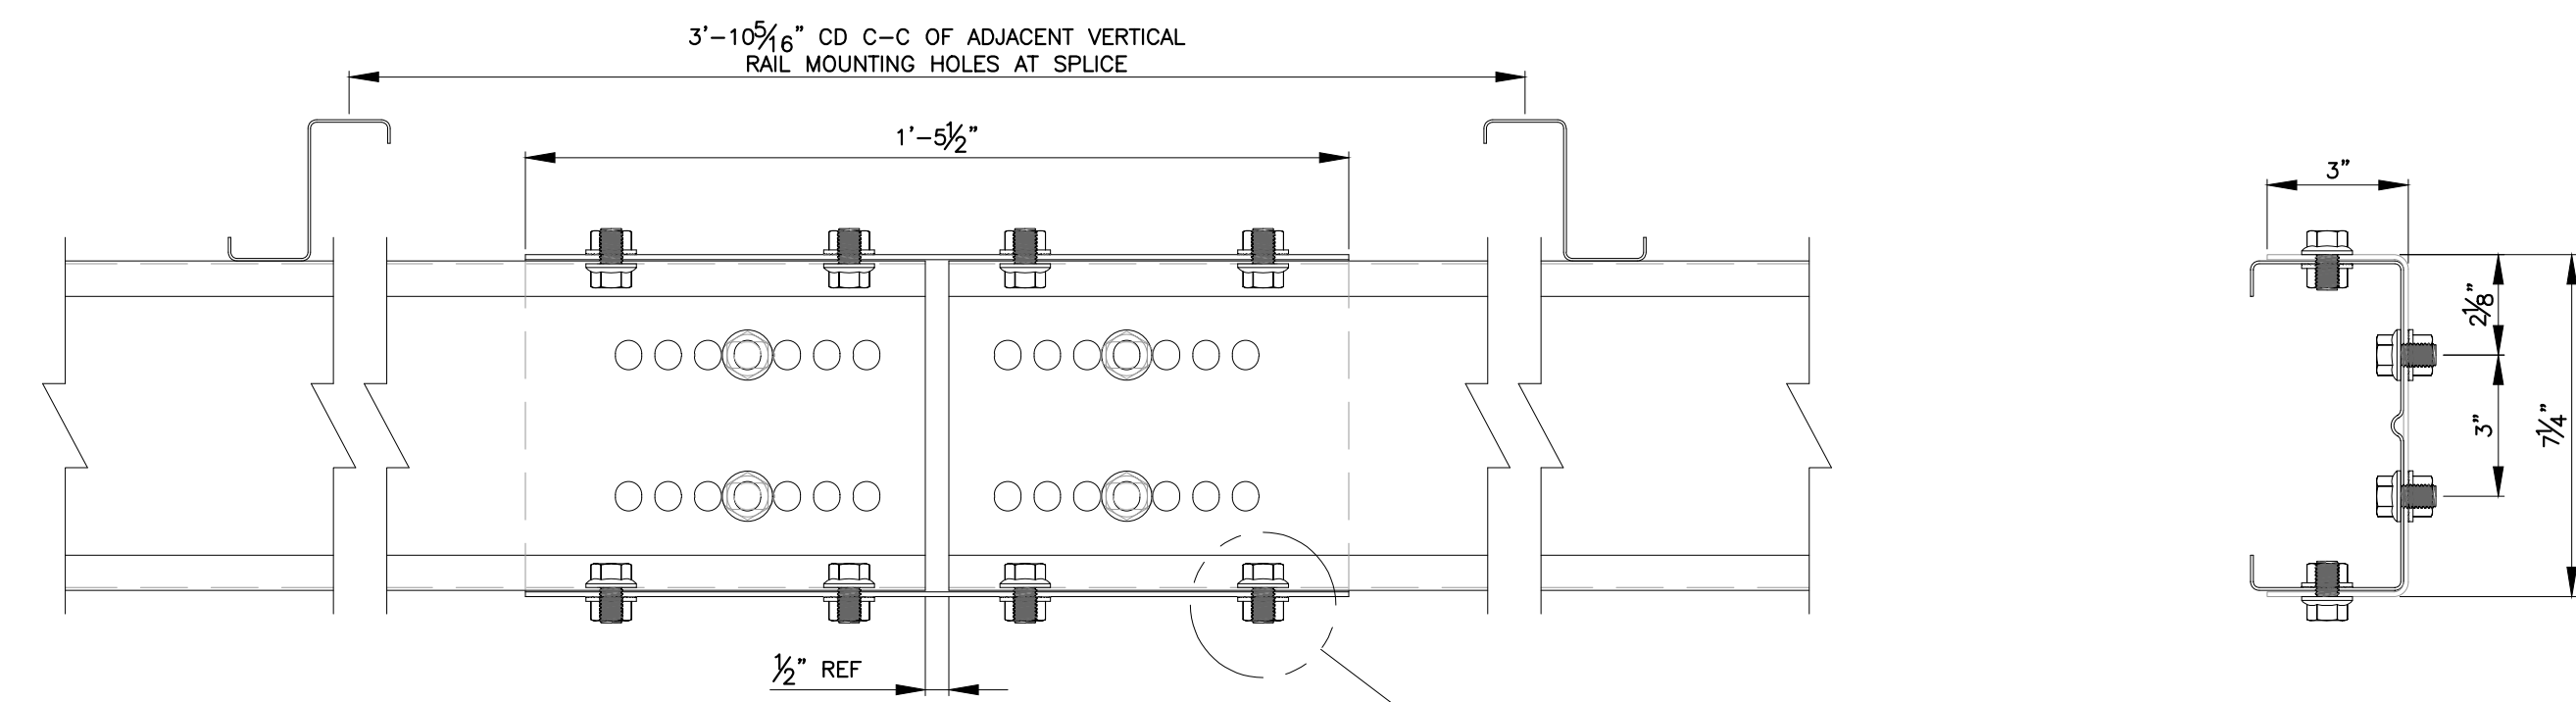


9 SPLICE PROFILE
SCALE: 3" = 1'-0"

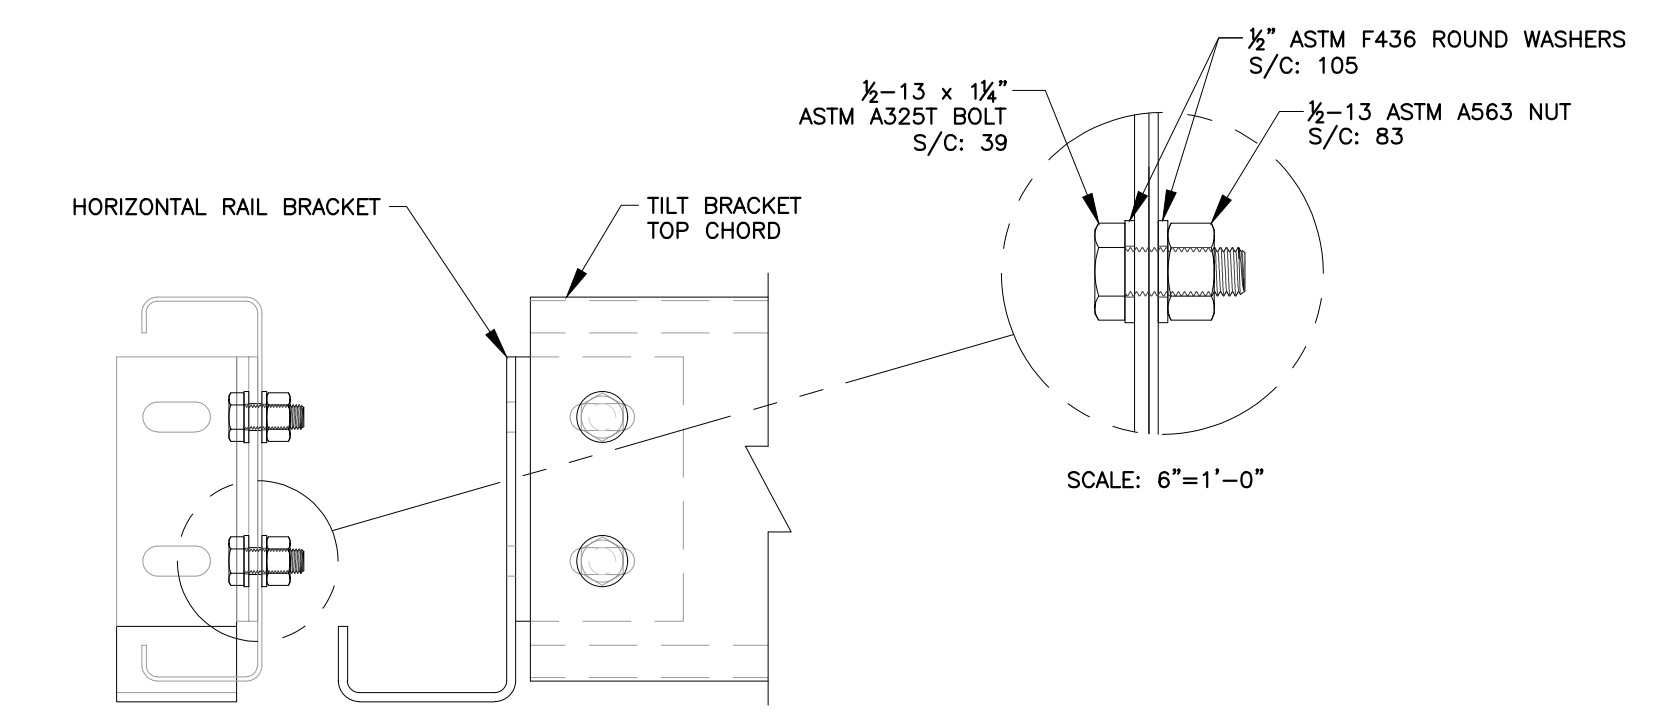

4 HORIZ. RAIL BRACKET TO TILT BRACKET CONN.
SCALE: 3" = 1'-0" (PRE-ASSEMBLED NEEDS TIGHTENED)

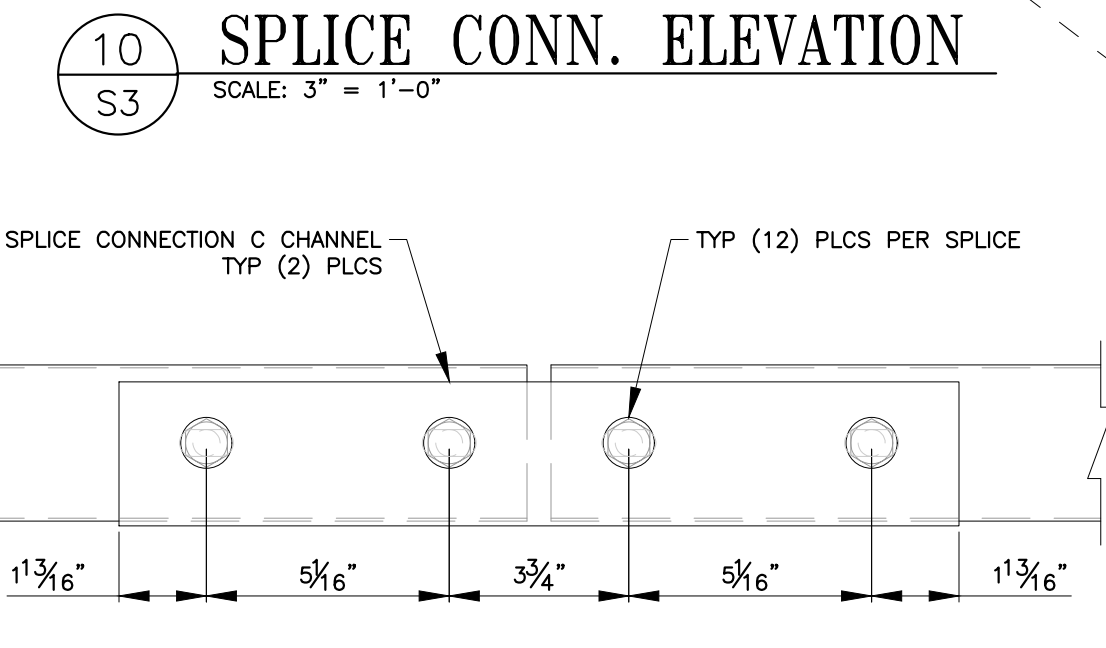

10 SPLICE CONN. ELEVATION
SCALE: 3" = 1'-0"

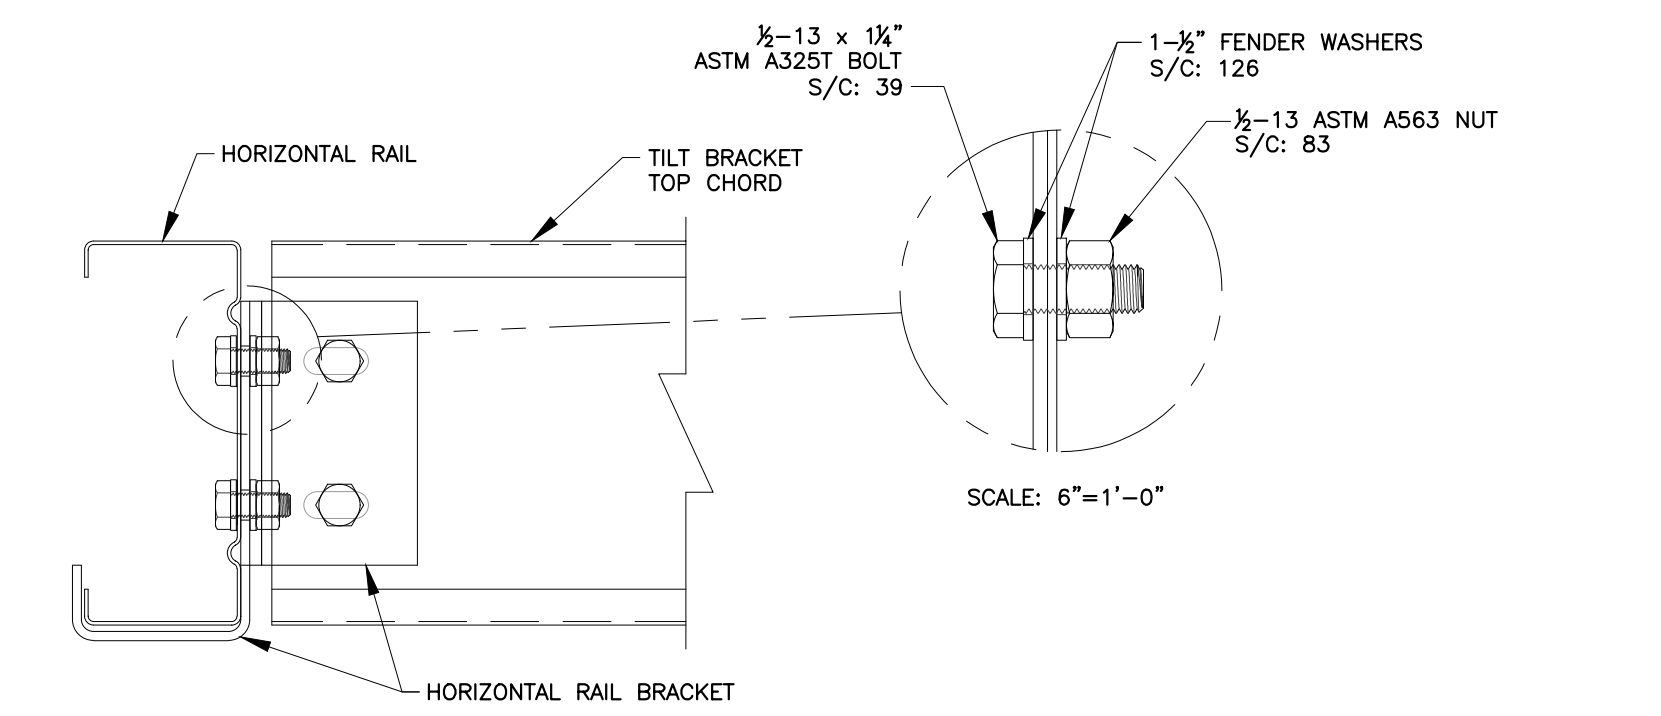

5 TILT BRACKET TO HORIZ. CONN.
SCALE: 3" = 1'-0"

11 SPLICE CONN. FLANGE
SCALE: 3" = 1'-0"
MATERIAL: ASTM A653 SS GRADE 50
FINISH: G-90 PRE-GALVANIZED

CUSTOMER: AZIMUTH ENERGY
Ameren Project
St. Louis, MO 63145


DATE: 2/1/2019
JOB #: 8883
DRAWN BY: JS
CHECK BY: DK
PAGE: S3 of S4

CONNECTIONS


SOLAR FLEX RACK
A Division of Northern States Metals
3207 Innovation Place
Youngstown, OH 44509-4023
Phone (888) 380-8138

Copying in part or as a whole is prohibited. This is only to be used by the party described in the "Title" section. This is proprietary information of Northern States Metals Company ("NSM"). © Copyright, Northern States Metals, Co. All Rights Reserved.




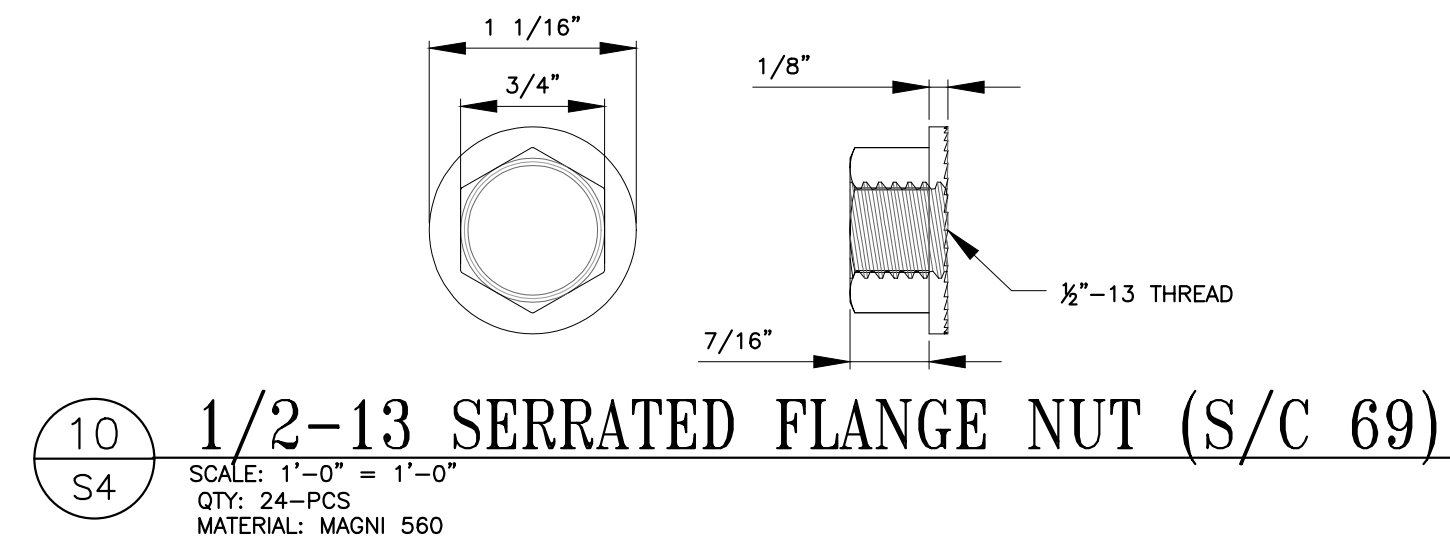


10 1/2-13 SERRATED FLANGE NUT (S/C 69)
 S4 SCALE: 1'-0" = 1'-0"
 QTY: 24-PCS
 MATERIAL: MAGNI 560

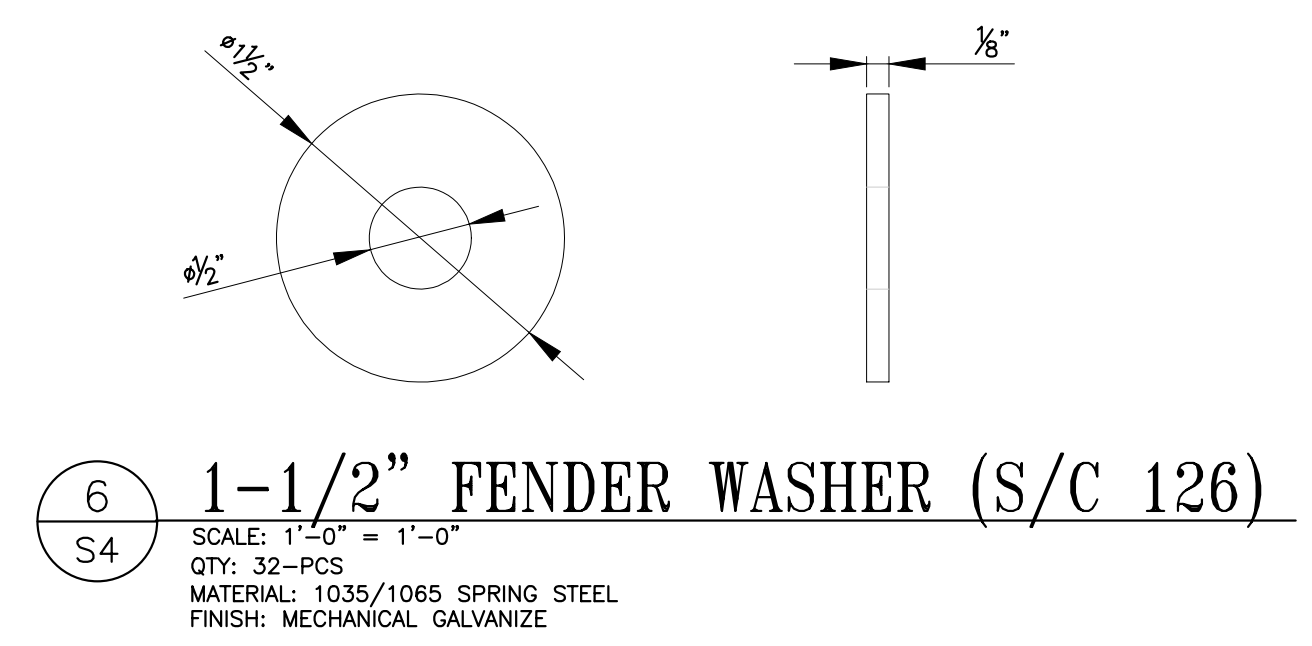


 S4 SCALE: 1'-0" = 1'-0"
 QTY: 32-PCS
 MATERIAL: 1035/1065 SPRING STEEL
 FINISH: MECHANICAL GALVANIZE

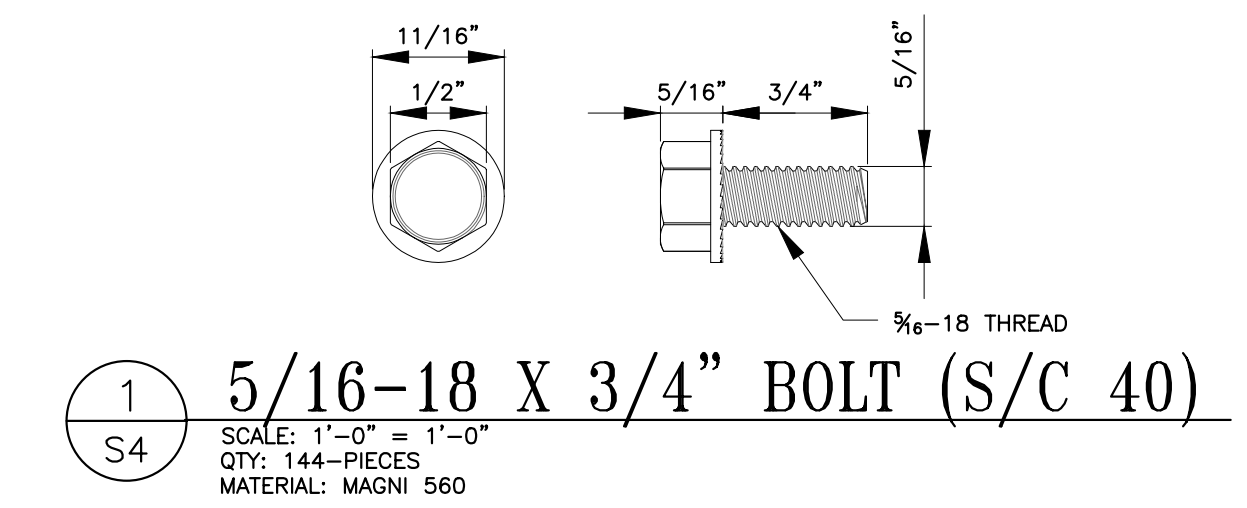


 S4 SCALE: 1'-0" = 1'-0"
 QTY: 144-PIECES
 MATERIAL: MAGNI 560

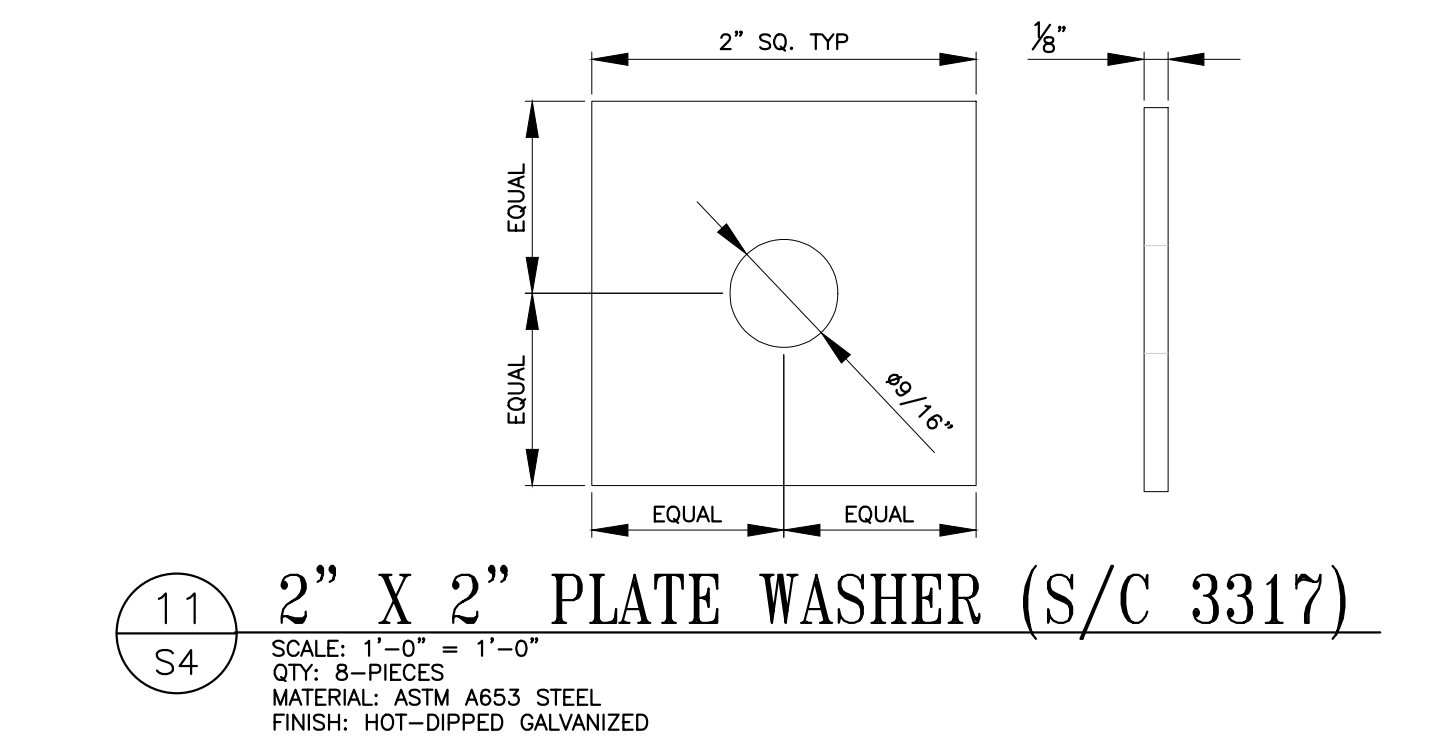


 S4 SCALE: 1'-0" = 1'-0"
 QTY: 8-PIECES
 MATERIAL: ASTM A653 STEEL
 FINISH: HOT-DIPPED GALVANIZED

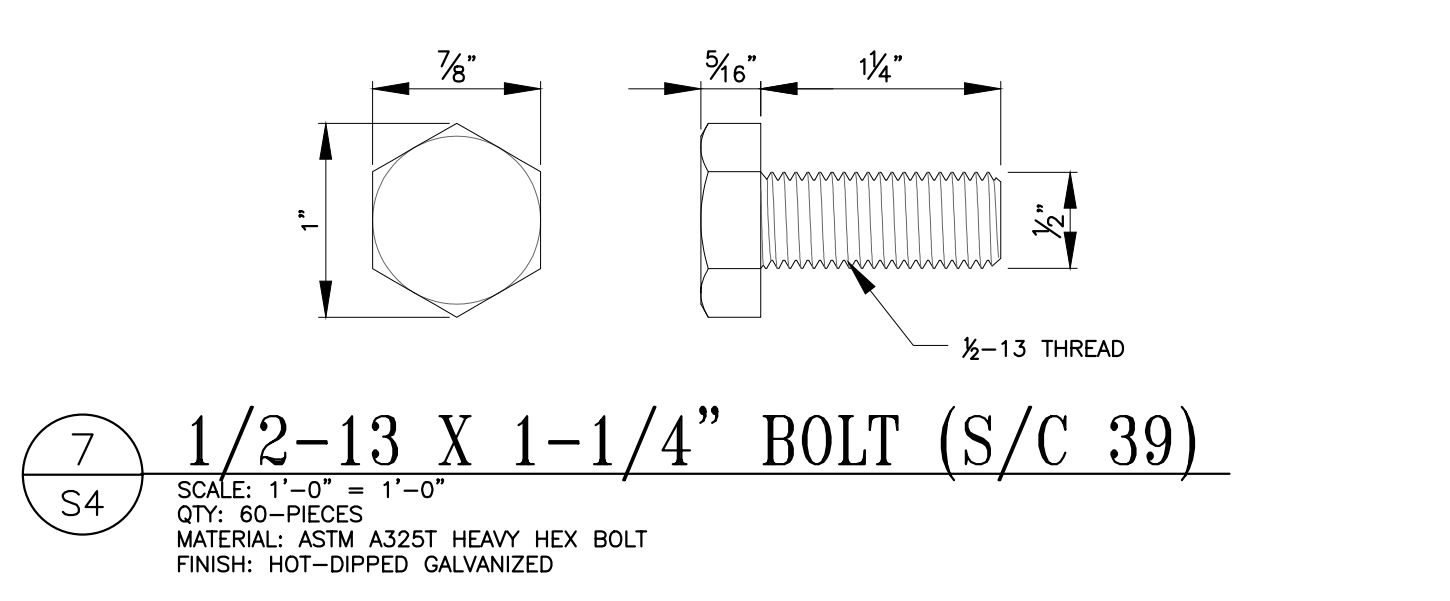


7 1/2-13 X 1-1/4\"/>
 S4 SCALE: 1'-0" = 1'-0"
 QTY: 60-PIECES
 MATERIAL: ASTM A325T HEAVY HEX BOLT
 FINISH: HOT-DIPPED GALVANIZED

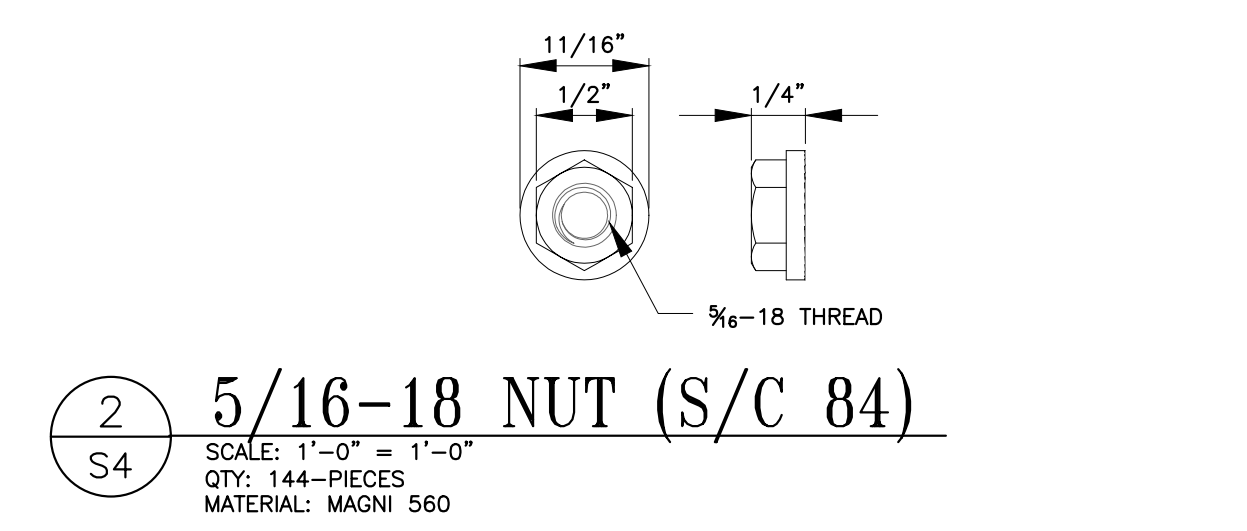


2 5/16-18 NUT (S/C 84)
 S4 SCALE: 1'-0" = 1'-0"
 QTY: 144-PIECES
 MATERIAL: MAGNI 560

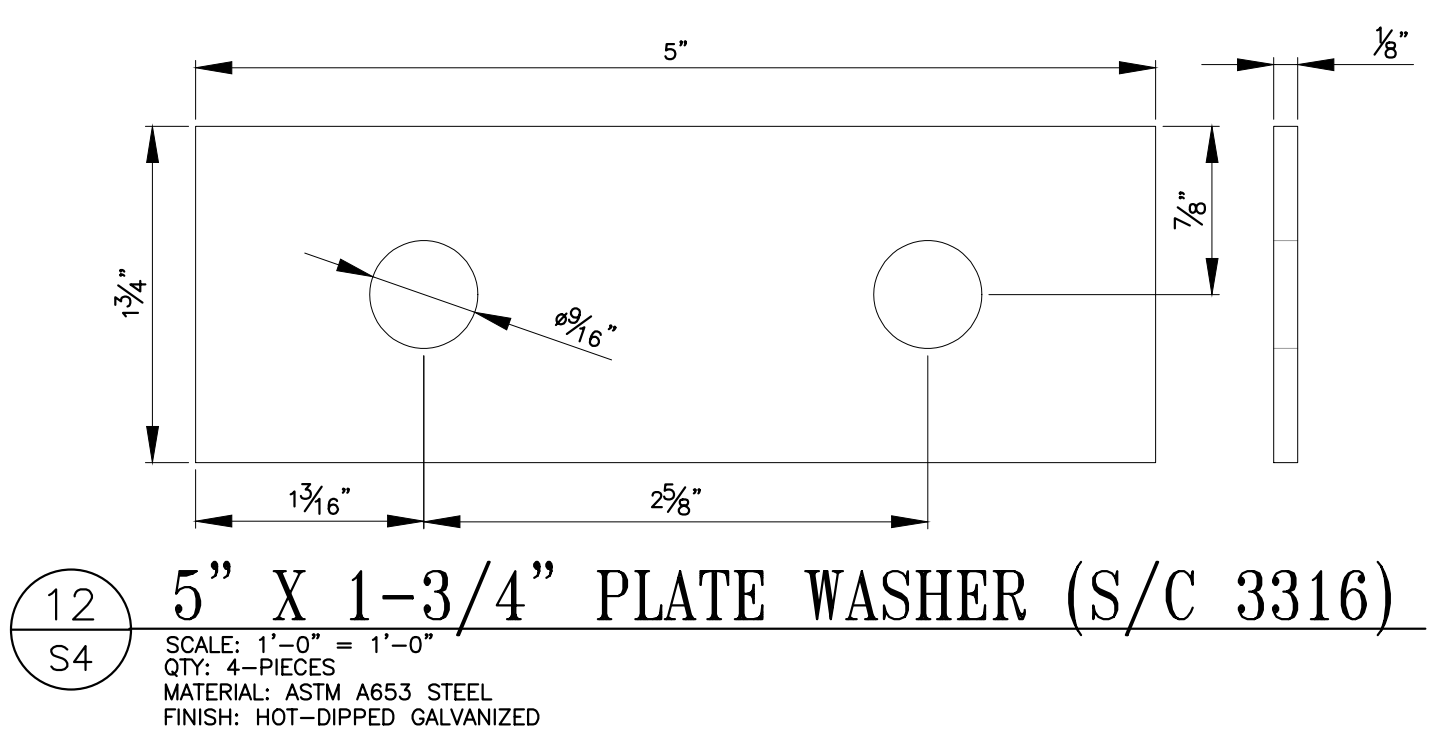


12 5\"/>
 S4 SCALE: 1'-0" = 1'-0"
 QTY: 4-PIECES
 MATERIAL: ASTM A653 STEEL
 FINISH: HOT-DIPPED GALVANIZED

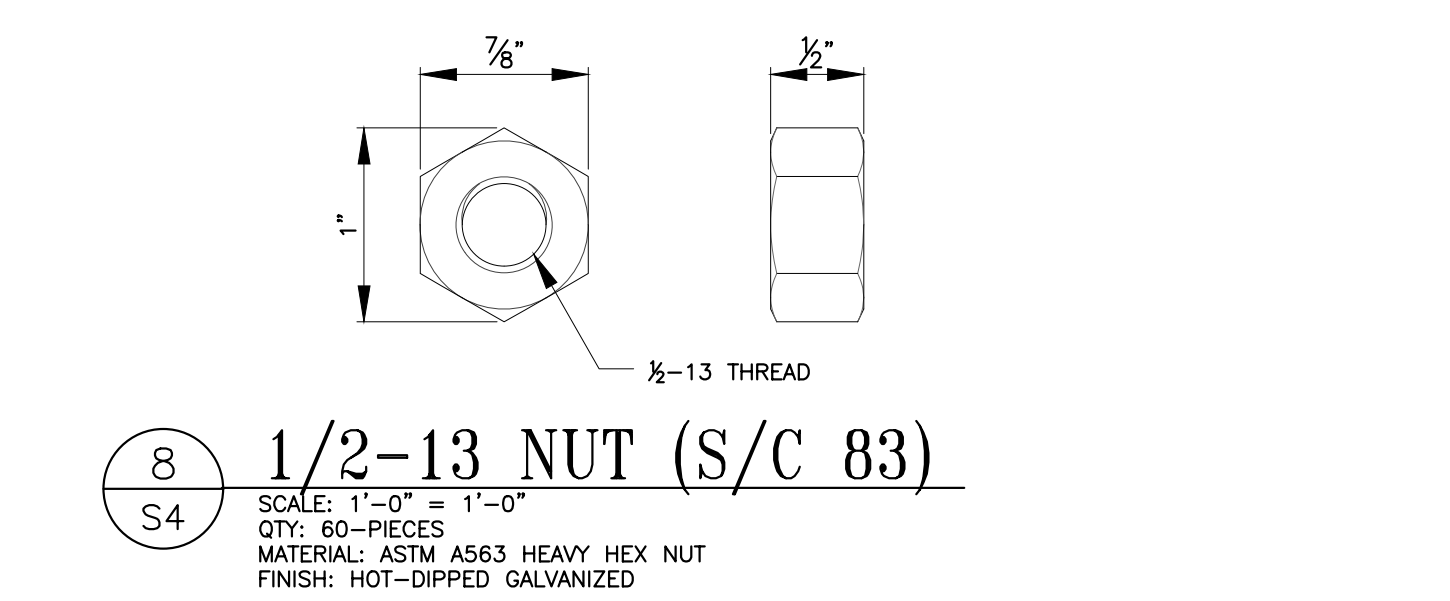


8 1/2-13 NUT (S/C 83)
 S4 SCALE: 1'-0" = 1'-0"
 QTY: 60-PIECES
 MATERIAL: ASTM A563 HEAVY HEX NUT
 FINISH: HOT-DIPPED GALVANIZED

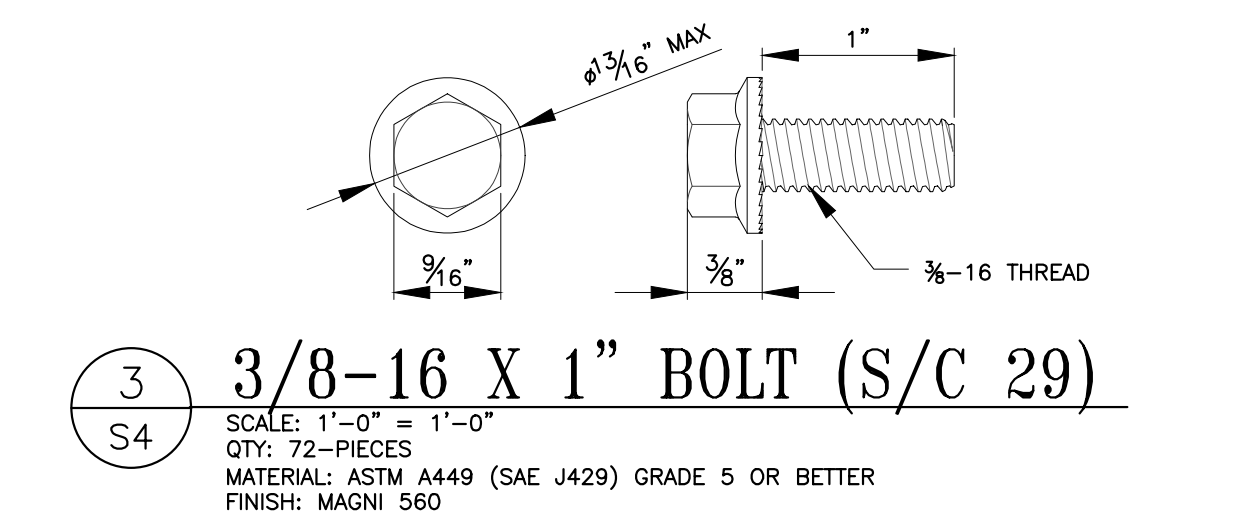


3 3/8-16 X 1\"/>
 S4 SCALE: 1'-0" = 1'-0"
 QTY: 72-PIECES
 MATERIAL: ASTM A449 (SAE J429) GRADE 5 OR BETTER
 FINISH: MAGNI 560

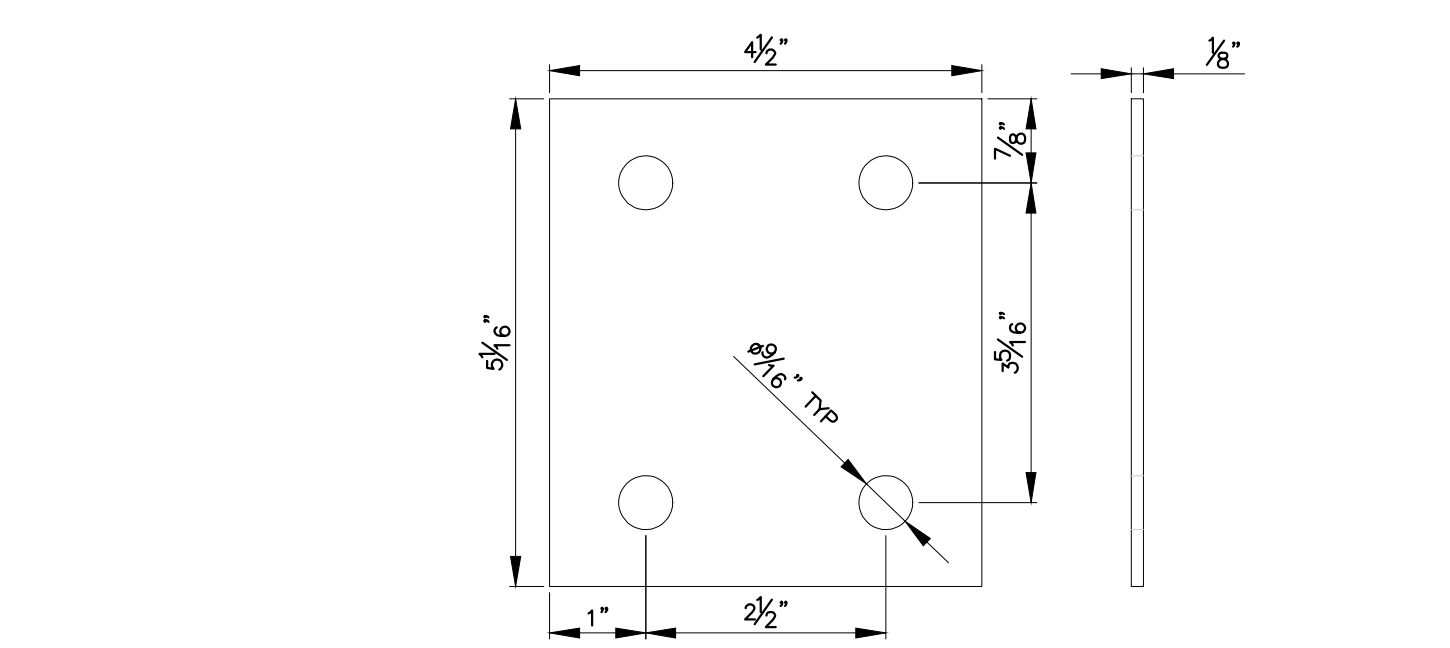


13 4-1/2\"/>
 S4 SCALE: 6\"/>

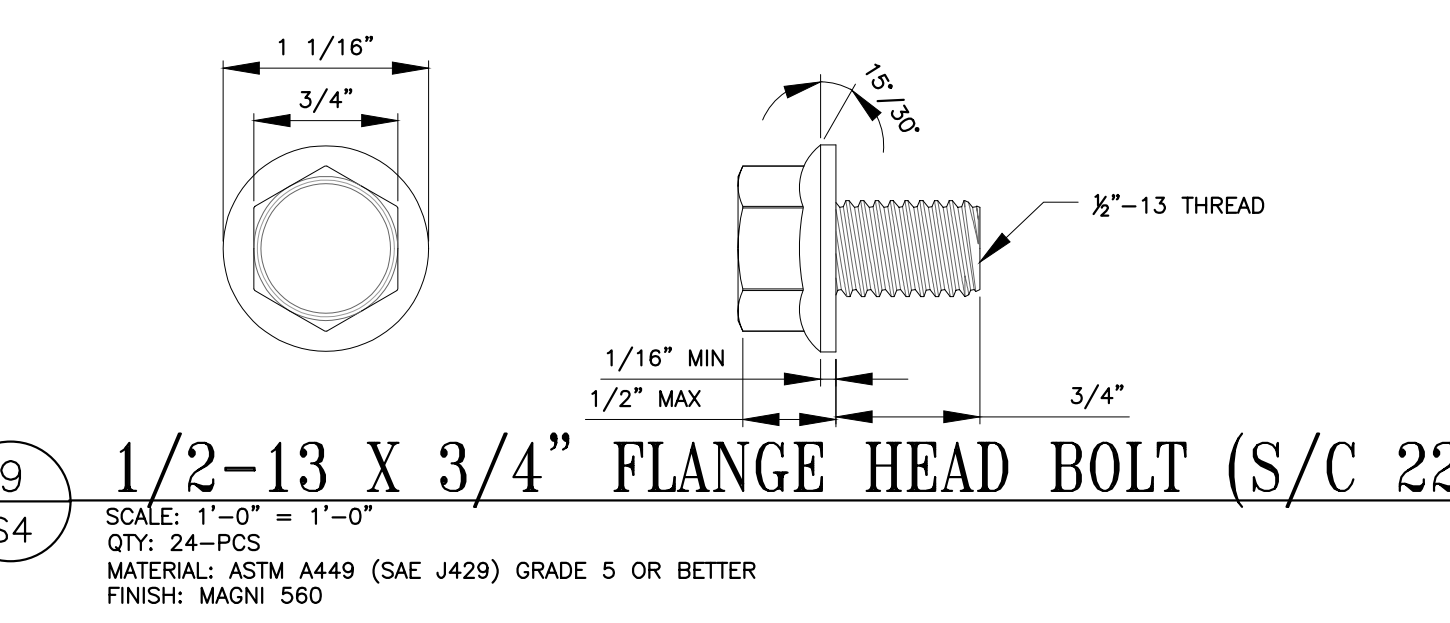

9 1/2-13 X 3/4\"/>
 S4 SCALE: 1'-0" = 1'-0"
 QTY: 24-PCS
 MATERIAL: ASTM A449 (SAE J429) GRADE 5 OR BETTER
 FINISH: MAGNI 560

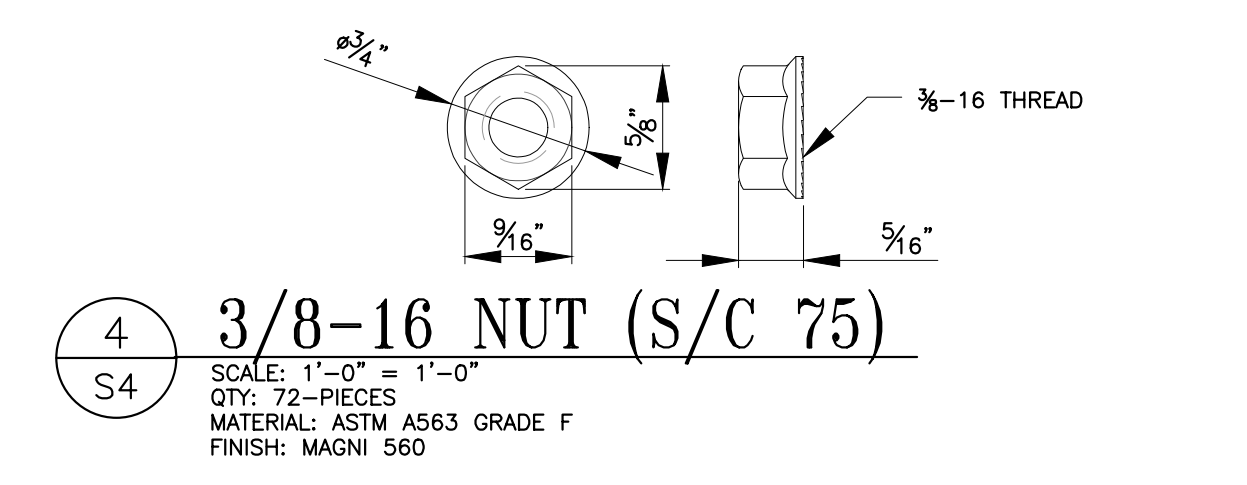

4 3/8-16 NUT (S/C 75)
 S4 SCALE: 1'-0" = 1'-0"
 QTY: 72-PIECES
 MATERIAL: ASTM A563 GRADE F
 FINISH: MAGNI 560

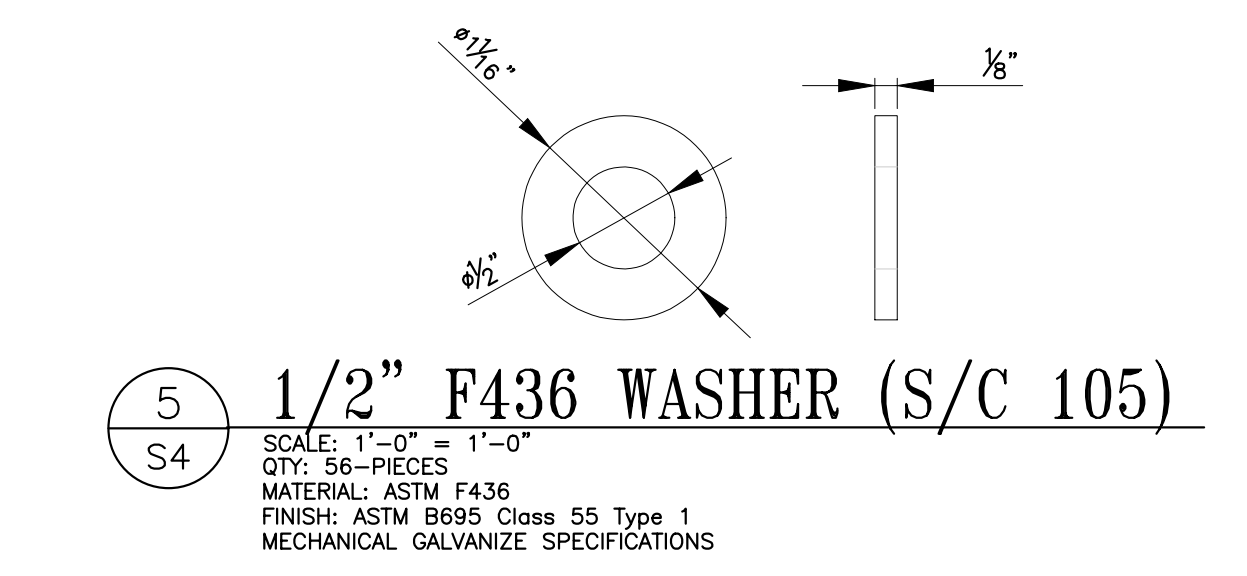

5 1/2\"/>
 S4 SCALE: 1'-0" = 1'-0"
 QTY: 56-PIECES
 MATERIAL: ASTM F436
 FINISH: ASTM B695 Class 55 Type 1
 MECHANICAL GALVANIZE SPECIFICATIONS

CUSTOMER: AZIMUTH ENERGY
 Ameren Project
 St. Louis, MO 63145
 JOB # 8883
 DATE 2/1/2019
 DRAWN BY: JS
 CHECK BY: DK
 PAGES: S4 of S4

HARDWARE
 SOLAR FLEX RACK
 A Division of Northern States Metals
 3207 Innovation Place
 Youngstown, OH 44509-4023
 Phone (888) 380-8138

Copying in part or as a whole is prohibited. This is only to be used by the party described in the "Title" section. This is proprietary information of Northern States Metals Company ("NSM"). © Copyright, Northern States Metals, Co. All Rights Reserved.

REV	DESCRIPTION	DATE

